


Knox Twp.

Section 5
R-5

Section 3
R-15

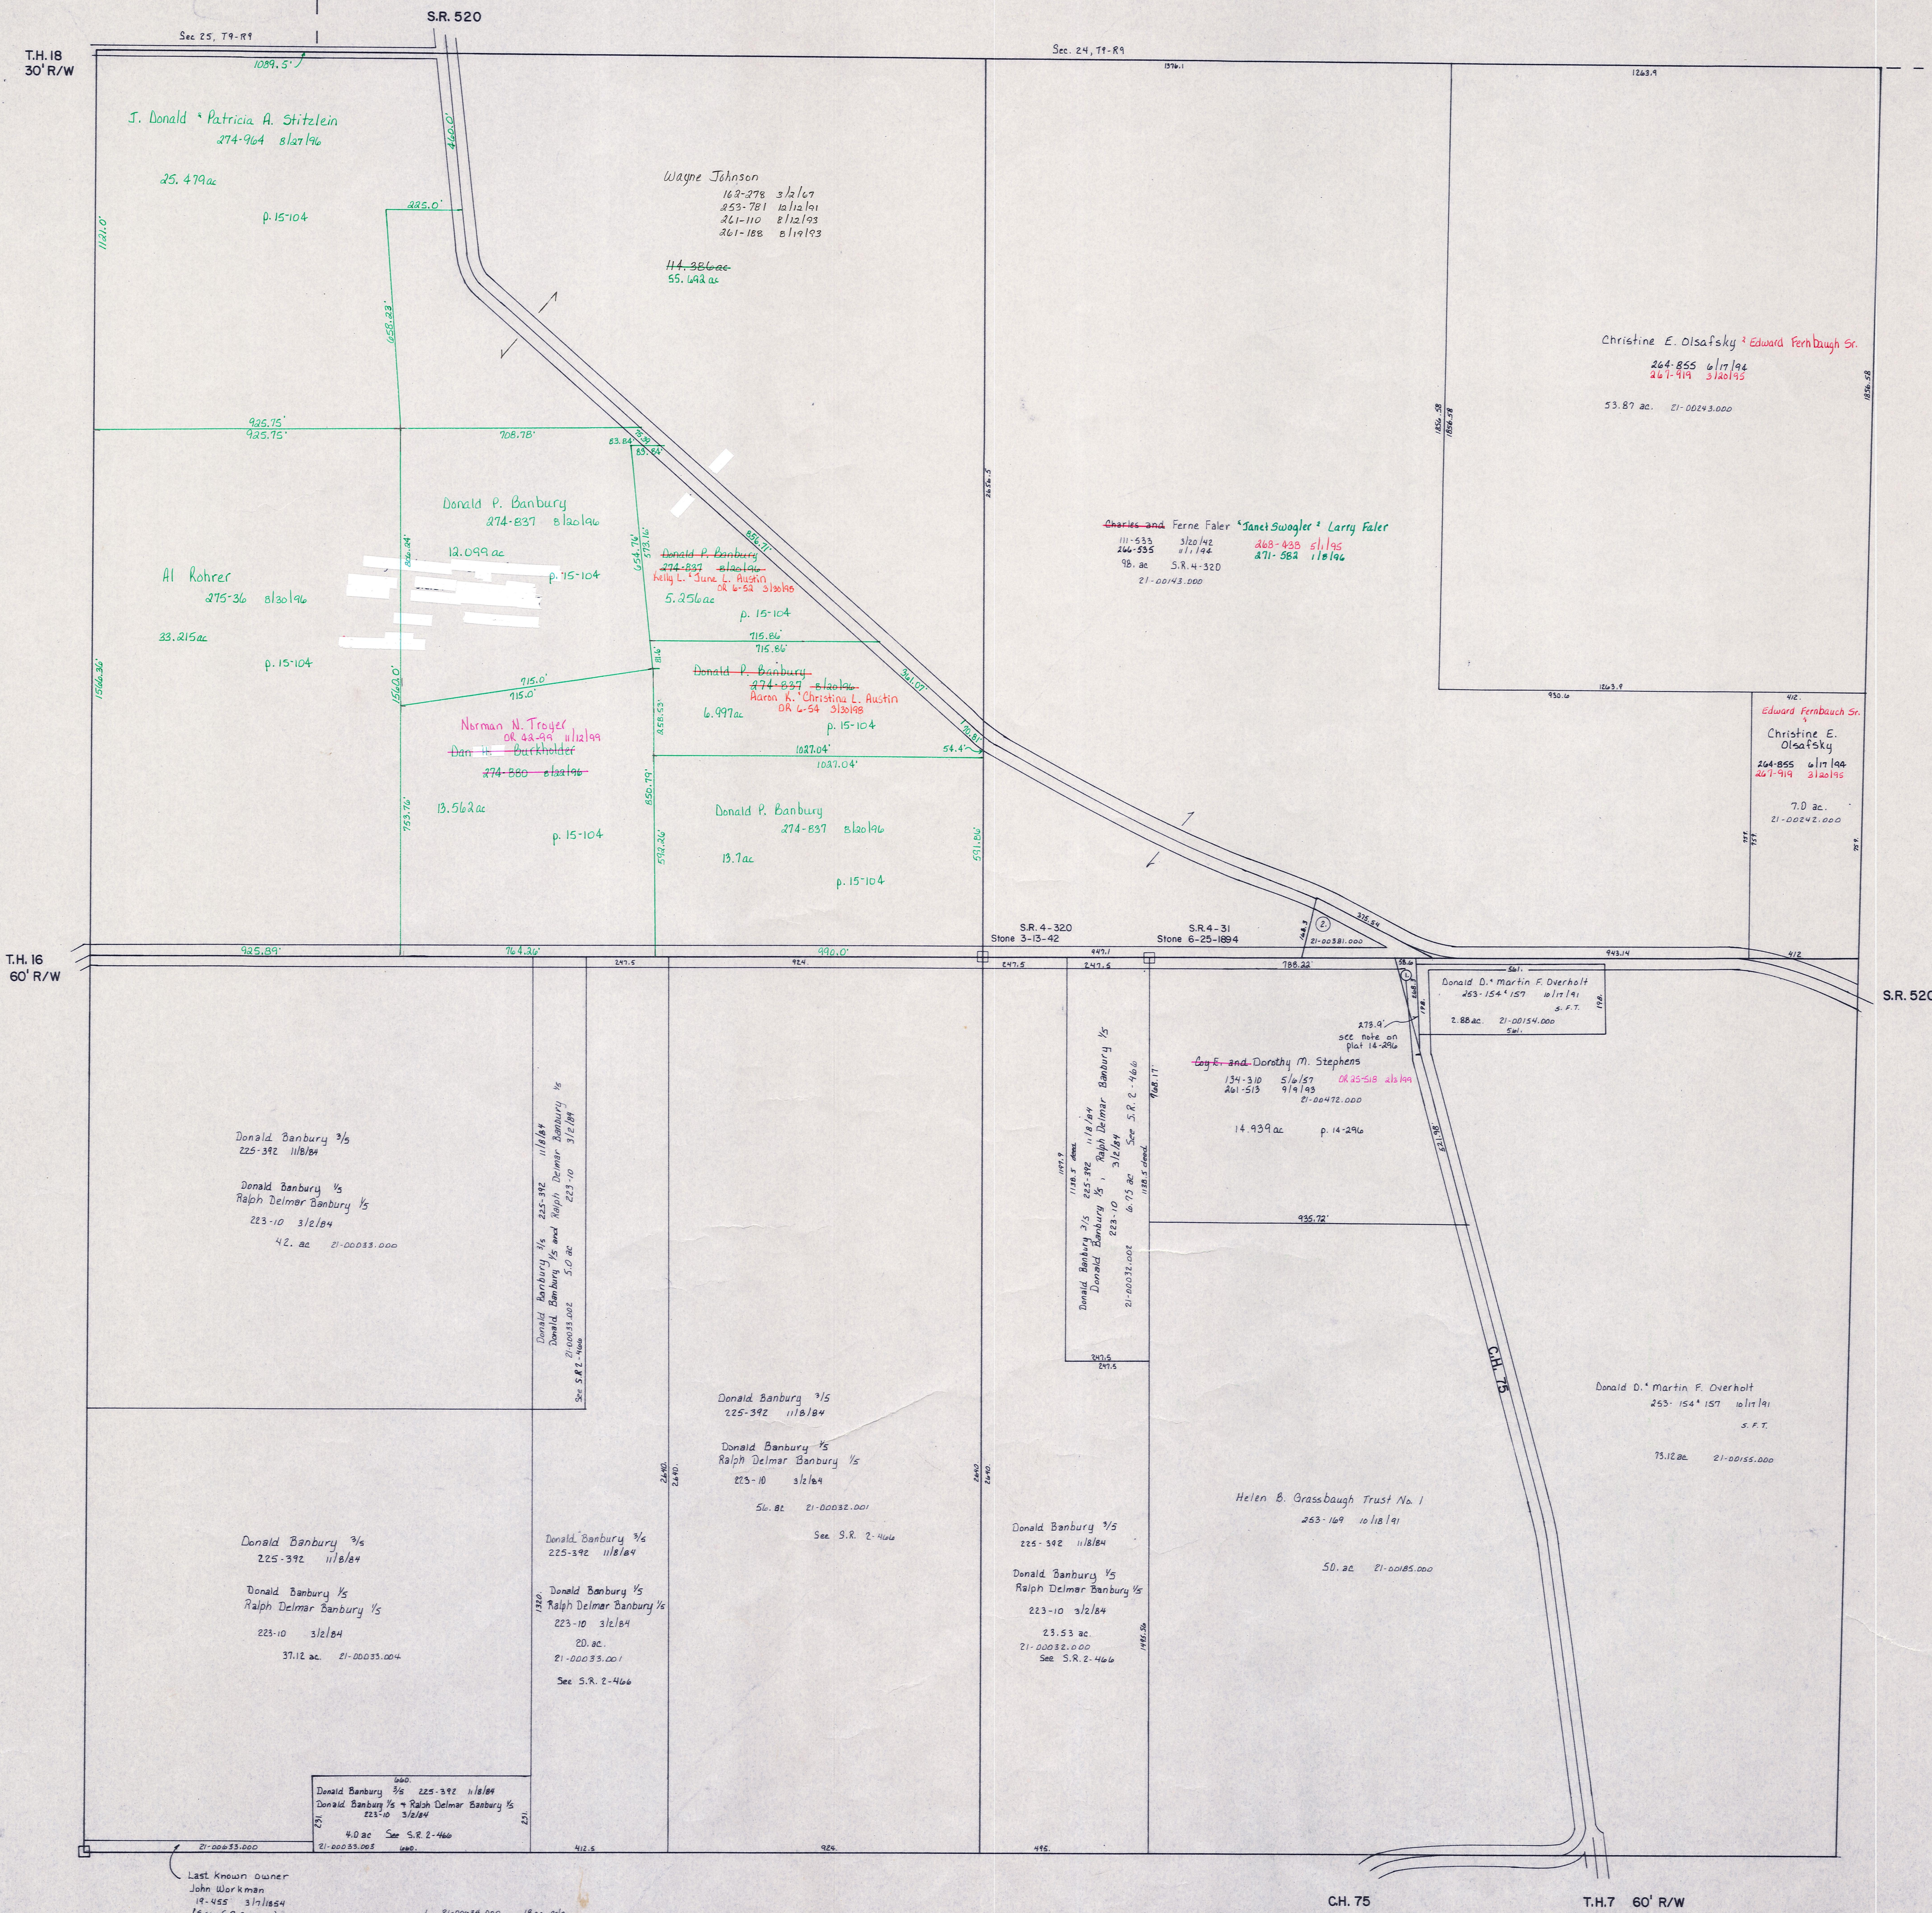

Last Known owner
John Workman
19-455 3/7/1854
(See S.R. 2-466)

- 21-00054.000 18 ac. o/c.
Donald D. Martin F. Overholt
253-154-157 10/11/191 s.f.t.
- 21-00058.000 25 ac. s.f.t.
Lucy Parsons 107-556 1/7/38

Section 7
R-9

T-8, R-9, Sec. 4
RICHLAND TWP.
SCALE 1" = 200'

LET IT BE KNOWN, THIS MAP HAS BEEN PREPARED AS A REFERENCE GUIDE TO PROPERTY OWNERSHIP. WE BELIEVE THIS INFORMATION TO BE CORRECT AND CURRENT, HOWEVER, IT IS NOT INTENDED FOR ANY LEGAL USE, WHETHER IT BE IN SALES, TRANSFERS, TRADES, LEASES OF ANY TYPE, ETC., AND DO NOT ACCEPT RESPONSIBILITY FOR ERRORS OF ANY NATURE OR OMISSIONS CONTAINED HEREIN.

R-10