

Section 3
R-15

Section 7
R-9


Section 9
R-19

T.H. 14
60' R/W
OLD TH. 404

T.H. 7
60' R/W

Section 13
R-13

T.H. 14
60' R/W
OLD TH. 404

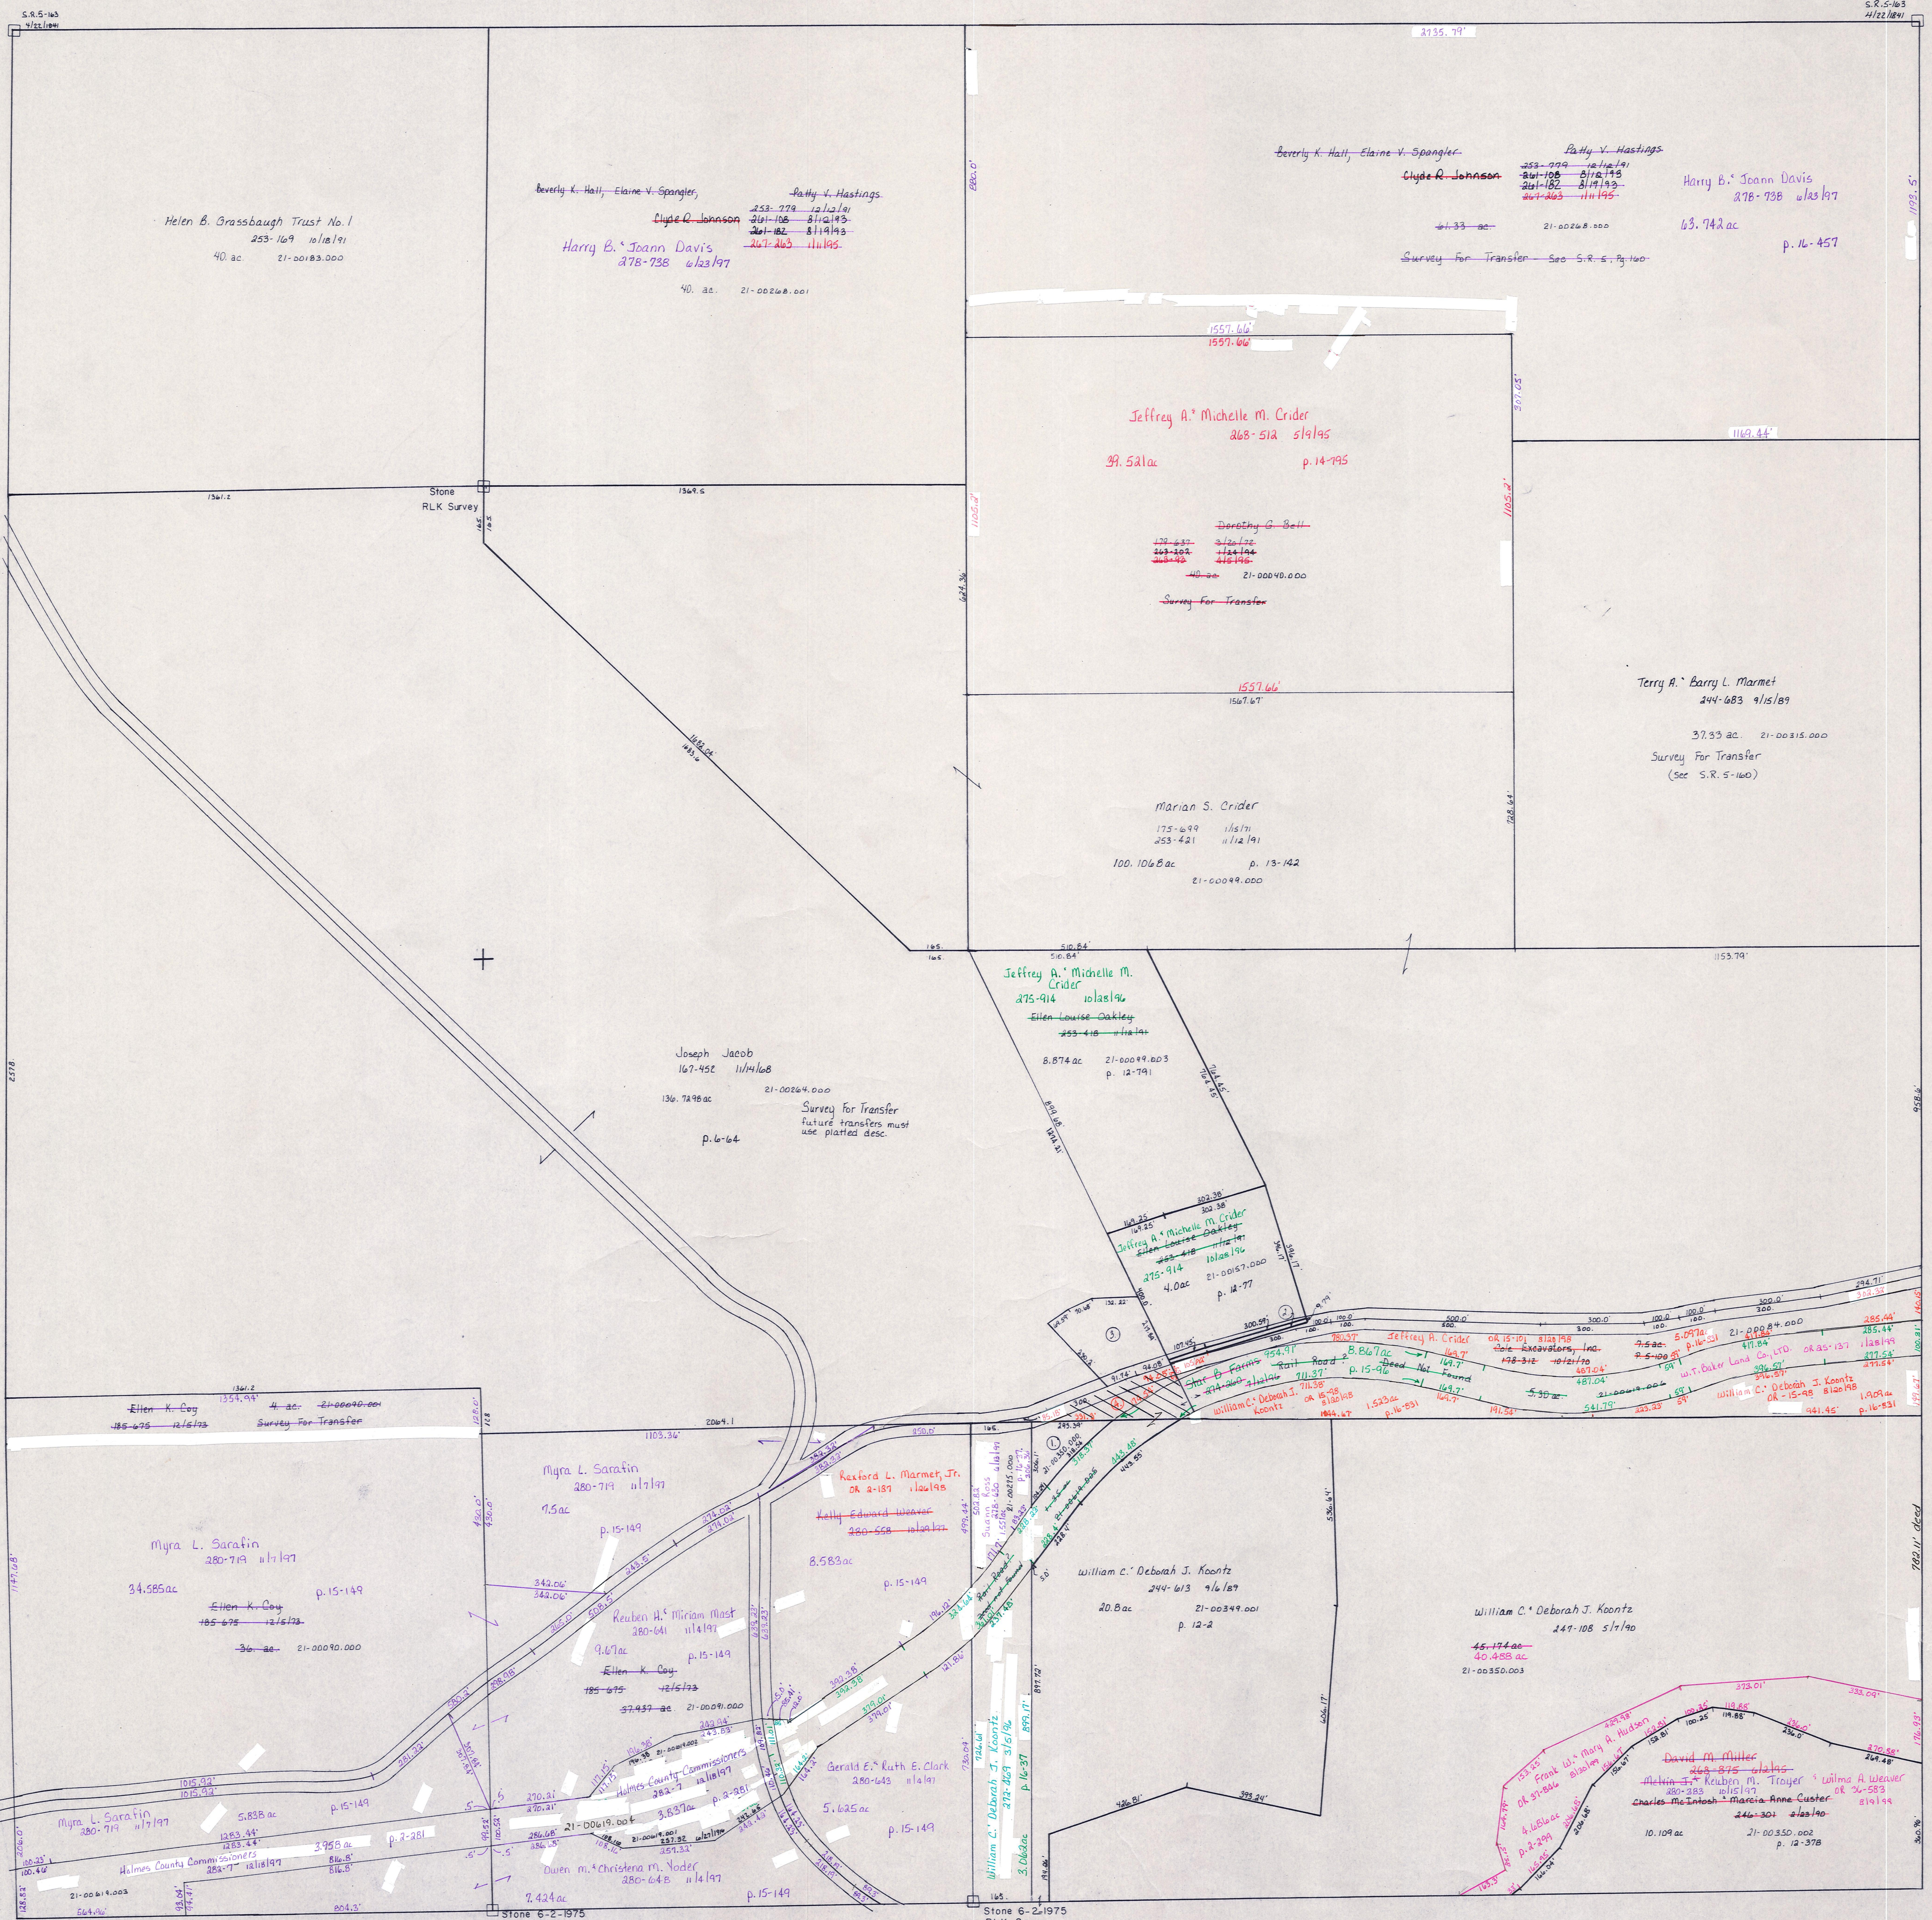

- ① Susan Ross 298-430 4/12/19
- ② Elmer A. Eileen K. Schlauch 263-394 2/1/19
917 ac p. 12-419
- ③ Ellen Louise Oakley 263-418 11/12/19 .0914 ac p. 12-791
21-00011.002 Jeffrey A. Michelle M. Crider 275-914 11/12/19
- ④ Richard L. Norma S. Cooper 256-659 6/11 8/10/19
1.2702 ac p. 14-12
- ⑤ Jeffrey A. Crider ok 15-101 2/2/19 .617 ac p. 16-831

T-8, R-9, Sec. 8
RICHLAND TWP
SCALE 1" = 200'

LET IT BE KNOWN, THIS MAP HAS BEEN PREPARED AS A REFERENCE GUIDE TO PROPERTY OWNERSHIP. WE BELIEVE THIS INFORMATION TO BE CORRECT AND CURRENT, HOWEVER, IT IS NOT INTENDED FOR ANY LEGAL USE, WHETHER IT BE IN SALES, TRANSFERS, TRADES, LEASES OF ANY TYPE, ETC., AND DO NOT ACCEPT RESPONSIBILITY FOR ERRORS OF ANY NATURE OR OMISSIONS CONTAINED HEREIN.

R-14