


Section 14  
R-8

T.H. 4 60' R/W  
OLD T.H. 404

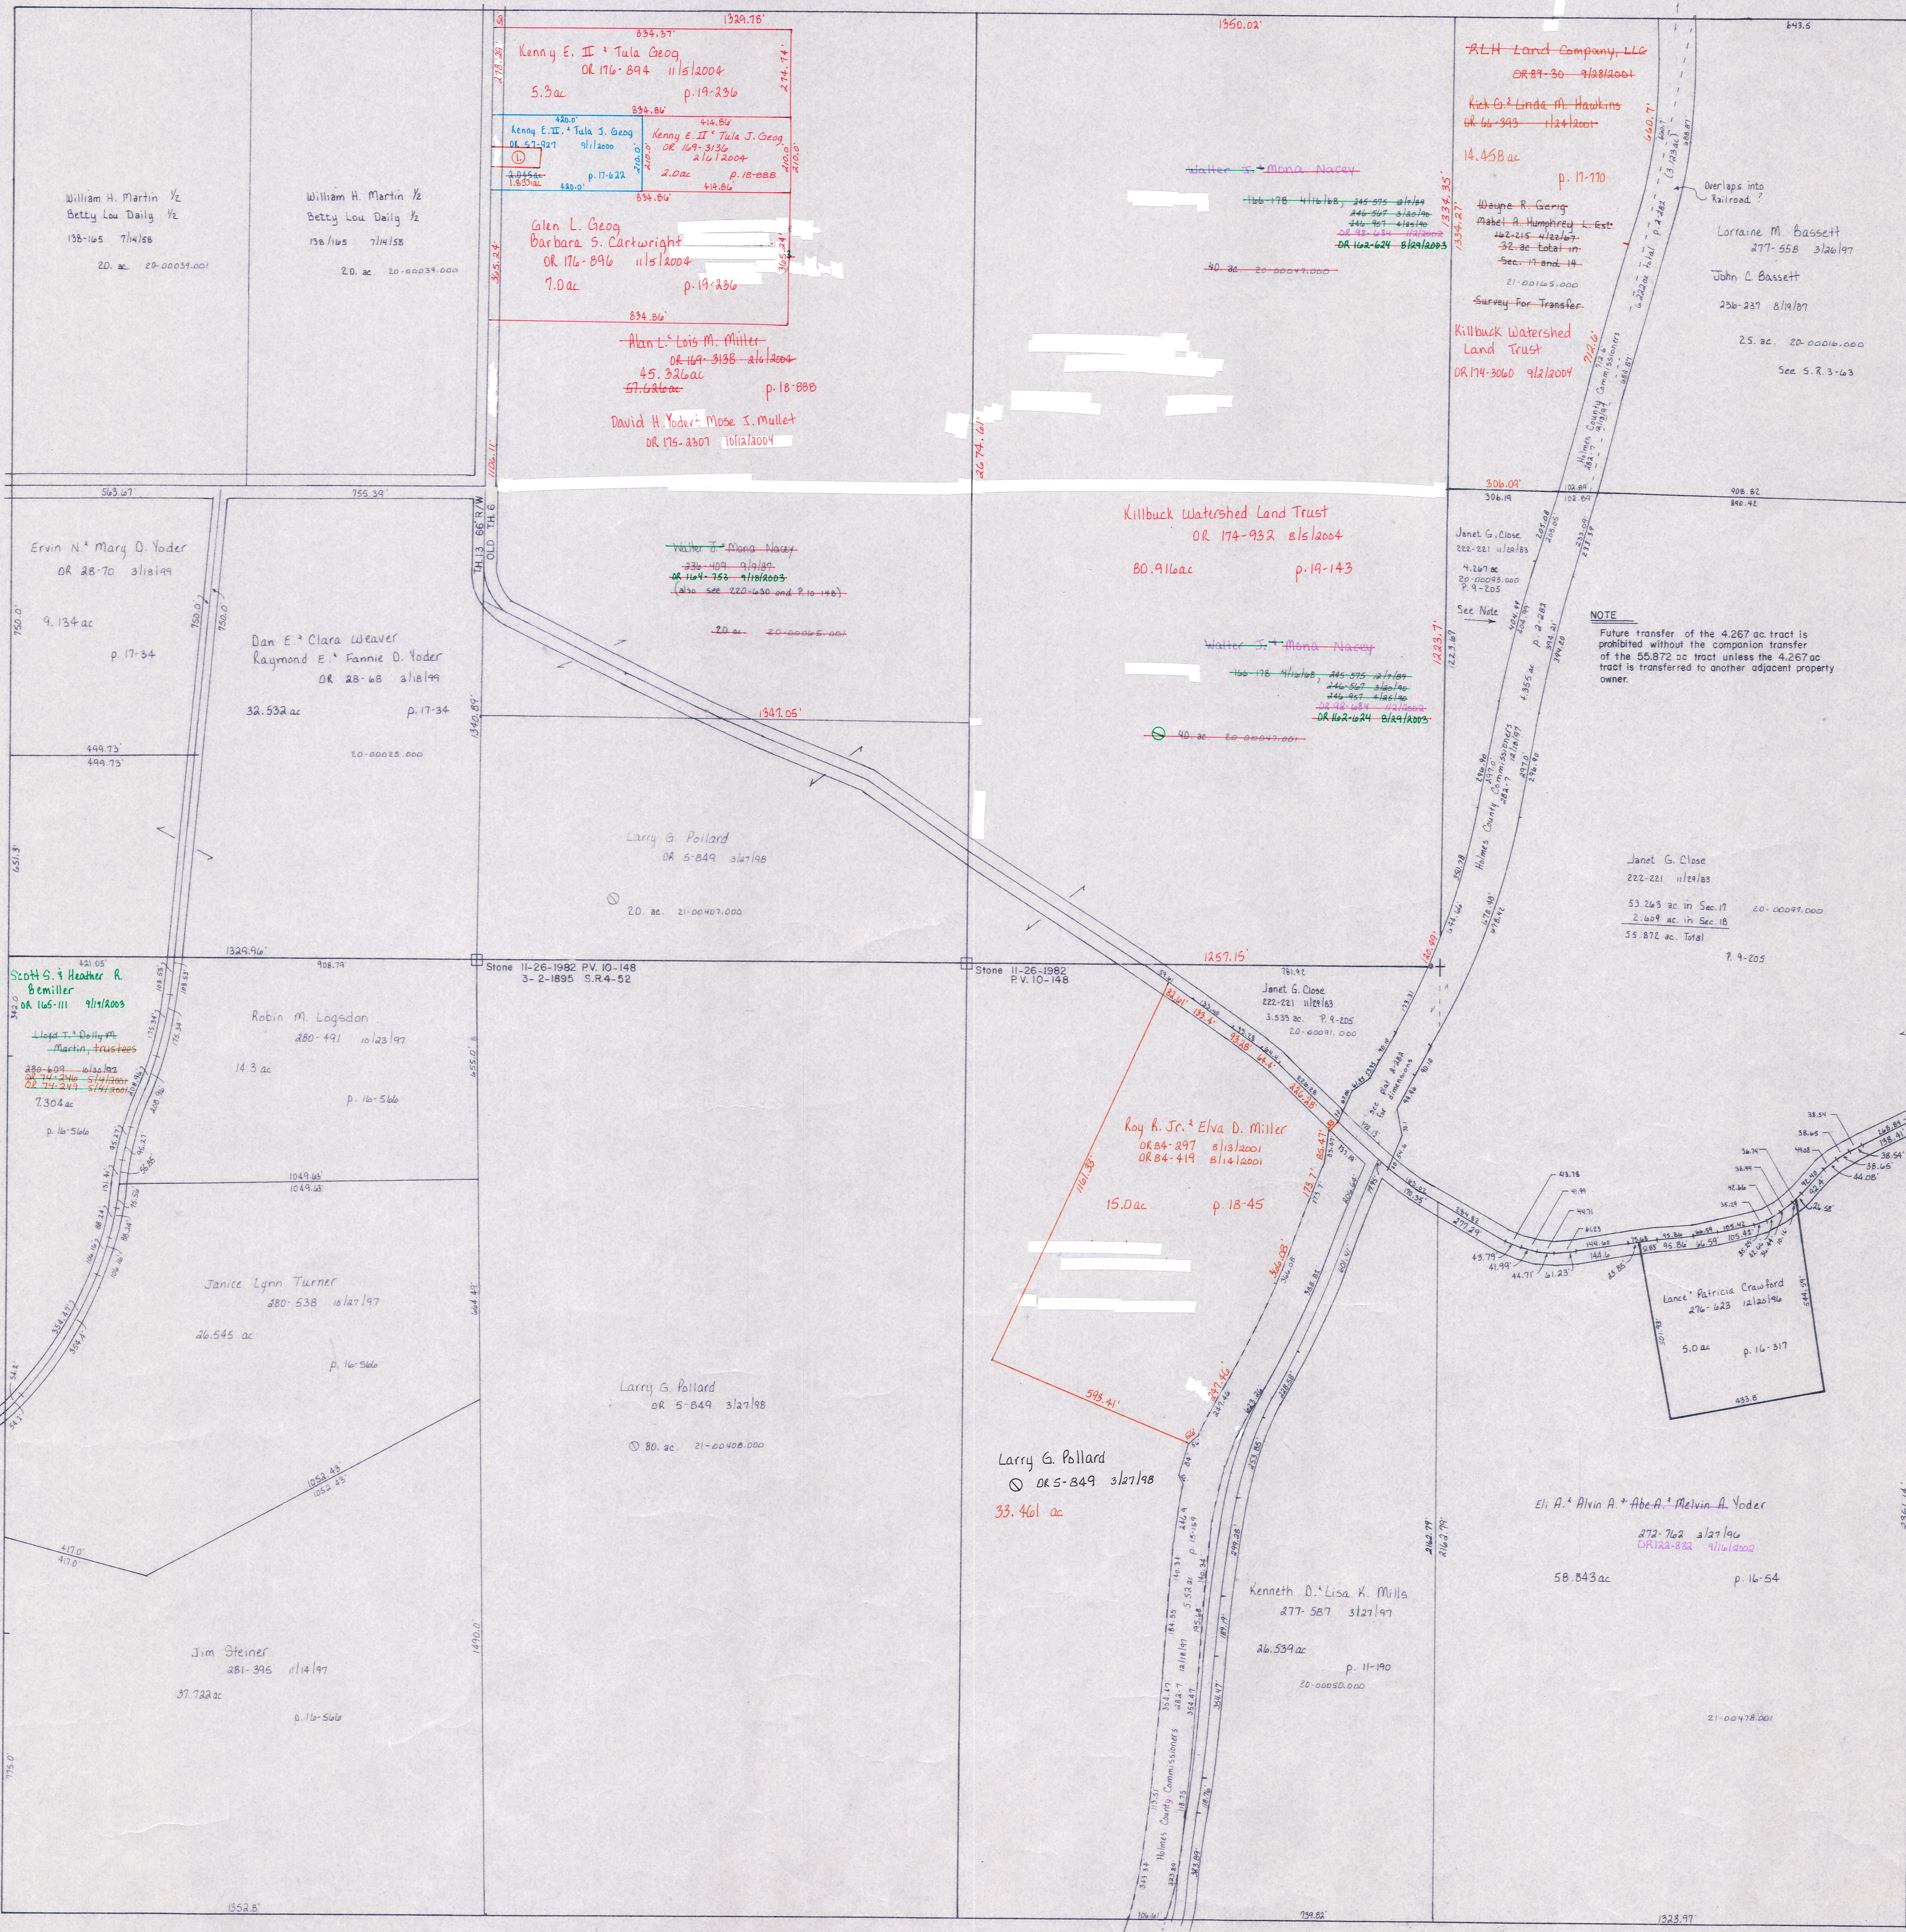

T.H. 33 33' R/W  
OLD T.H. 404

Section 16  
R-2

T.H. 11 40' R/W  
OLD T.H. 10

Stone 4-19-1887  
S.R. 3-63

T.H. 13 66' R/W  
OLD T.H. 6

Section 18  
R-12

T.H. 5 No Record  
OLD T.H. 352

Section 24  
R-6

T-8, R-9, Sec. 17  
RICHLAND TWP.  
SCALE 1" = 200'

LET IT BE KNOWN, THIS MAP HAS BEEN PREPARED AS A REFERENCE GUIDE TO PROPERTY OWNERSHIP AND CURRENT, HOWEVER, IT IS NOT INTENDED FOR ANY LEGAL USE, WHETHER IT BE IN SALES, TRANSFERS, TRADES, LEASES OF ANY TYPE, ETC., AND DO NOT ACCEPT RESPONSIBILITY FOR ERRORS OF ANY NATURE OR OMISSIONS CONTAINED HEREIN.

R-7