


Section 4  
R-10

C.H. 75 60'R/W

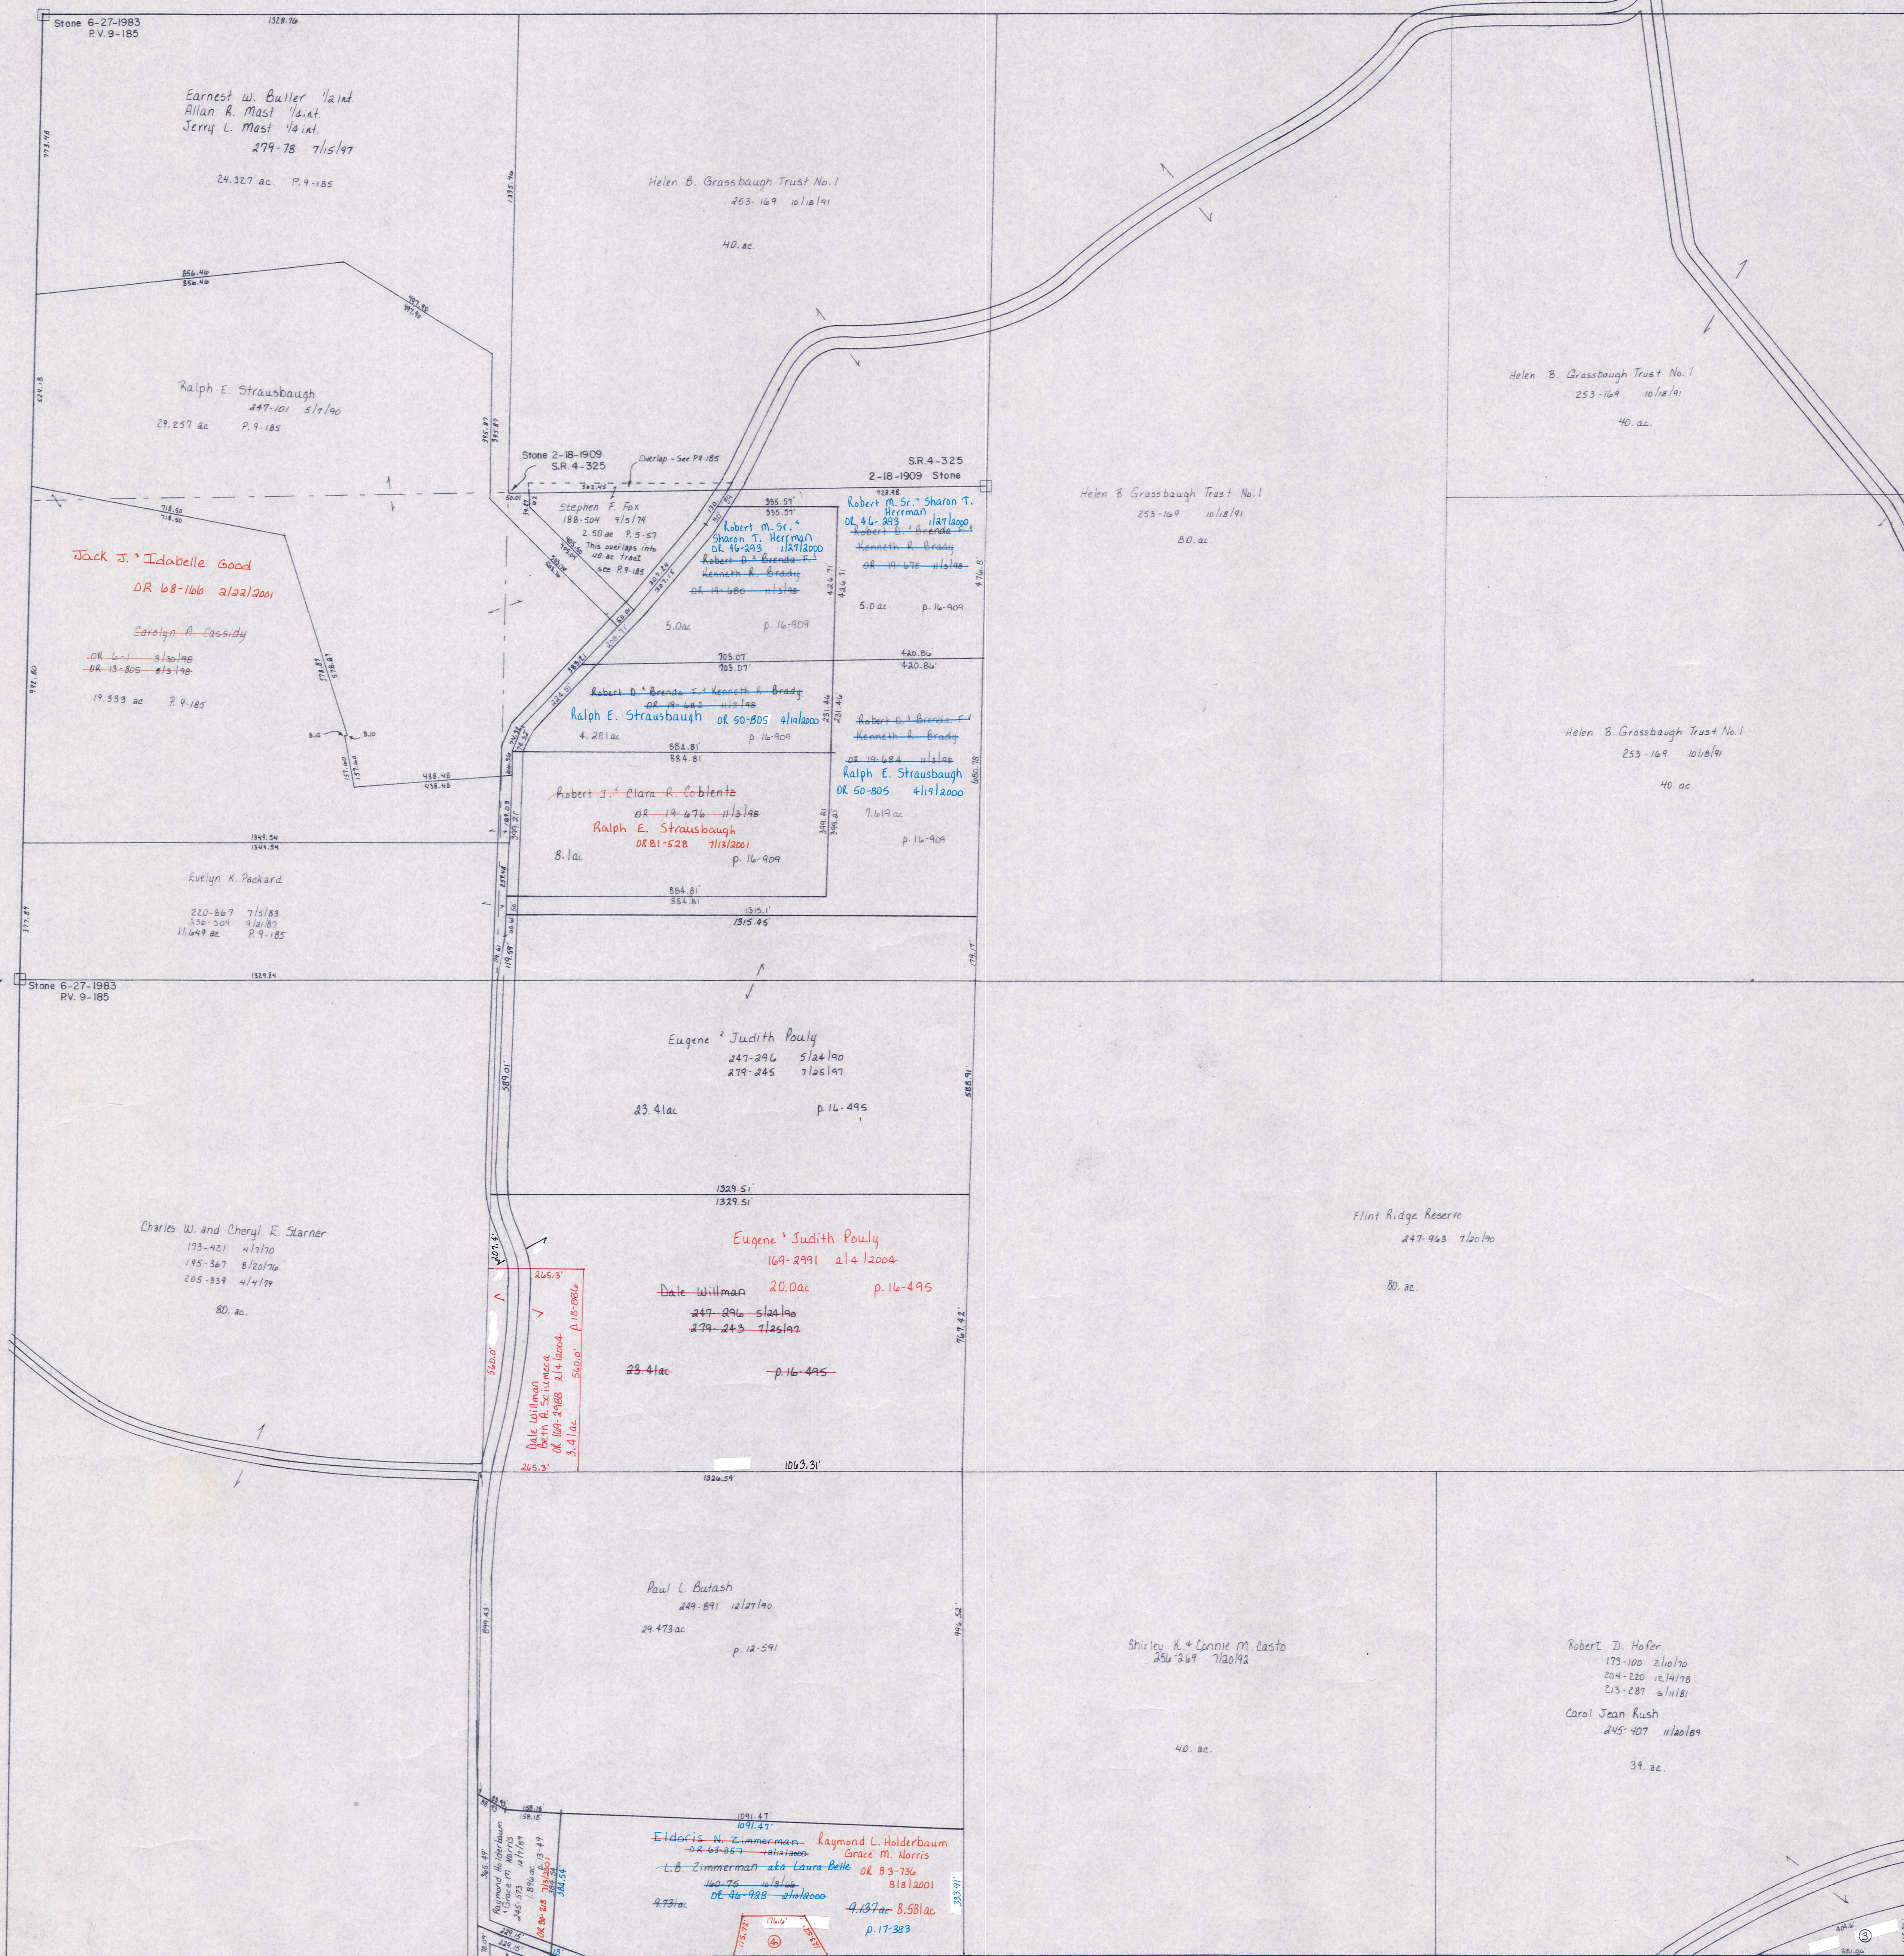

Section 8  
R-14

Section 6  
R-4

Raymond L. Holderbaum & Grace M. Harris 261-16 2/12/90 p. 12-39  
 Katherine Russell Bradford 246-500 11/17/90 p. 12-44


C.H. 75 60' R/W  
 T.H. 32 60' R/W  
 OLD T.H. 432

Section 14  
R-8

T.H. 14 60' R/W  
 OLD T.H. 404

T-8, R-9, Sec. 7  
 RICHLAND TWP.  
 SCALE 1"=200'

LET IT BE KNOWN, THIS MAP HAS BEEN PREPARED AS A REFERENCE GUIDE TO PROPERTY OWNERSHIP. WE BELIEVE THIS INFORMATION TO BE CORRECT AND CURRENT, HOWEVER, IT IS NOT INTENDED FOR ANY LEGAL USE, WHETHER IT BE IN SALES, TRANSFERS, TRADES, LEASES OF ANY TYPE, ETC., AND DO NOT ACCEPT RESPONSIBILITY FOR ERRORS OF ANY NATURE OR OMISSIONS CONTAINED HEREIN.

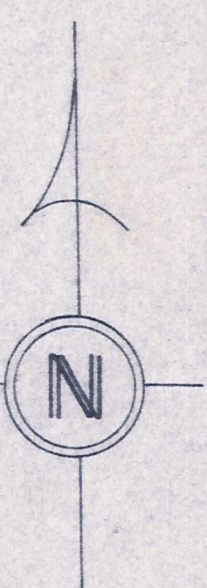

R-9