


Section 3
R-15

Section 7
R-9

Section 9
R-19

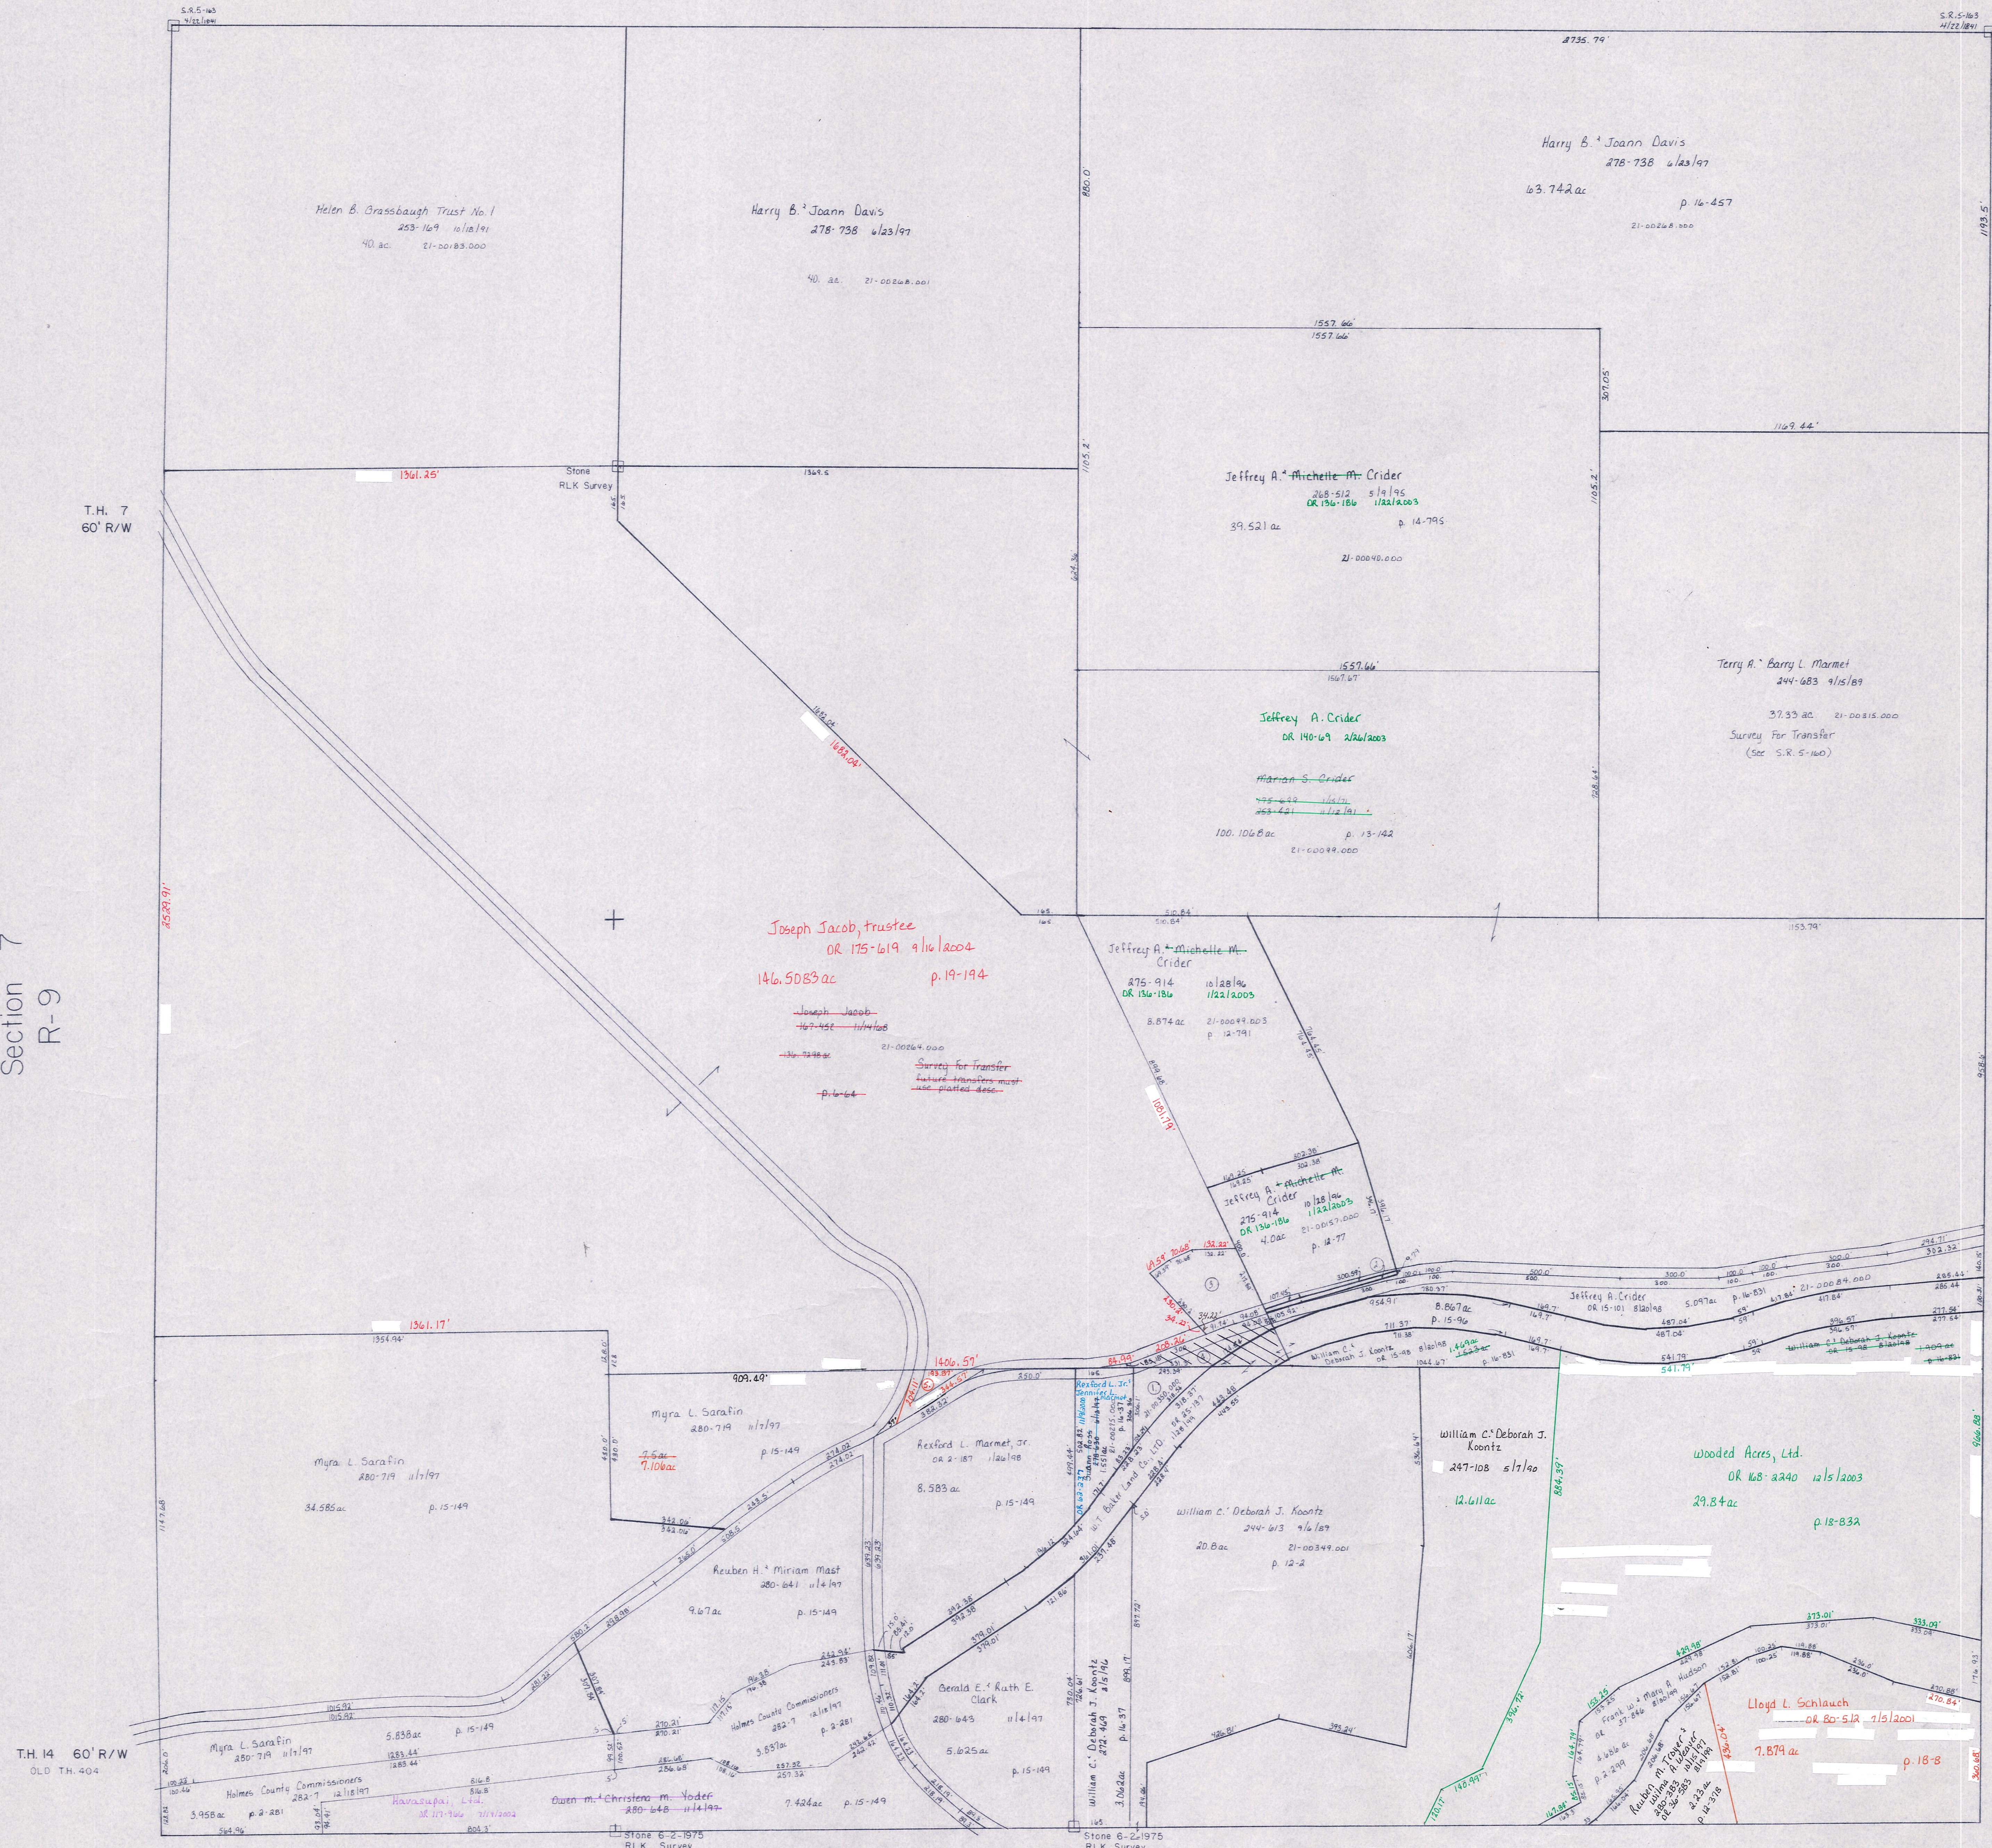


- 1. Rexford L. Marmel, Jr. OR 103-237 11/14/98
- 2. Jeffrey A. Michelle M. Crider 268-512 5/19/95
- 3. William C. Deborah J. Koontz 244-613 9/6/87
- 4. Jeffrey A. Crider OR 15-101 8/26/84

T.H. 7
60' R/W

Section 13
R-13

T-8, R-9, Sec. 8
RICHLAND TWP
SCALE 1" = 200'

LET IT BE KNOWN THIS MAP HAS BEEN PREPARED AS A REFERENCE GUIDE TO PROPERTY OWNERSHIP AND CURRENT INFORMATION TO BE CORRECT AND CURRENT, HOWEVER, IT IS NOT INTENDED FOR ANY LEGAL USE, WHETHER IT BE IN SALES, TRANSFERS, TRADES, LEASES OF ANY TYPE, ETC., AND DO NOT ACCEPT RESPONSIBILITY FOR ERRORS OF ANY NATURE OR OMISSIONS CONTAINED HEREIN.

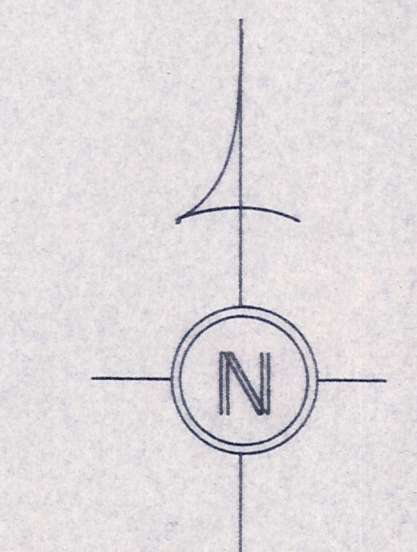

R-14