


Monroe Twp.

T.H. 36 60' R/W  
OLD T.H. 283

T.H. 253 40' R/W  
OLD T.H. 288

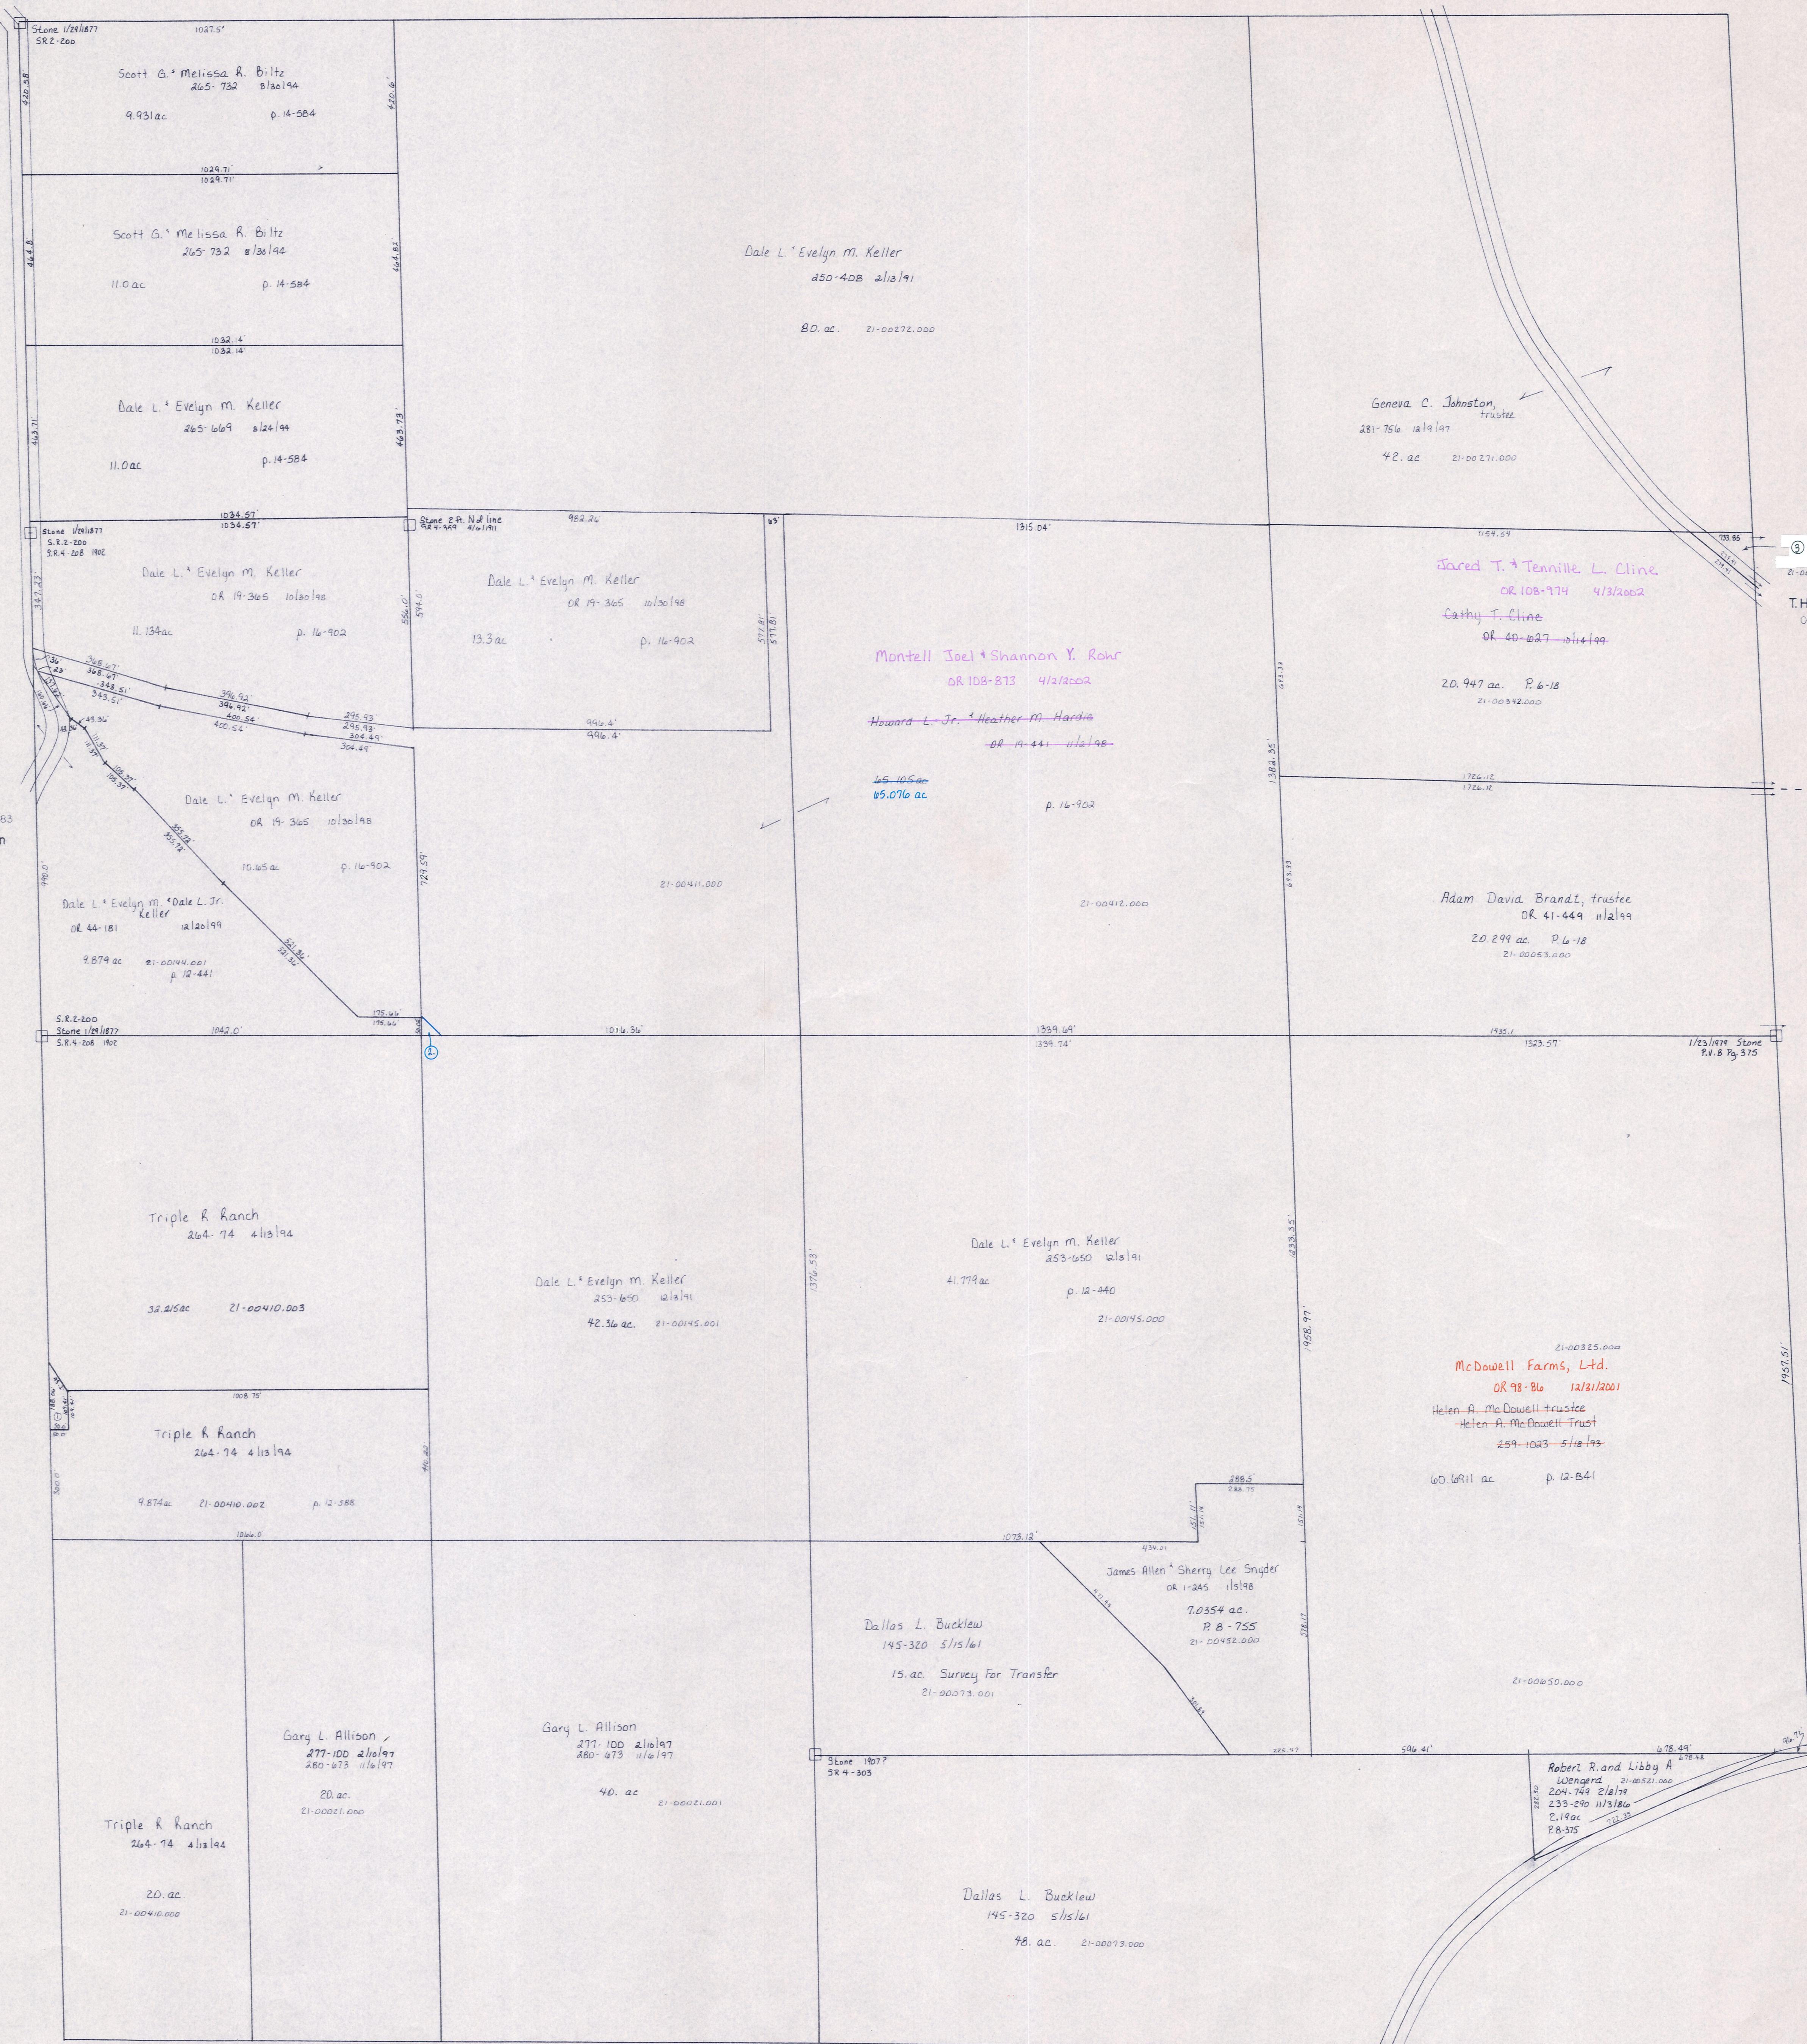

T.H. 36  
OLD T.H. 283  
R/W-Unknown


T.H. 253 40' R/W  
OLD T.H. 288

Killbuck Twp.  
K-5

Section 5  
R-30

Section 7  
R-34

T-8, R-8, Sec. 4  
RICHLAND TWP.  
SCALE 1" = 200'

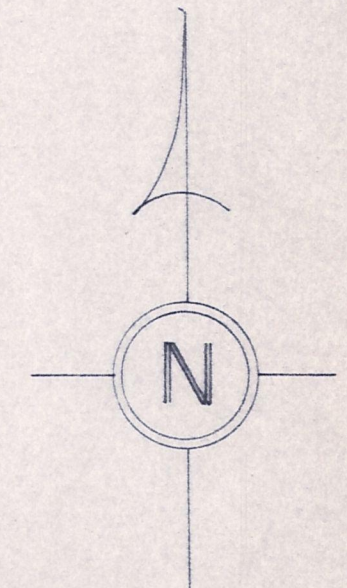

① Triple R Ranch 264-74 418194  
21-00410.003  
File page 288

② Dale L. Evelyn M. Keller 265-732 8/30/94  
21-00272.000 p. 14-584

LET IT BE KNOWN, THIS MAP HAS BEEN PREPARED AS A REFERENCE GUIDE TO PROPERTY OWNERSHIP. WE BELIEVE THIS INFORMATION TO BE CORRECT AND CURRENT, HOWEVER, IT IS NOT INTENDED FOR ANY LEGAL USE, WHETHER IT BE IN SALES, TRANSFERS, TRADES, LEASES OF ANY TYPE, ETC., AND DO NOT ACCEPT RESPONSIBILITY FOR ERRORS OF ANY NATURE OR OMISSIONS CONTAINED HEREIN.

R-35