


C.H. 77
60' x 114'

T.H. 652
T.H. 210
30' x 114'

T.H. 628
T.H. 212 (Old n^o)
40' x 114'

T.H. 628, T.H. 212, 60' x 114'

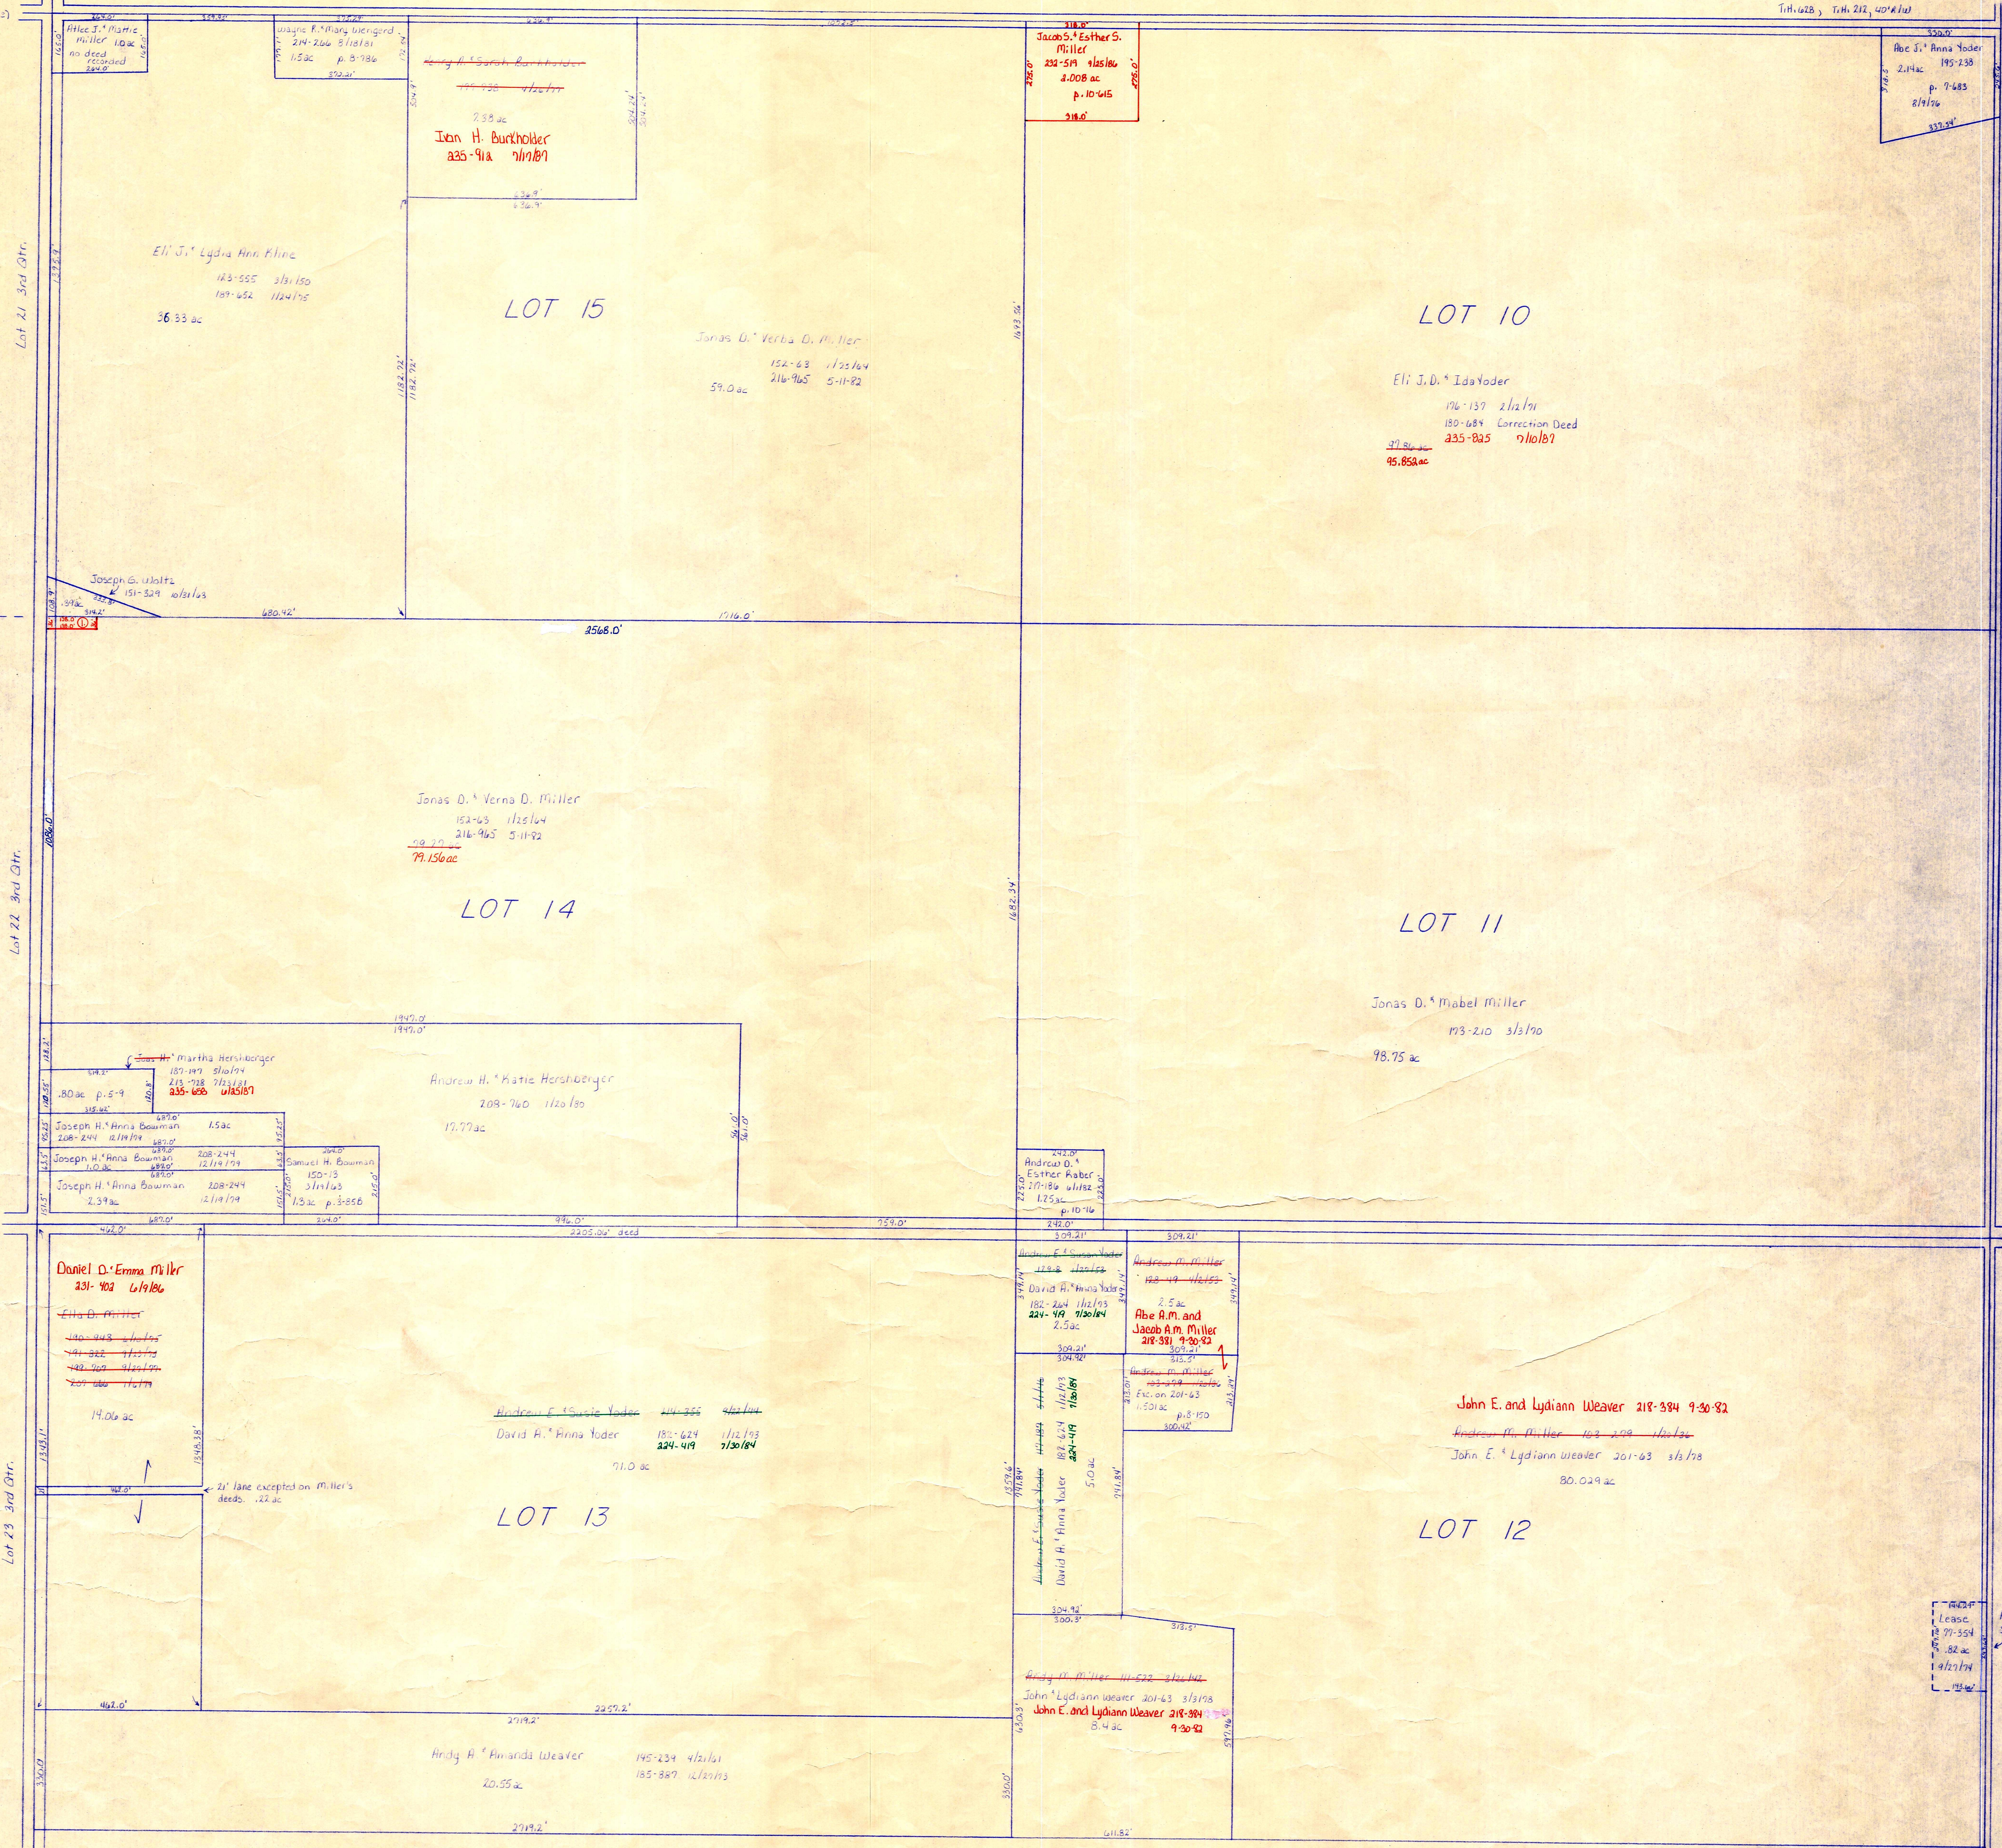

C.H. 77
60' x 114' D Joseph E. Woltz 236-164 8/16/87 .114 ac p. 10-798


Berlin Twp.

T.H. 652
T.H. 210
30' x 114'

T-10, R-5, 3rd. Qtr. Lots 10, 11, 12, 13, 14, 15
SALT CREEK TWP.

Scale 1" = 200'

Four Corners
School

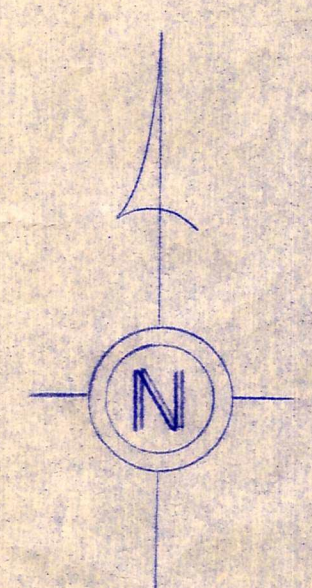

S-9