


T.H. 605
60' R/W

Sec. 3


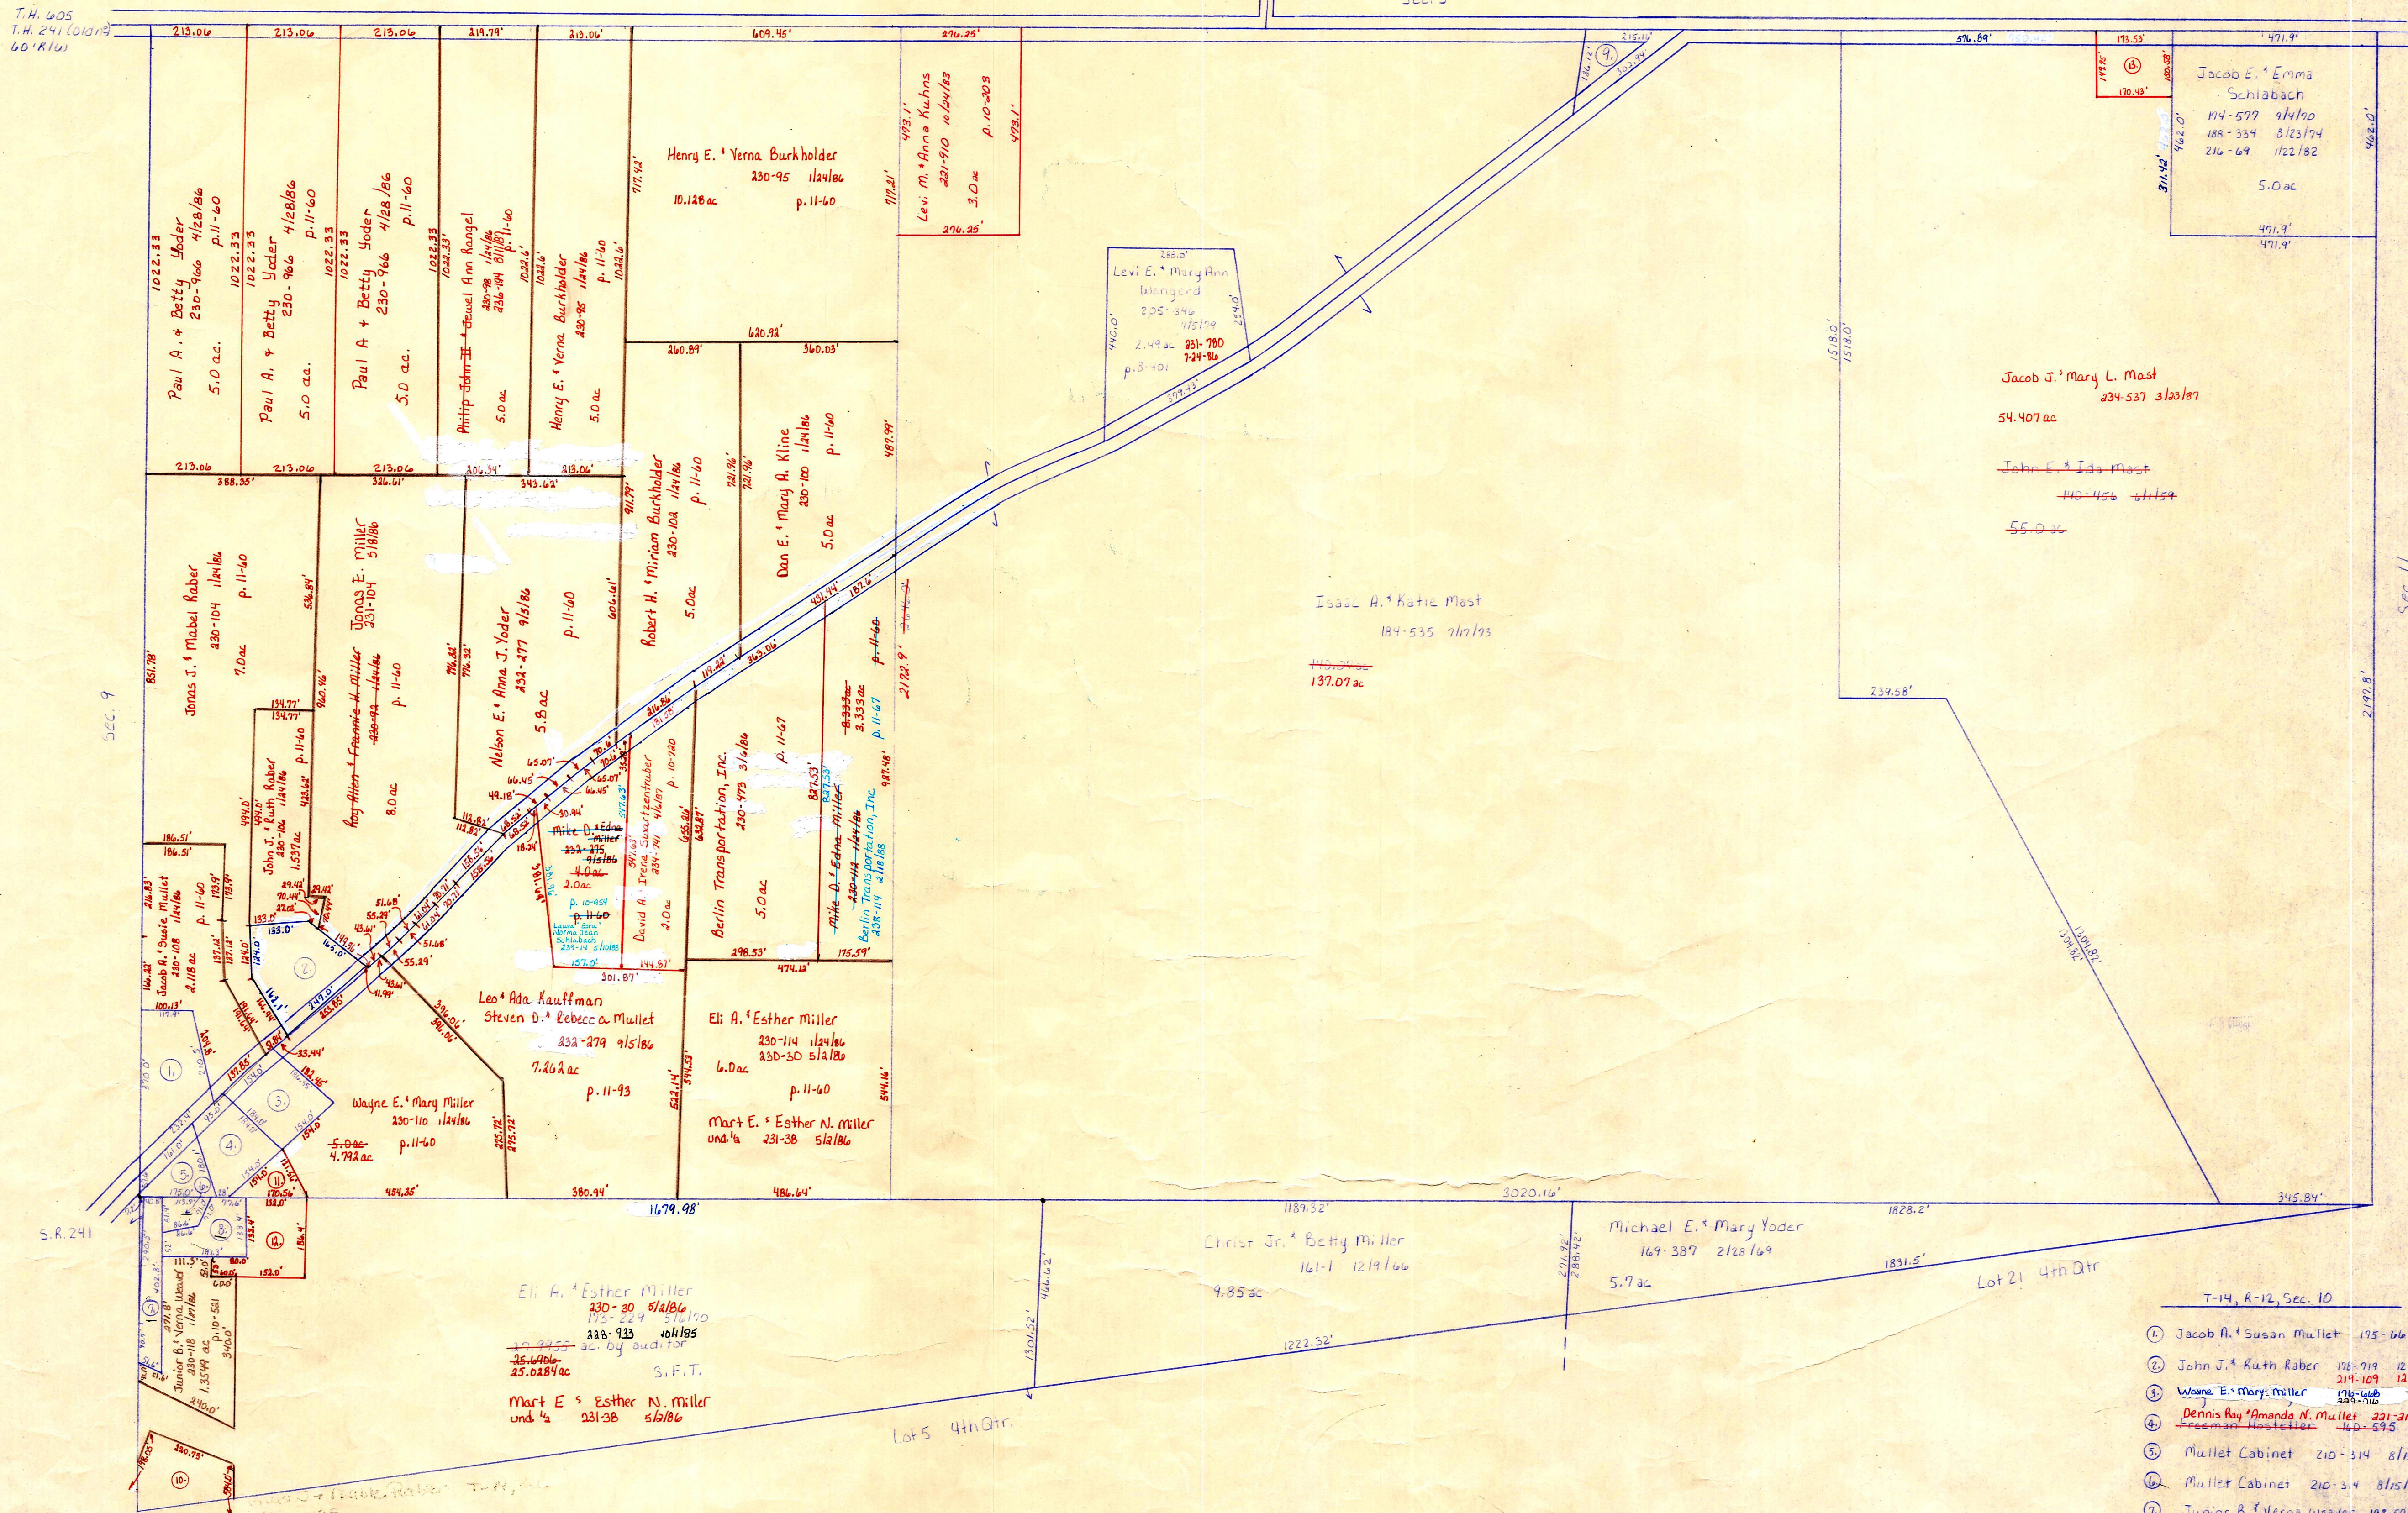

Sec. 9



Sec. 11

T-14, R-12, Sec. 10

- ⑤ Mullett Cabinet 210-314 8/15/80 .92 ac
- ⑥ Mullett Cabinet 210-314 8/15/80 .169 ac

T-14, R-12, Sec. 10
SALT CREEK TWP.

SCALE 1"=200'

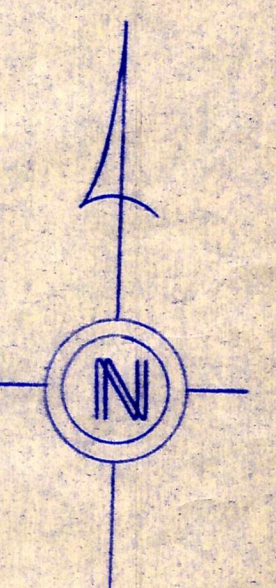

S-23