



See page S-27A for Mt. Hope Village

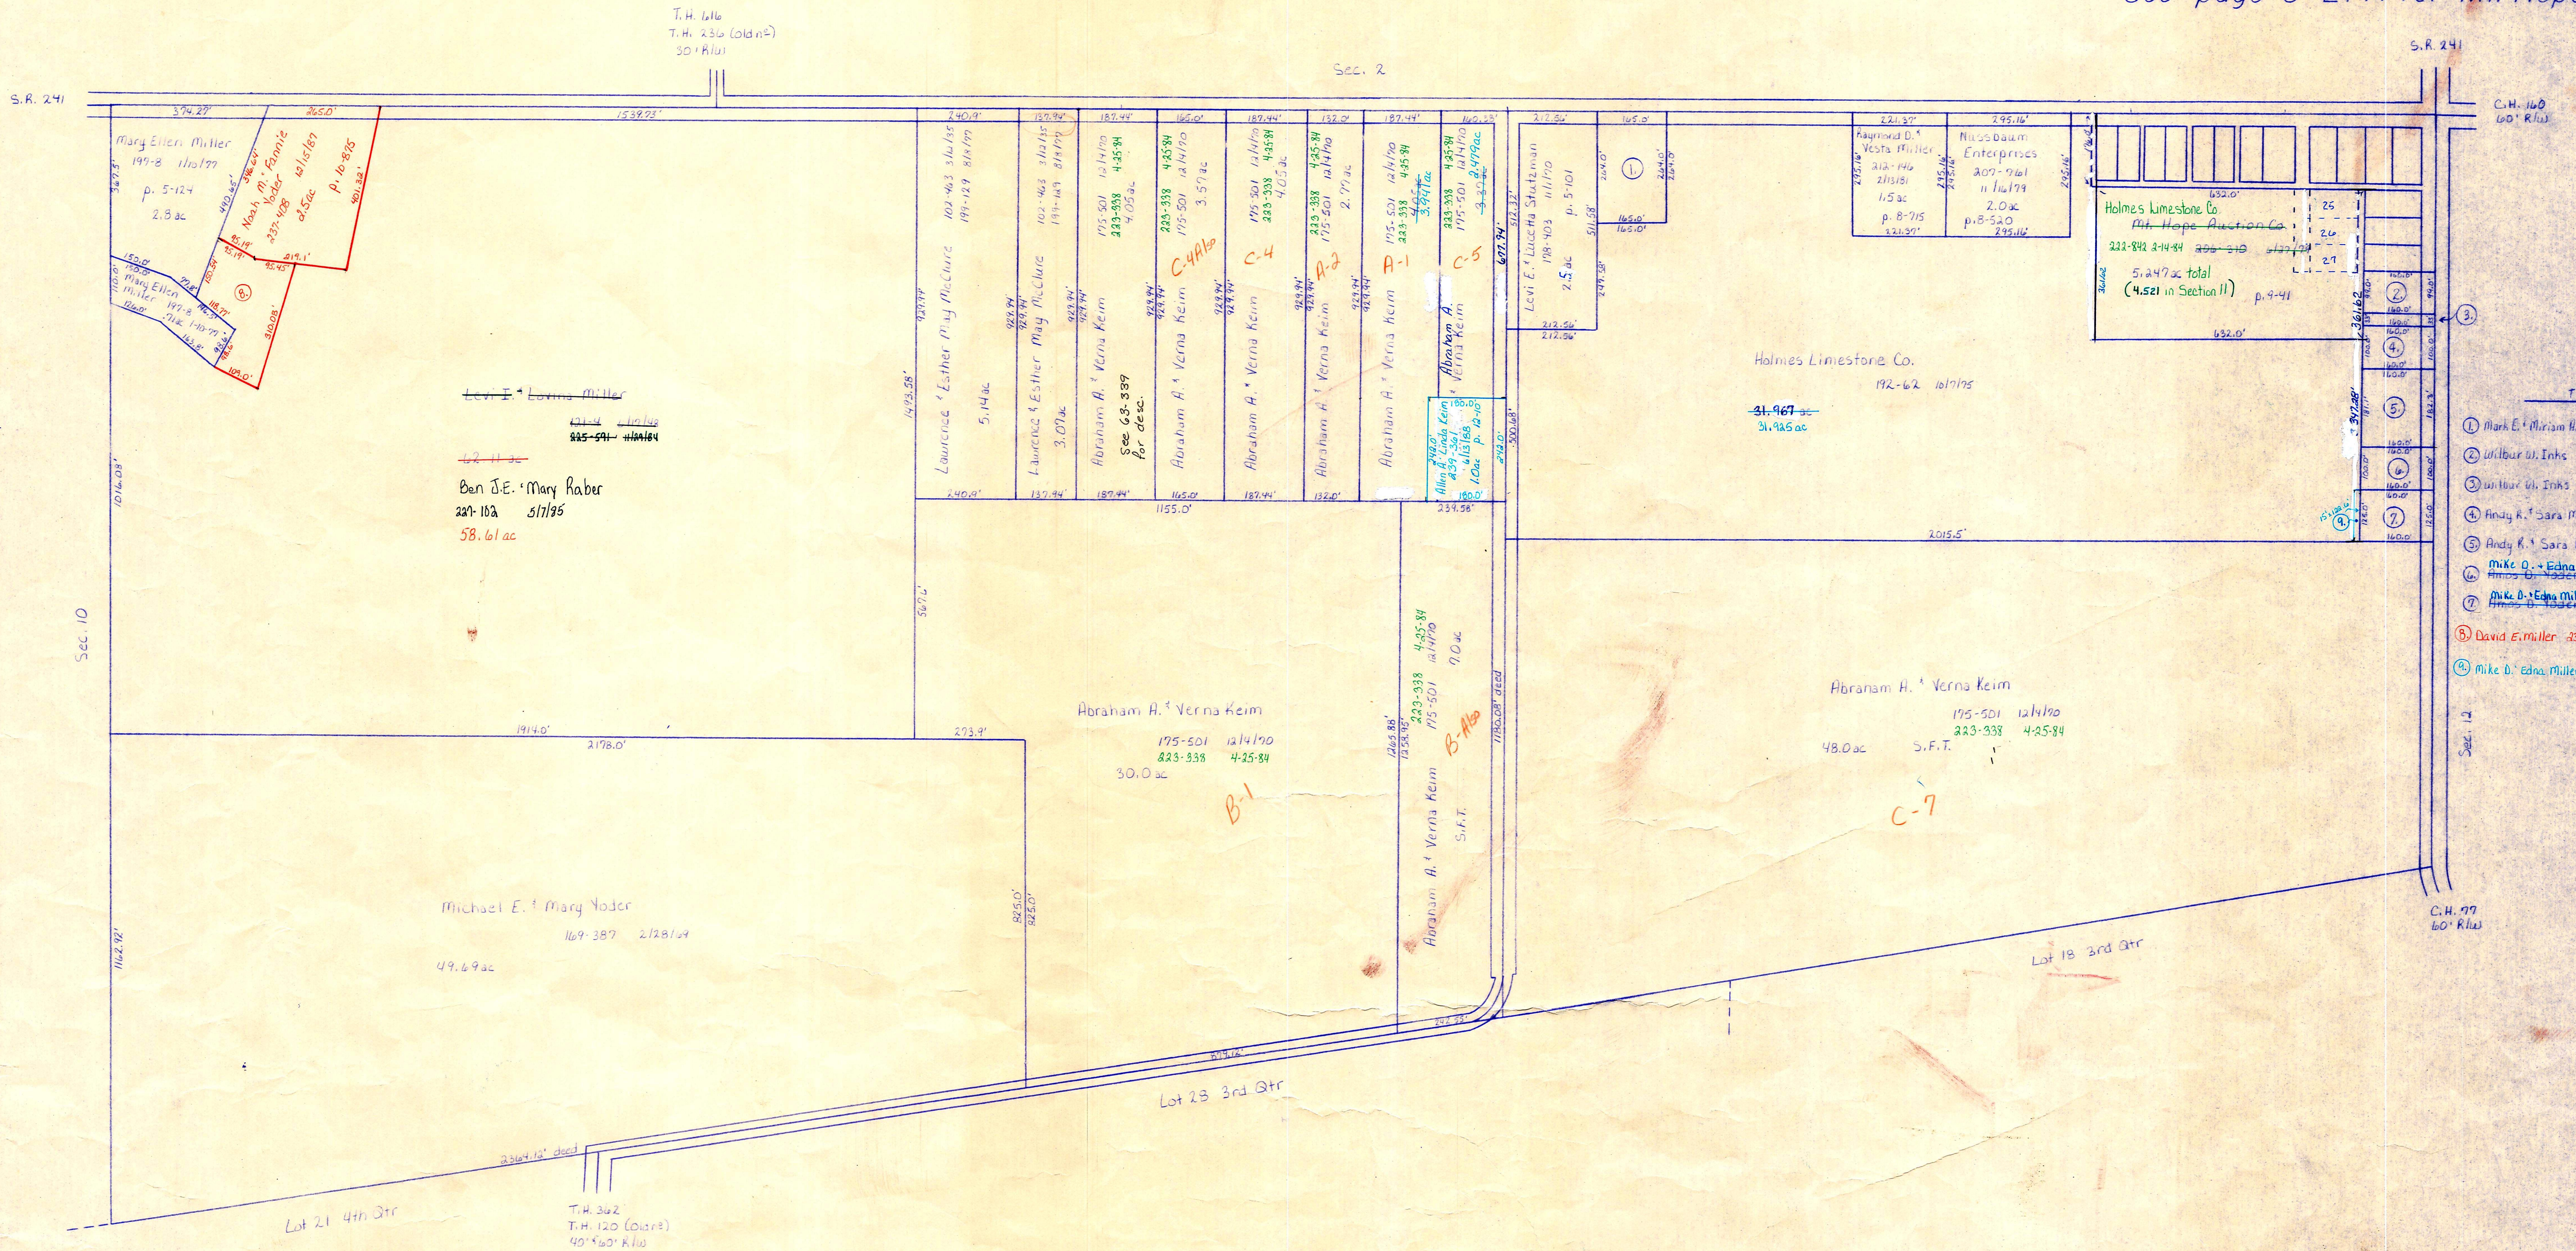


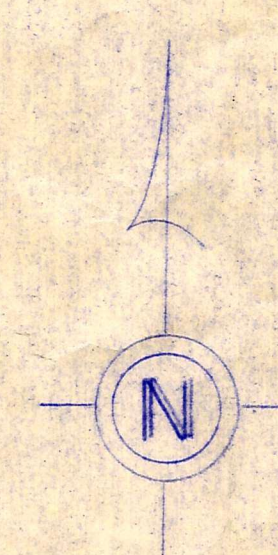

T-14, R-12, Sec. 11  
SALT CREEK TWP.

S-27