


T.H. 115
T.H. 234 (Diana)
30' R/W

Sec. 35

S. R. 24

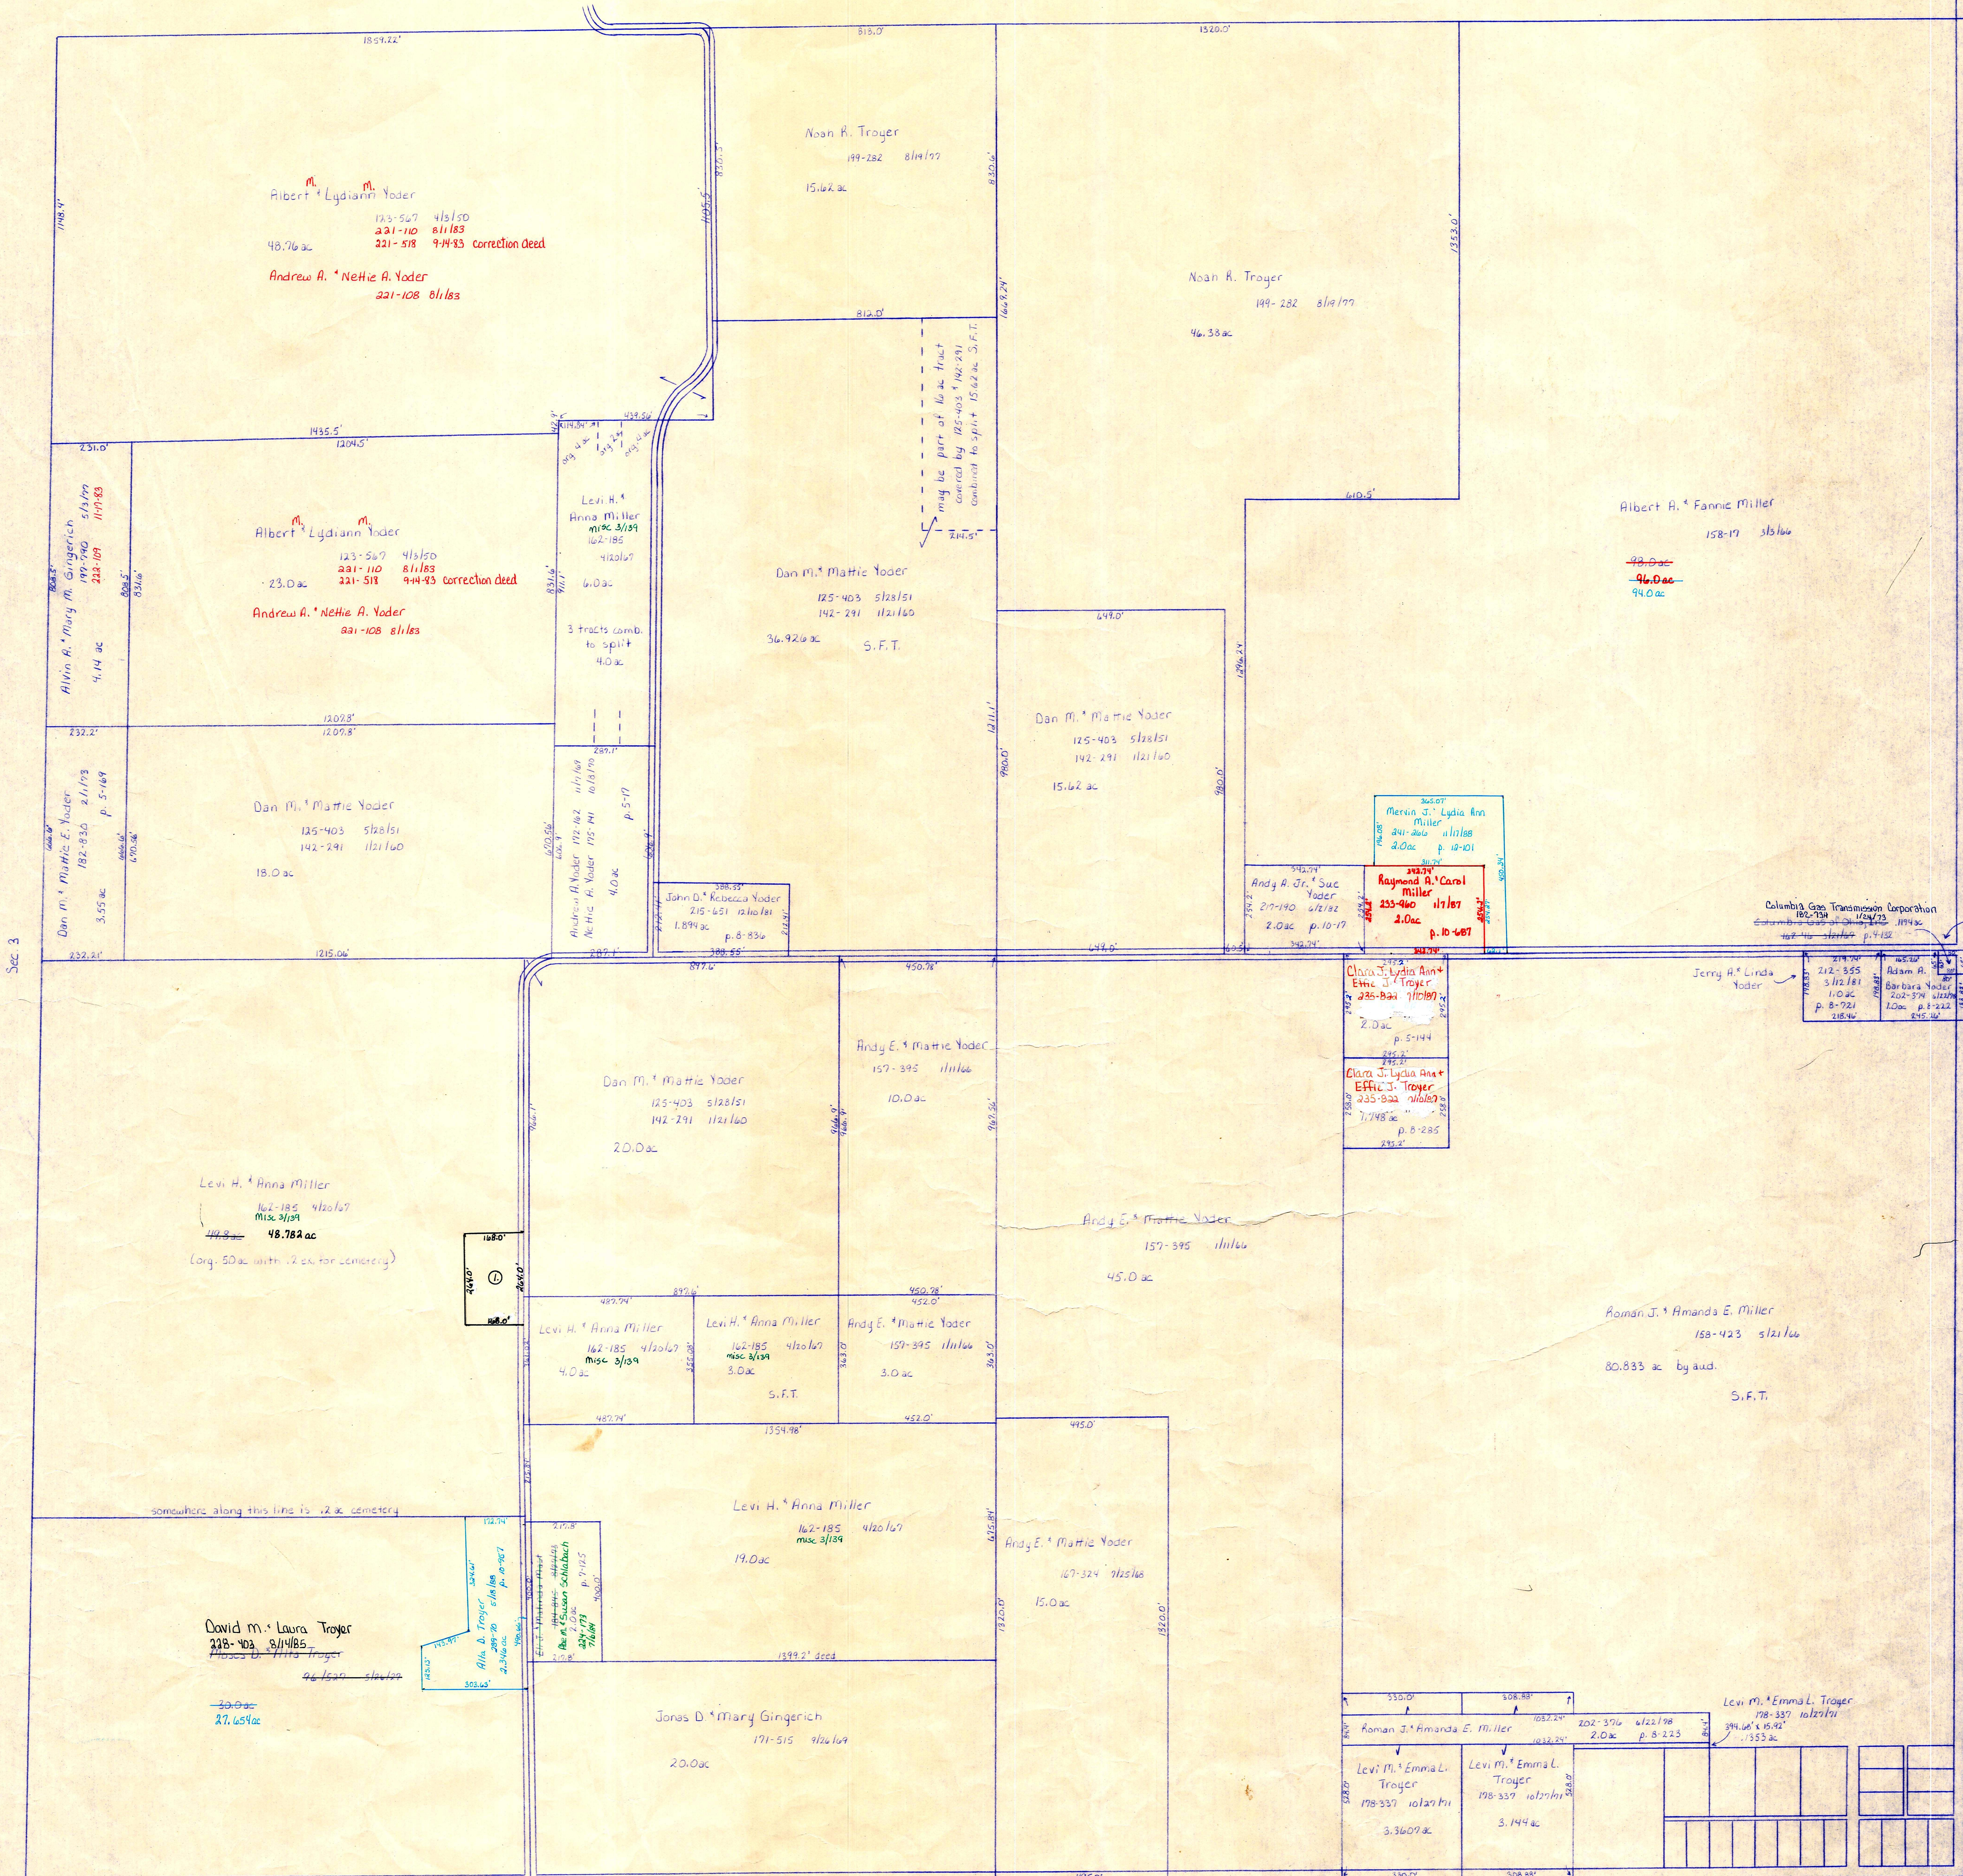

Sec. 3

Sec. 1

T.H. 116
T.H. 234 (Diana)
30' R/W

S.R. 24

T.H. 116
T.H. 234 (Diana)
30' R/W

Sec. 11

T.H. 342
T.H. 120 (Diana)
40' R/W

See page S-27A for Mt. Hope Village

C.H. 110
60' R/W

Wayne L. Miller 227-138 6/1/85 1.018 ac p. 10-406

T-14, R-12, Sec. 2
SALT CREEK TWP.

S-28