


Sec. 26

C.H. 177  
60' R/W

T.H. 613  
T.H. 240 (Old n2)  
53' R/W

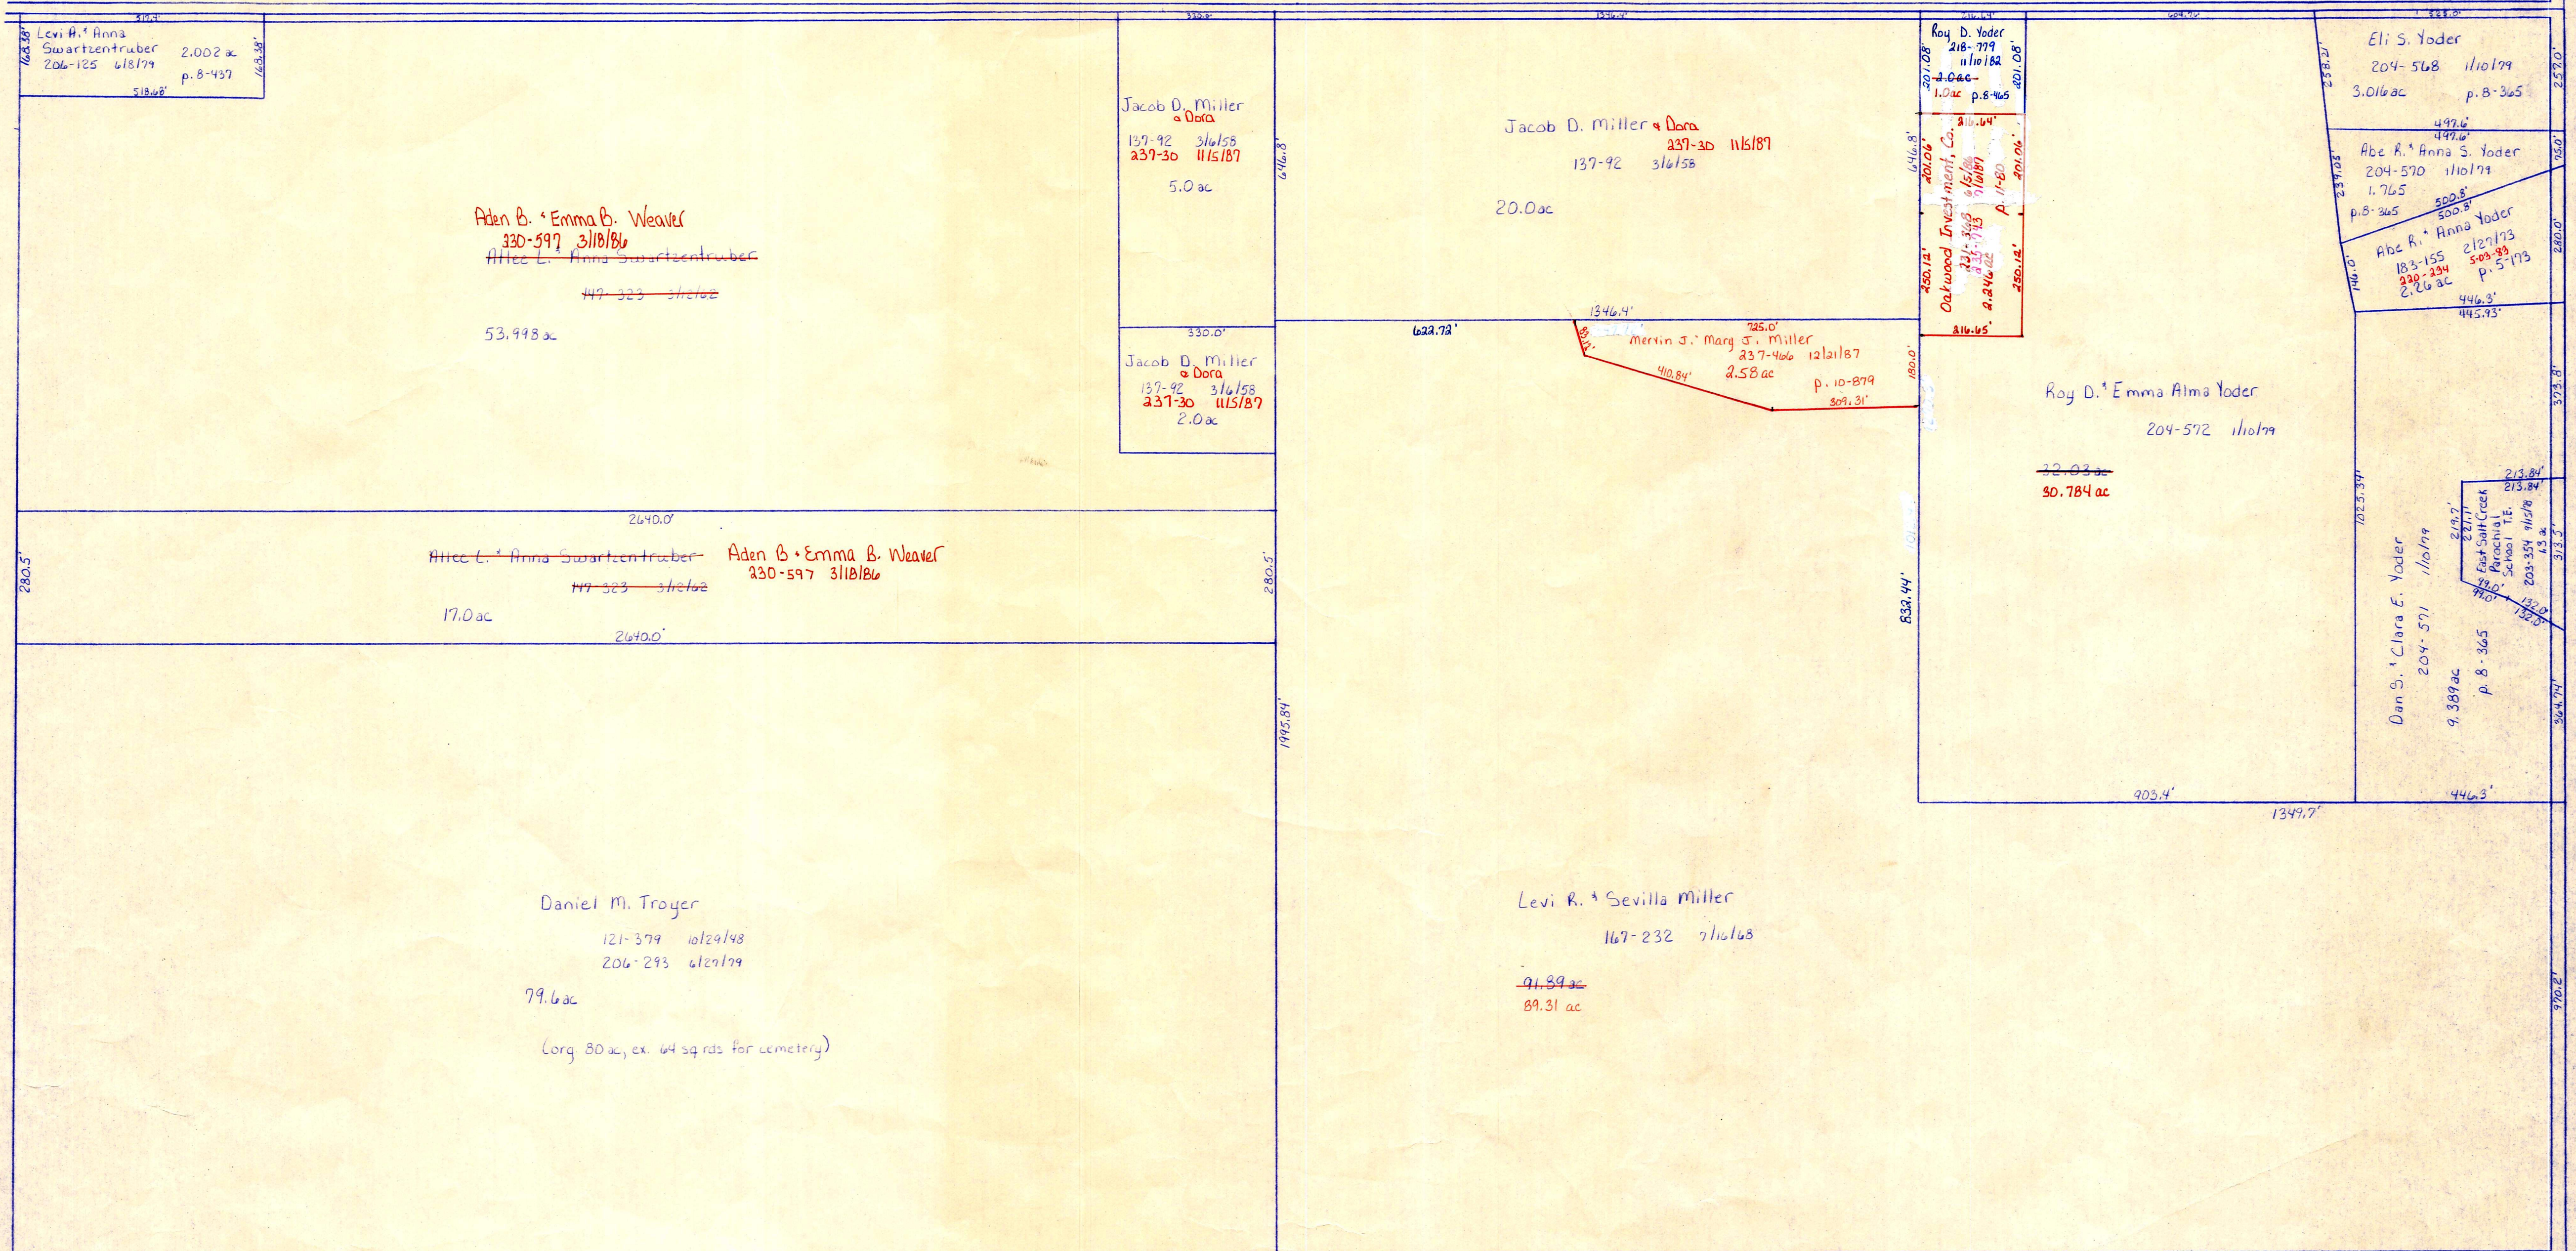

T.H. 616  
T.H. 214 (Old n2)  
60' R/W

T.H. 616  
T.H. 214 (Old n2)  
60' R/W



© Alice A. & Mary Troyer 233-456 116/156 .823 ac p. 10-644

T.H. 615  
T.H. 236 (Old n2)  
30' R/W

S.R. 241

T-15, R-12, Sec. 35  
SALT CREEK TWP.

SCALE 1"=200'

