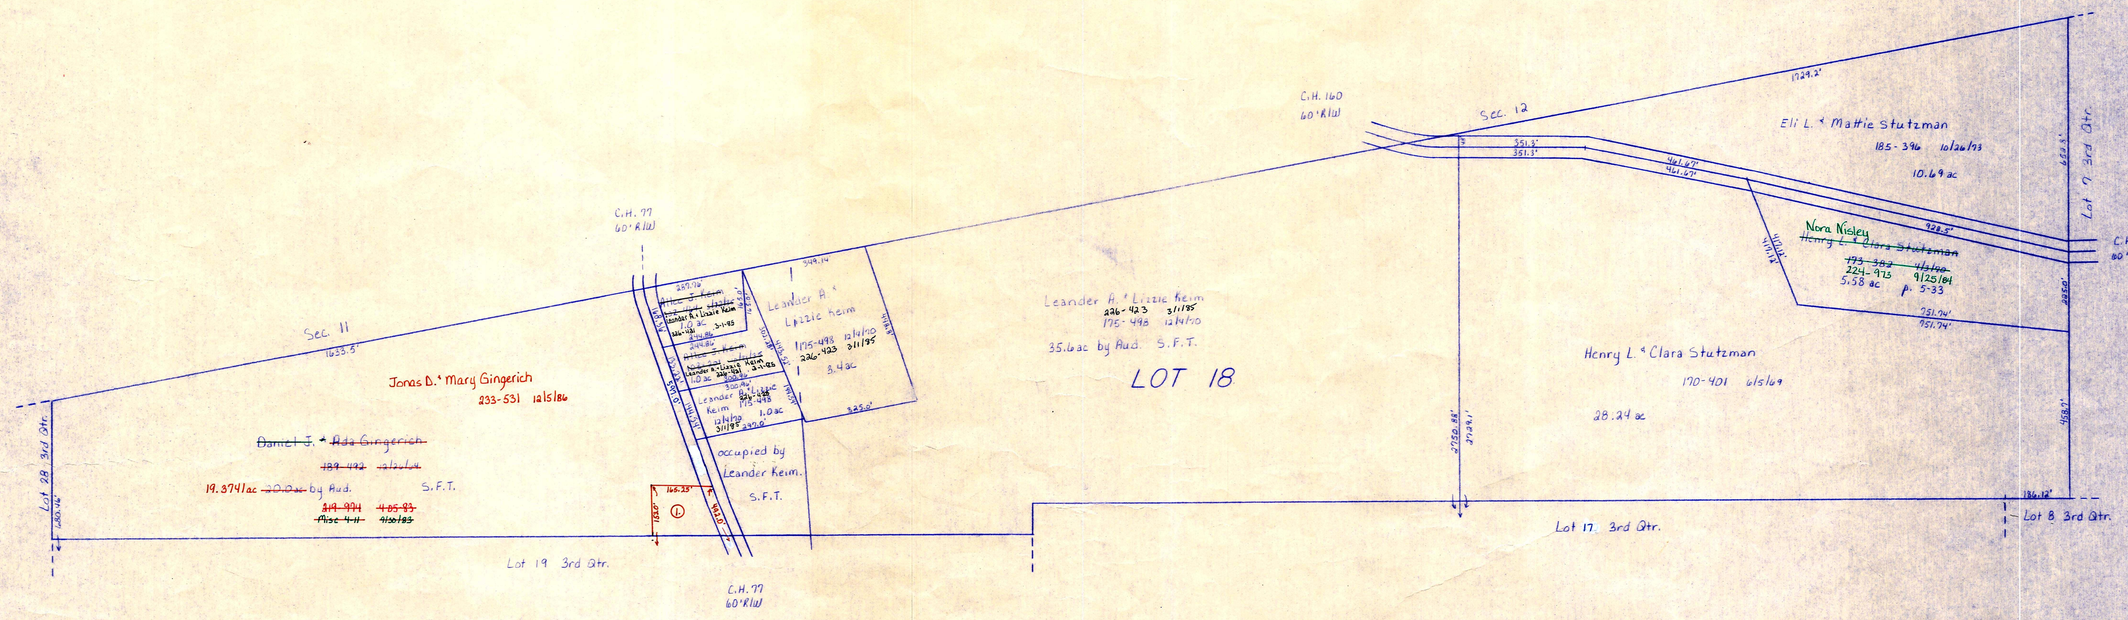

T-10, R-5, 3rd. Qtr. Lot 18
SALT CREEK TWP.

SCALE 1" = 200'

S-31