See page S-27A for Mt. Hope Village

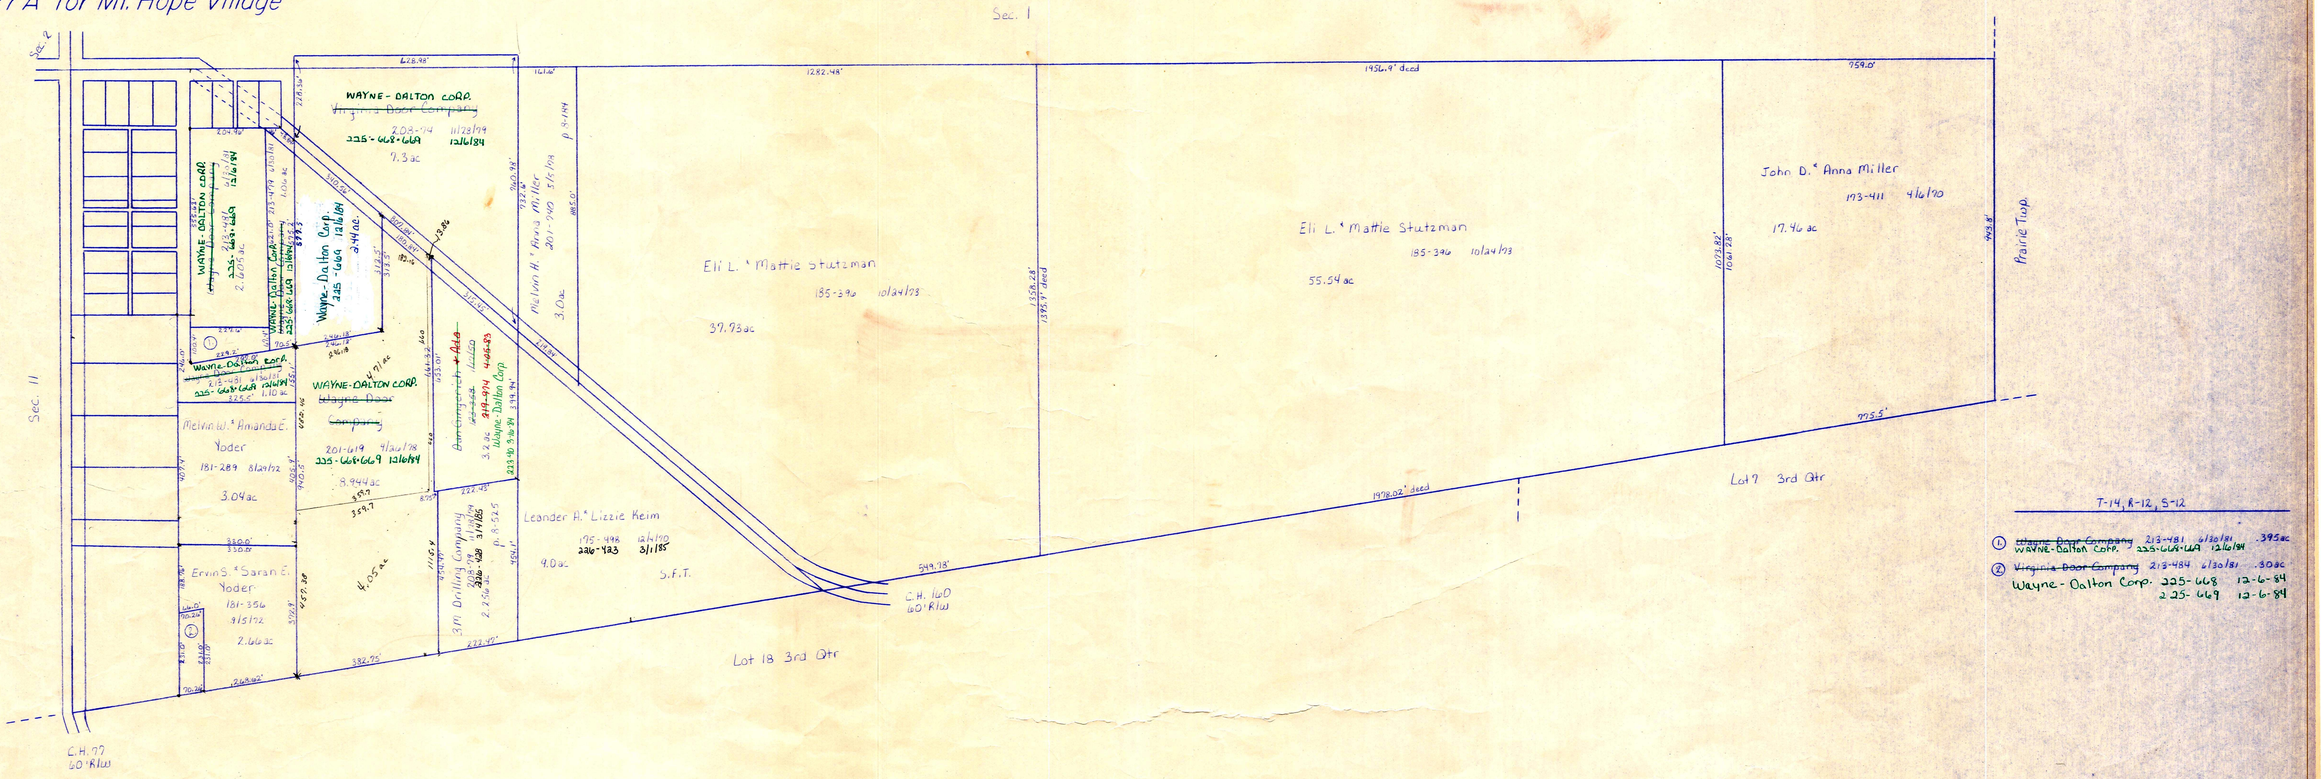

T-14, R-12, Sec. 12
SALT CREEK TWP.

SCALE : 1" = 200'