

C.H. 77
60' R/W

T.H. 614
T.H. 238 (Old) 40' R/W

T.H. 612
T.H. 215 (Old) 60' R/W

Wayne County

C.H. 229
55' R/W

C.H. 229
35' R/W

Paint Trap

Sec. 26


Sec. 35

T.H. 613
T.H. 240 (Old) 35' R/W

T.H. 614
T.H. 238 (Old) 40' R/W

T.H. 612
T.H. 215 (Old) 60' R/W

C.H. 77
60' R/W

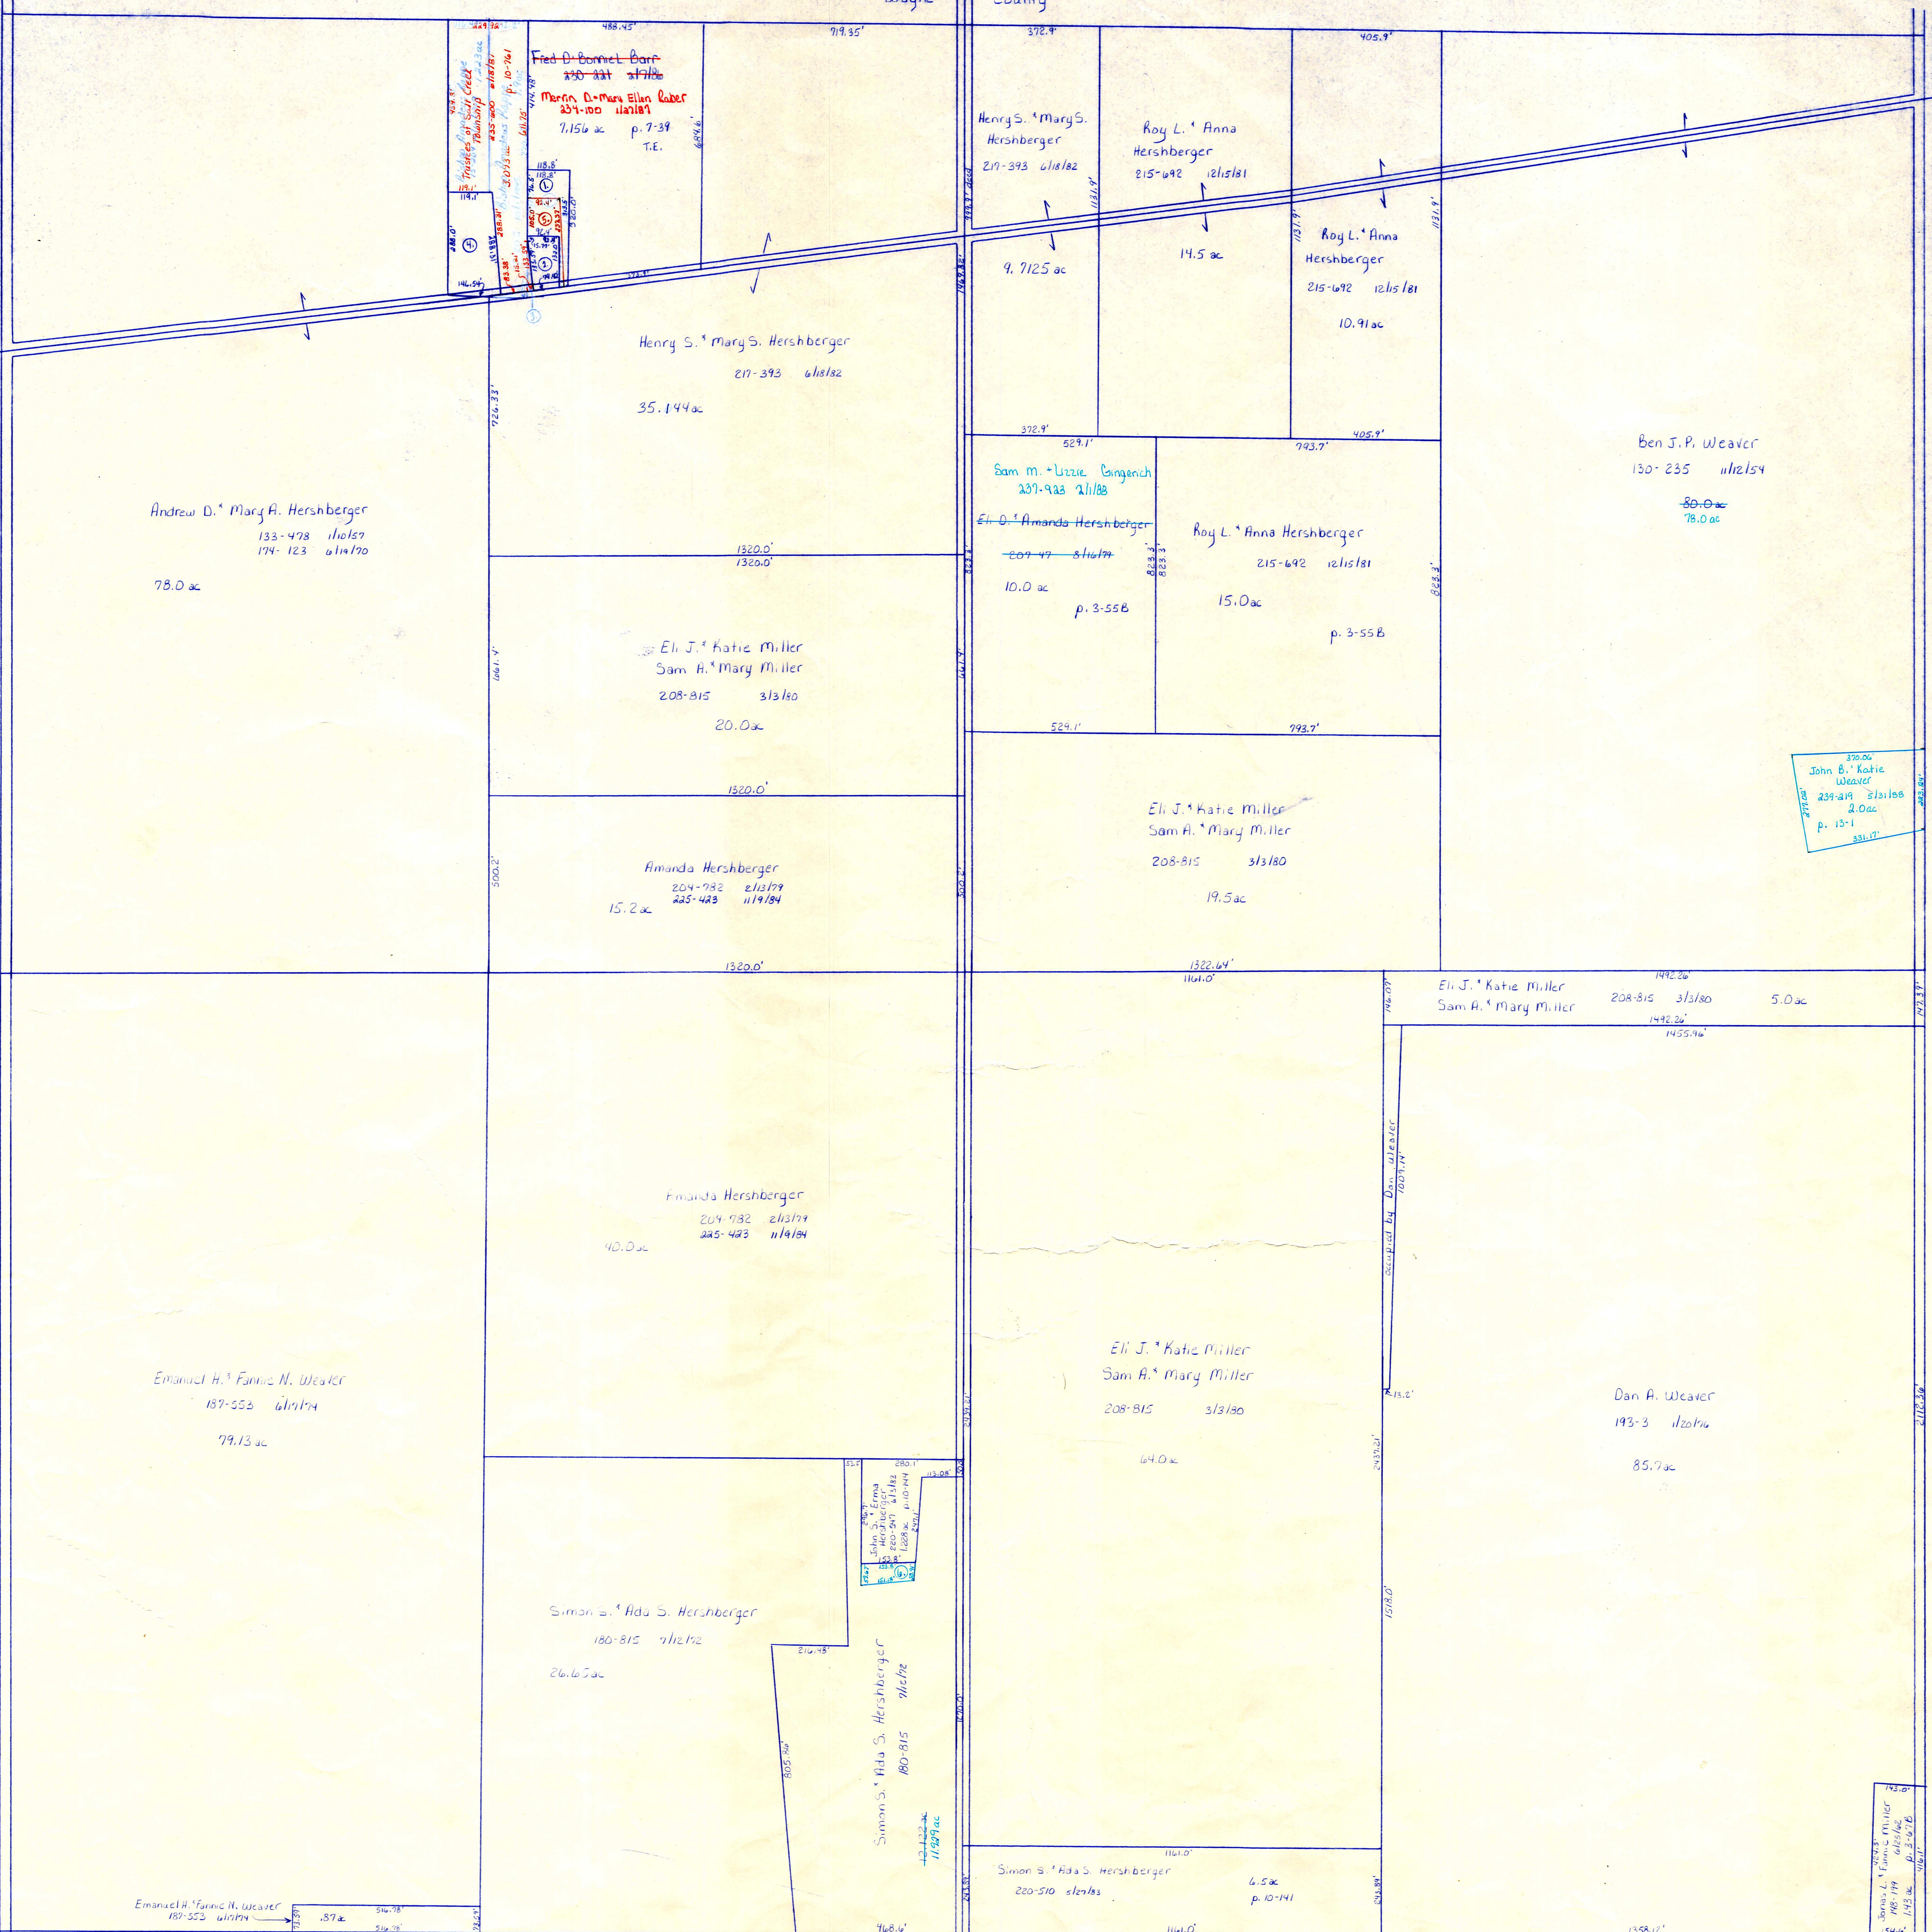



John B. & Katie Weaver
239-218 2.0 ac
p. 13-1

Simon S. & Ada S. Hershberger
180-815 11/21/82
1.93 ac p. 2-20/86

T-15, R-12, Sec. 25
SALT CREEK TWP.

LET IT BE KNOWN, THIS MAP HAS BEEN PREPARED AS A REFERENCE GUIDE TO PROPERTY OWNERSHIP. WE BELIEVE THIS INFORMATION TO BE CORRECT AND CURRENT. HOWEVER, IT IS NOT INTENDED FOR ANY LEGAL USE, WHETHER IT BE IN SALES, TRANSFERS, TRADES, LEASES OF ANY TYPE, ETC. AND DO NOT ACCEPT RESPONSIBILITY FOR ERRORS OF ANY NATURE OR OMISSIONS CONTAINED HEREIN.

SCALE 1"=200'

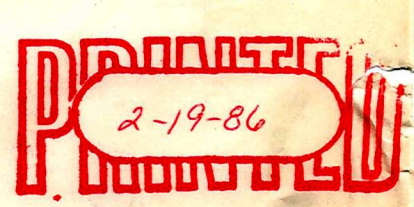

S-35