


T.H. 615  
T.H. 236 (old rd)  
30' R/W

Sec. 35

S. R. 241

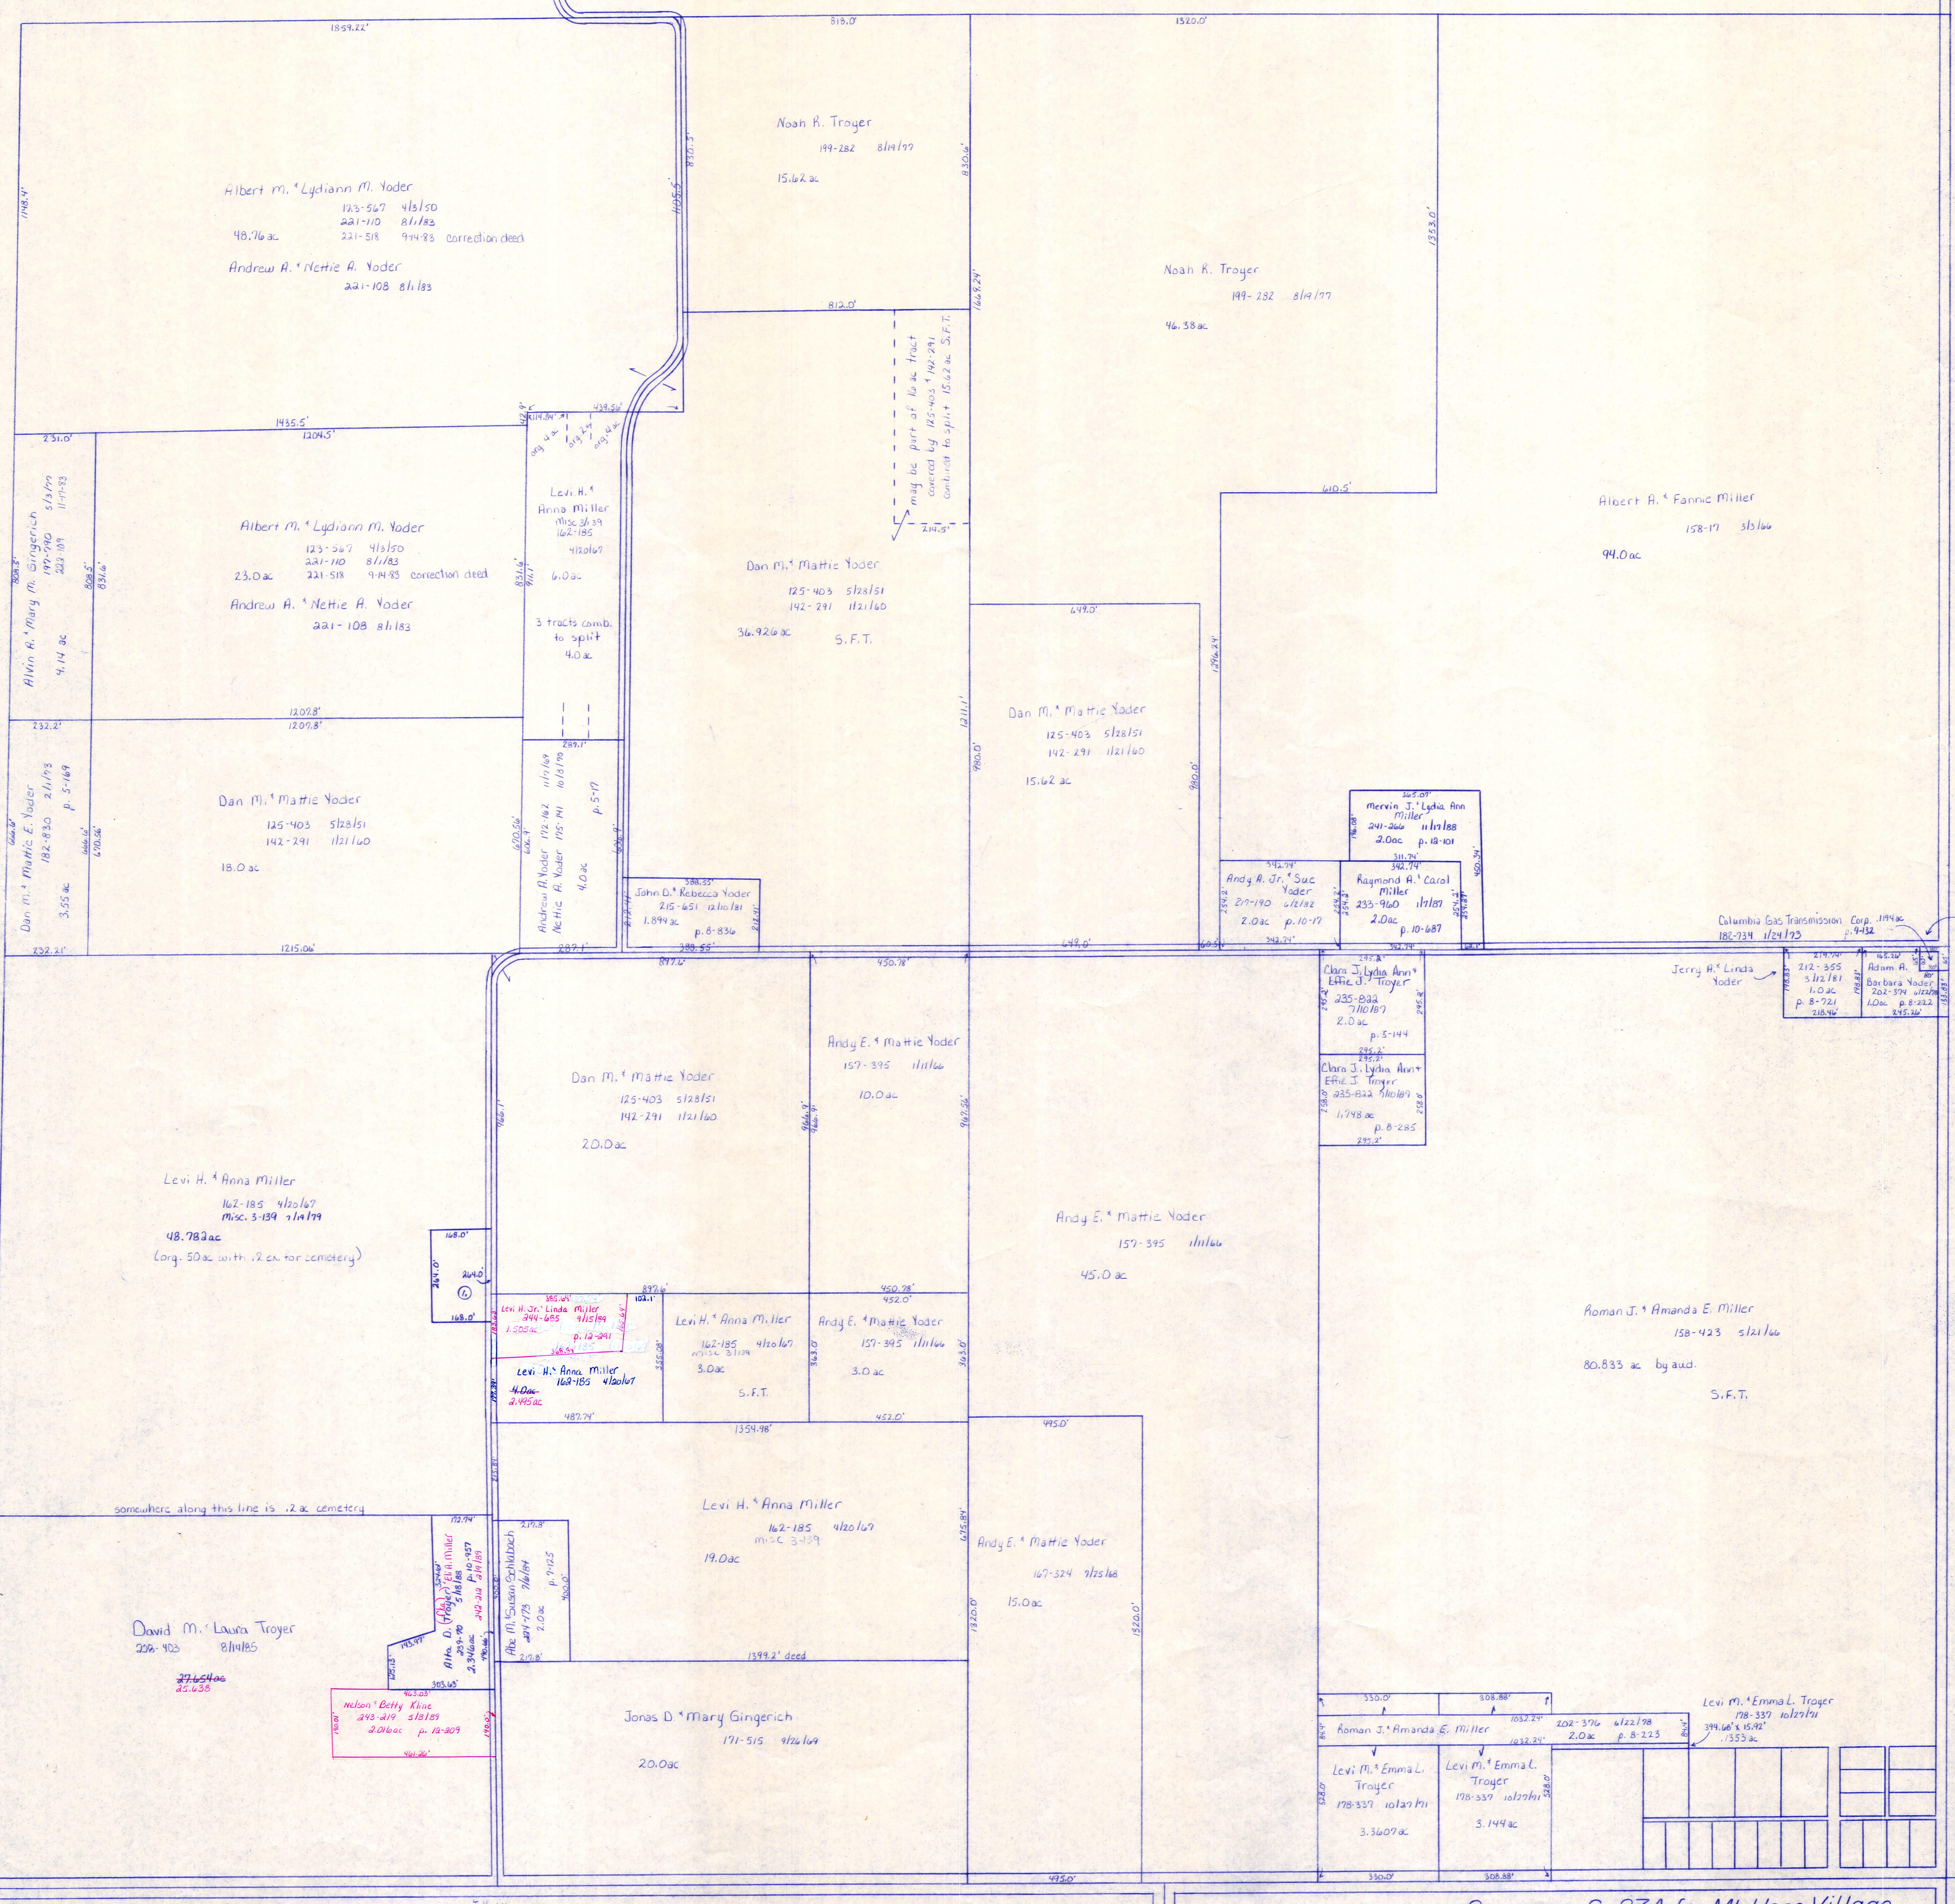

Sec. 3

Sec. 1

T.H. 616  
T.H. 236 (old rd)  
30' R/W

Wayne L. Miller 227-138 3/10/85 1.018 ac p. 10-406

T.H. 616  
T.H. 236 (old rd)  
30' R/W

Sec. 11

T.H. 362  
T.H. 120 (old rd)  
40' R/W

See page S-27A for Mt. Hope Village

C.H. 160  
60' R/W

T-14, R-12, Sec. 2  
SALT CREEK TWP.

LET IT BE KNOWN, THIS MAP HAS BEEN PREPARED AS A REFERENCE GUIDE TO PROPERTY OWNERSHIP. WE BELIEVE THIS INFORMATION TO BE CORRECT AND CURRENT, HOWEVER, IT IS NOT INTENDED FOR ANY LEGAL USE, WHETHER IT BE IN SALES, TRANSFERS, TRADES, LEASES OF ANY TYPE, ETC., AND DO NOT ACCEPT RESPONSIBILITY FOR ERRORS OF ANY NATURE OR OMISSIONS CONTAINED HEREIN.

S-28