


T.H. 613
T.H. 240 (old n2)
53' R/W



T.H. 606
T.H. 214 (old n2)
60' R/W

Sec. 34

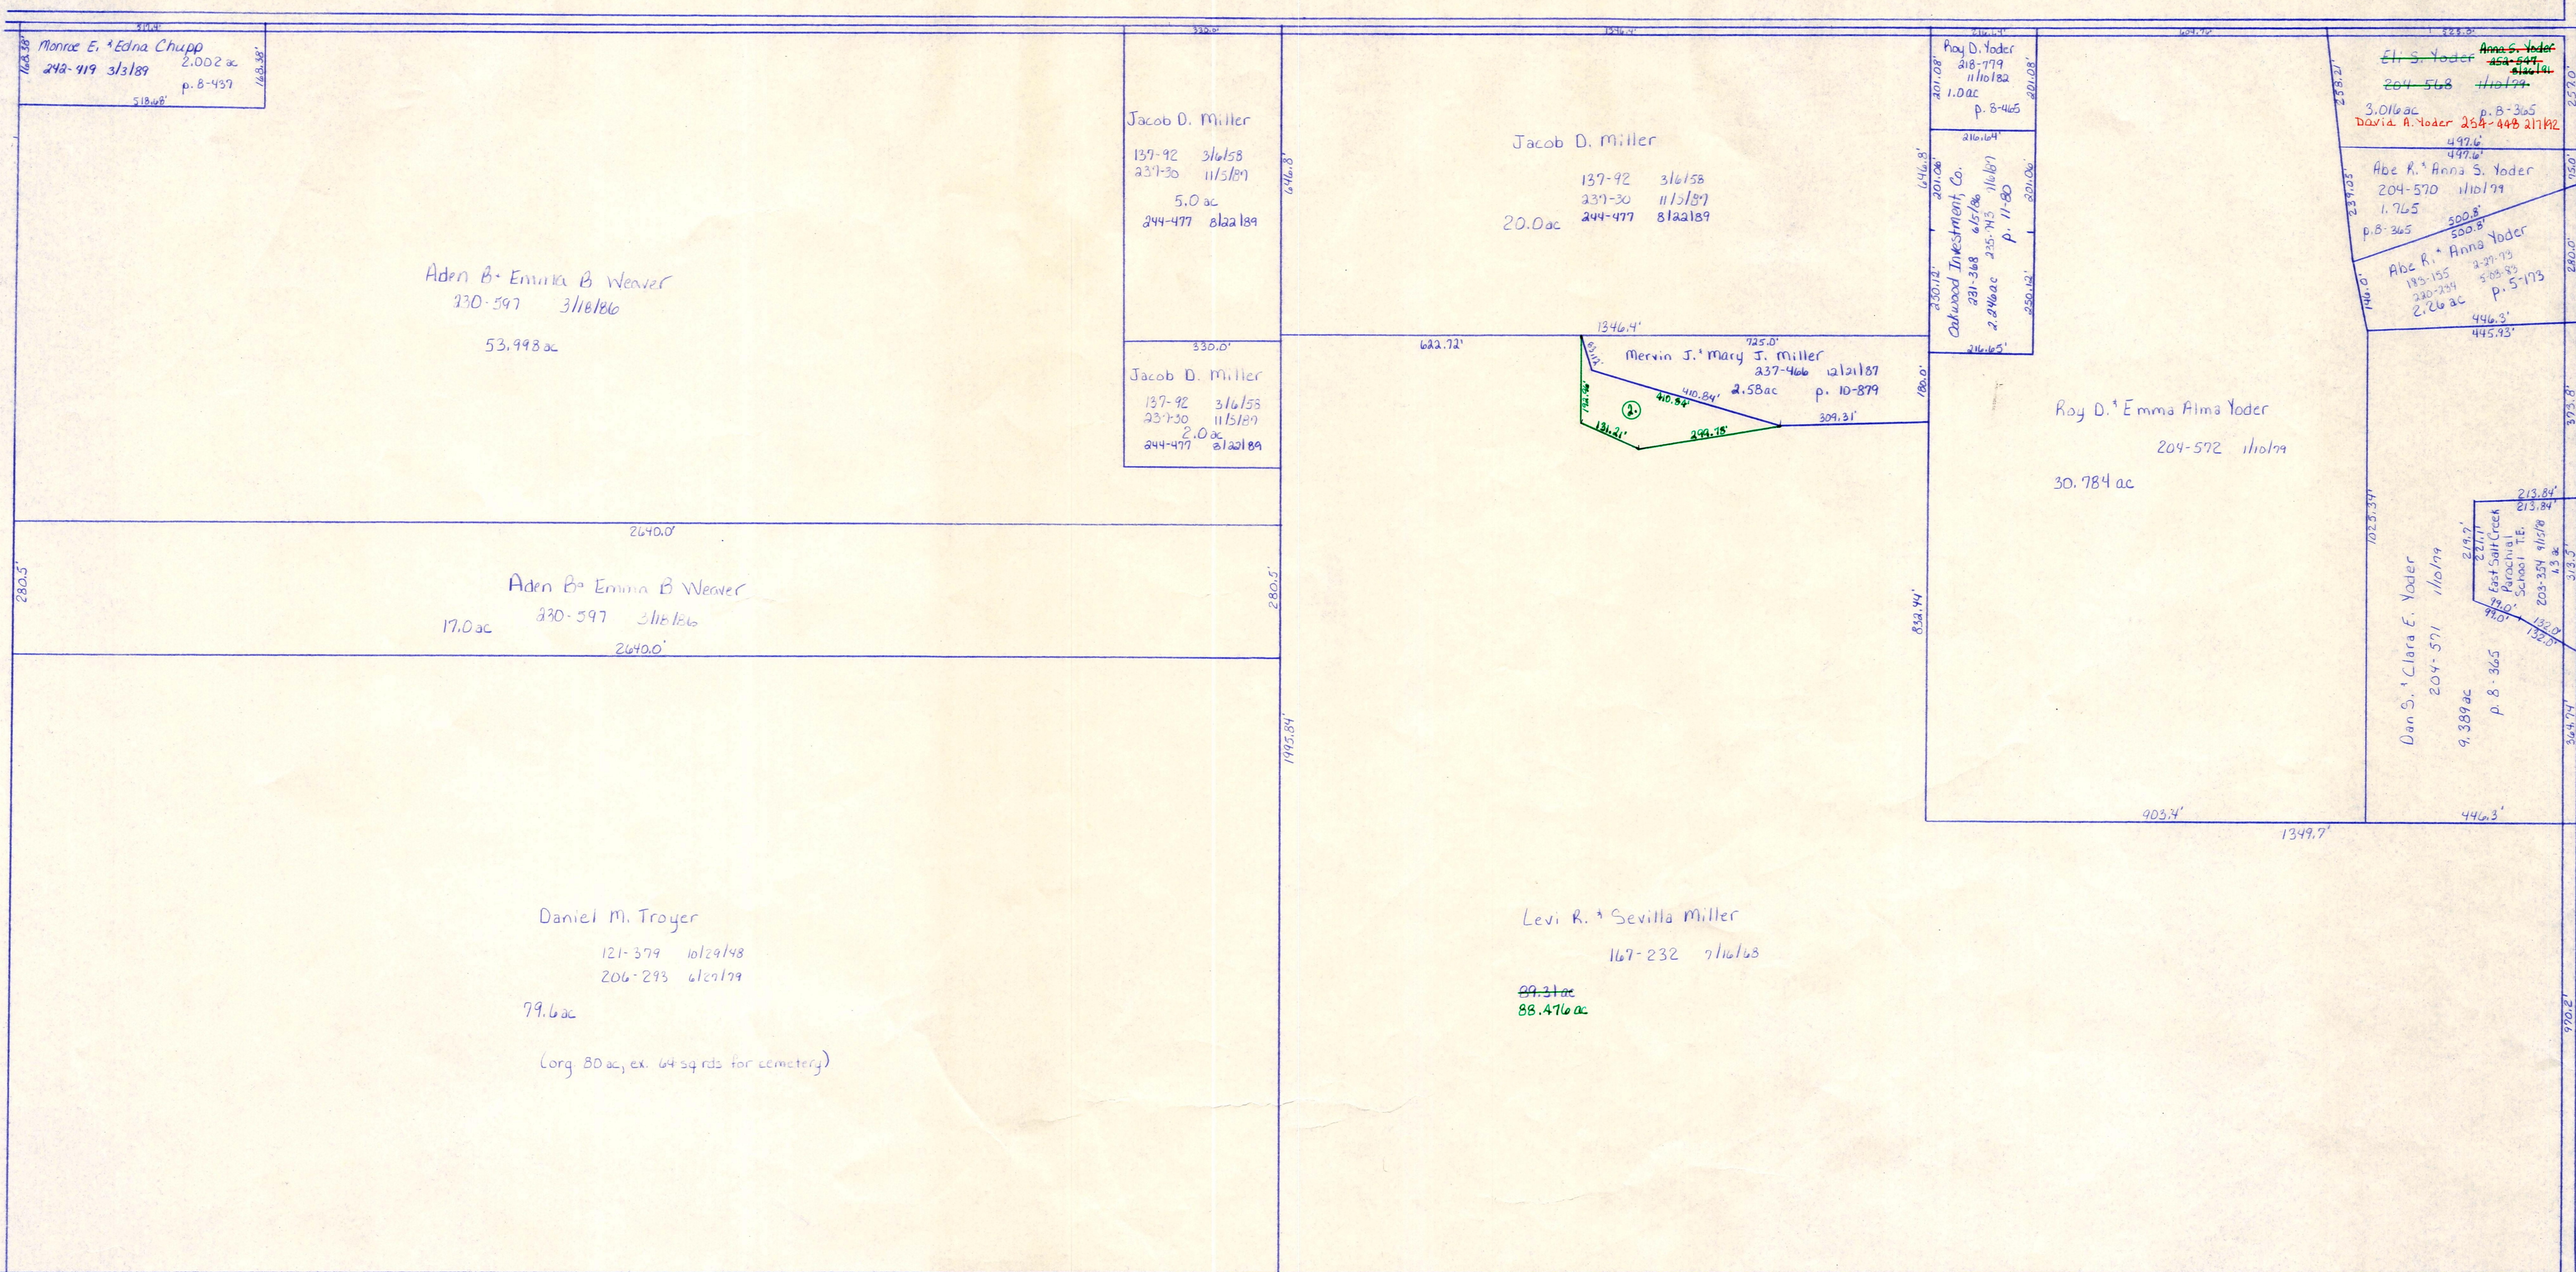

T.H. 606
T.H. 214 (old n2)
60' R/W

Sec. 36

- ① Alice A. Mary Troyer 233-256 n1s186 .223ac p.10-644
- ② Merrin J. Mary Miller 253-296 n1s191 .834ac p.12-783

T.H. 615
T.H. 236 (old n2)
30' R/W

T-15, R-12, Sec. 35
SALT CREEK TWP.

SCALE 1"=200' LET IT BE KNOWN, THIS MAP HAS BEEN PREPARED AS A REFERENCE GUIDE TO PROPERTY OWNERSHIP. WE BELIEVE THIS INFORMATION TO BE CORRECT AND CURRENT. HOWEVER, IT IS NOT INTENDED FOR ANY LEGAL USE, WHETHER IT BE IN SALES, TRANSFERS, TRADES, LEASES OF ANY TYPE, ETC. AND DO NOT ACCEPT RESPONSIBILITY FOR ERRORS OF ANY NATURE OR OMISSIONS CONTAINED HEREIN.