


- ① Ivan C. & Naomi Miller 351-463 512411 .50ac p.10-103
- ② Trustees of Wolgamut Grove 28-125 9/22/1858 .06ac
- ③ Country View Woodworking, LTD. of 28-183 3/22/199 1.308ac p.17-36
- ④ Roy P. & Kathy Miller of 28-176 3/22/199 .324ac p.17-36
- ⑤ Country View Woodworking, LTD. of 28-183 3/22/199 .029ac p.17-36
- ⑥ Roy P. & Kathy Miller of 28-176 3/22/199 .102ac p.17-36

Sec. 4

Sec. 2

Delmar J. & Karen R. Troyer 282-95 231-835 2/13/16 1.594ac p.10-384  
 of 41-221 305-08 12/19/91 1.950ac p. 5-127

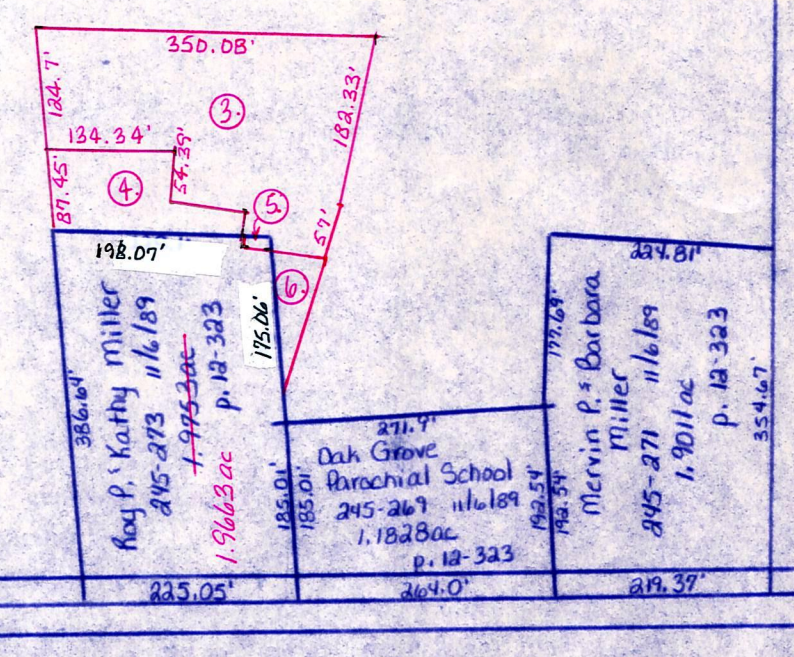

T-14, R-12, Sec. 3  
 SALT CREEK TWP.

SCALE 1"=200'  
 LET IT BE KNOWN, THIS MAP HAS BEEN PREPARED AS A REFERENCE GUIDE TO PROPERTY OWNERSHIP. WE BELIEVE THIS INFORMATION TO BE CORRECT AND CURRENT, HOWEVER, IT IS NOT INTENDED FOR ANY LEGAL USE, WHETHER IT BE IN SALES, TRANSFERS, TRADES, LEASES OF ANY TYPE, ETC., AND DO NOT ACCEPT RESPONSIBILITY FOR ERRORS OF ANY NATURE OR OMISSIONS CONTAINED HEREIN.

S-24