


T.H. 613
Old T.H. 240
35' R/W


Sec. 26

T.H. 615
Old T.H. 240
35' R/W

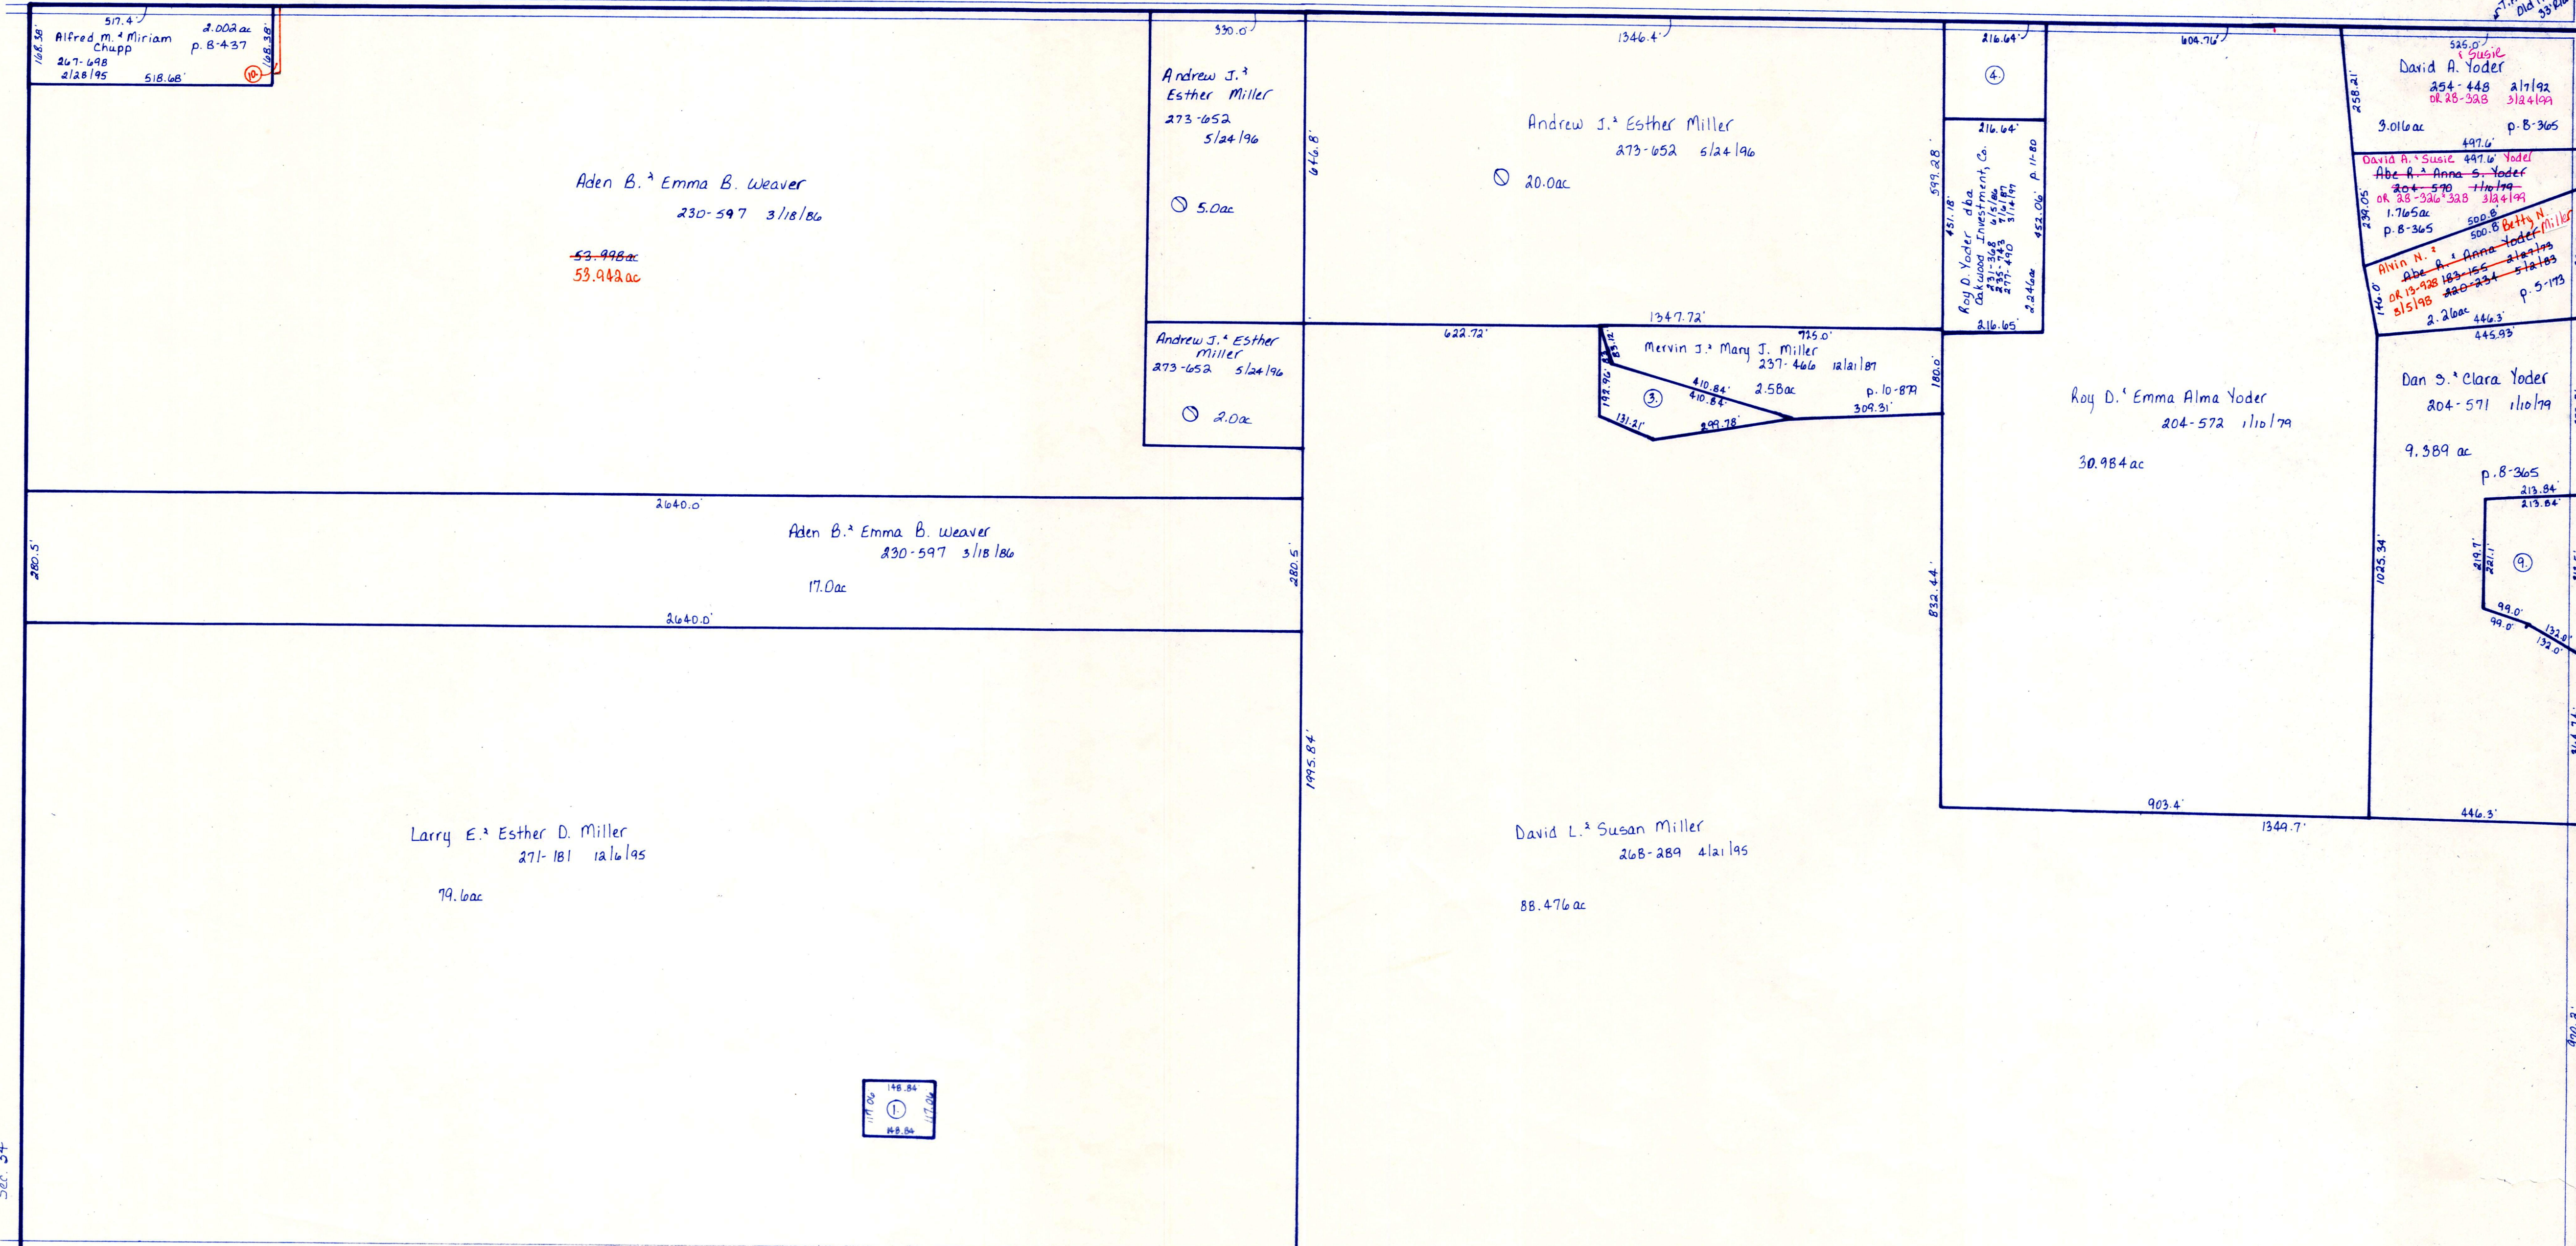

T.H. 606
Old T.H. 214
60' R/W

T.H. 606
Old T.H. 214
60' R/W

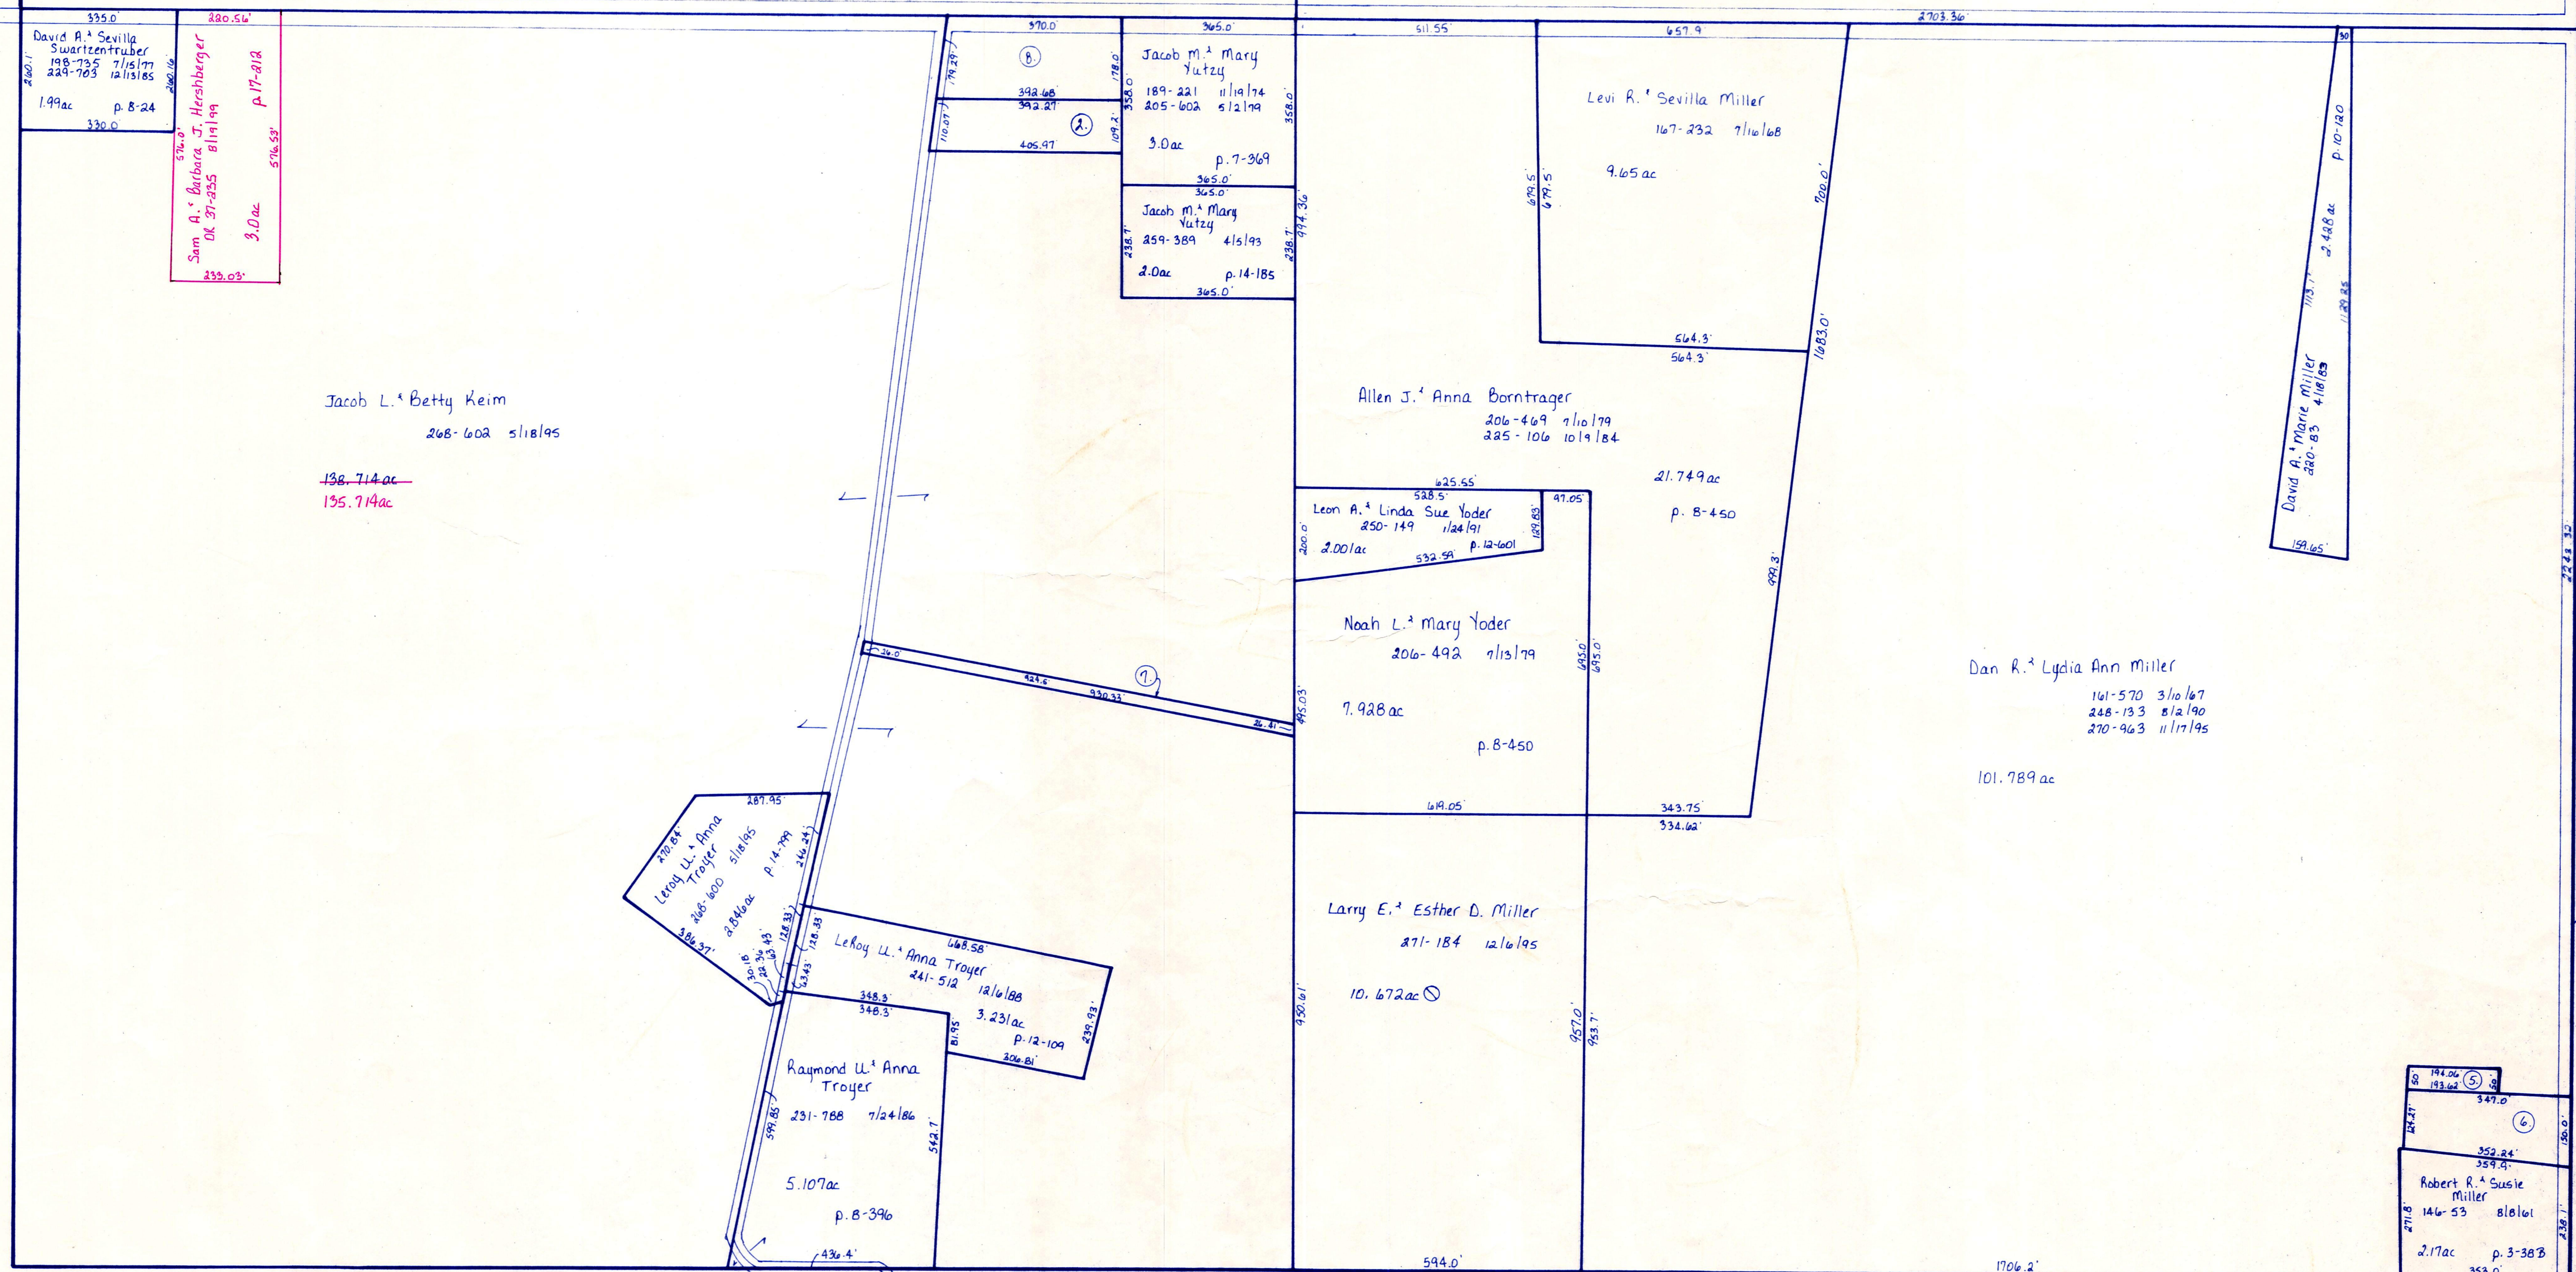

T.H. 615
Old T.H. 230
30' R/W

S.R. 241
C.H. 77
60' R/W

LET IT BE KNOWN THIS MAP HAS BEEN PREPARED AS A REFERENCE GUIDE TO PROPERTY OWNERSHIP WE BELIEVE THIS INFORMATION TO BE CORRECT AND CURRENT. HOWEVER, IT IS NOT INTENDED FOR ANY LEGAL USE, WHETHER IT BE IN SALES, TRANSFERS, TRADES, LEASES OF ANY TYPE, ETC. AND DO NOT ACCEPT RESPONSIBILITY FOR ERRORS OF ANY NATURE OR OMISSIONS CONTAINED HEREIN.

T-15, R-12, Sec. 35
SALT CREEK TWP.
HOLMES CO., OHIO SCALE: 1" = 200'

SC-29