


TRAIL VILLAGE
WALNUTCREEK
LOT 1, 1st QTR.

T-9 R-5

SCALE · 1" = 100"

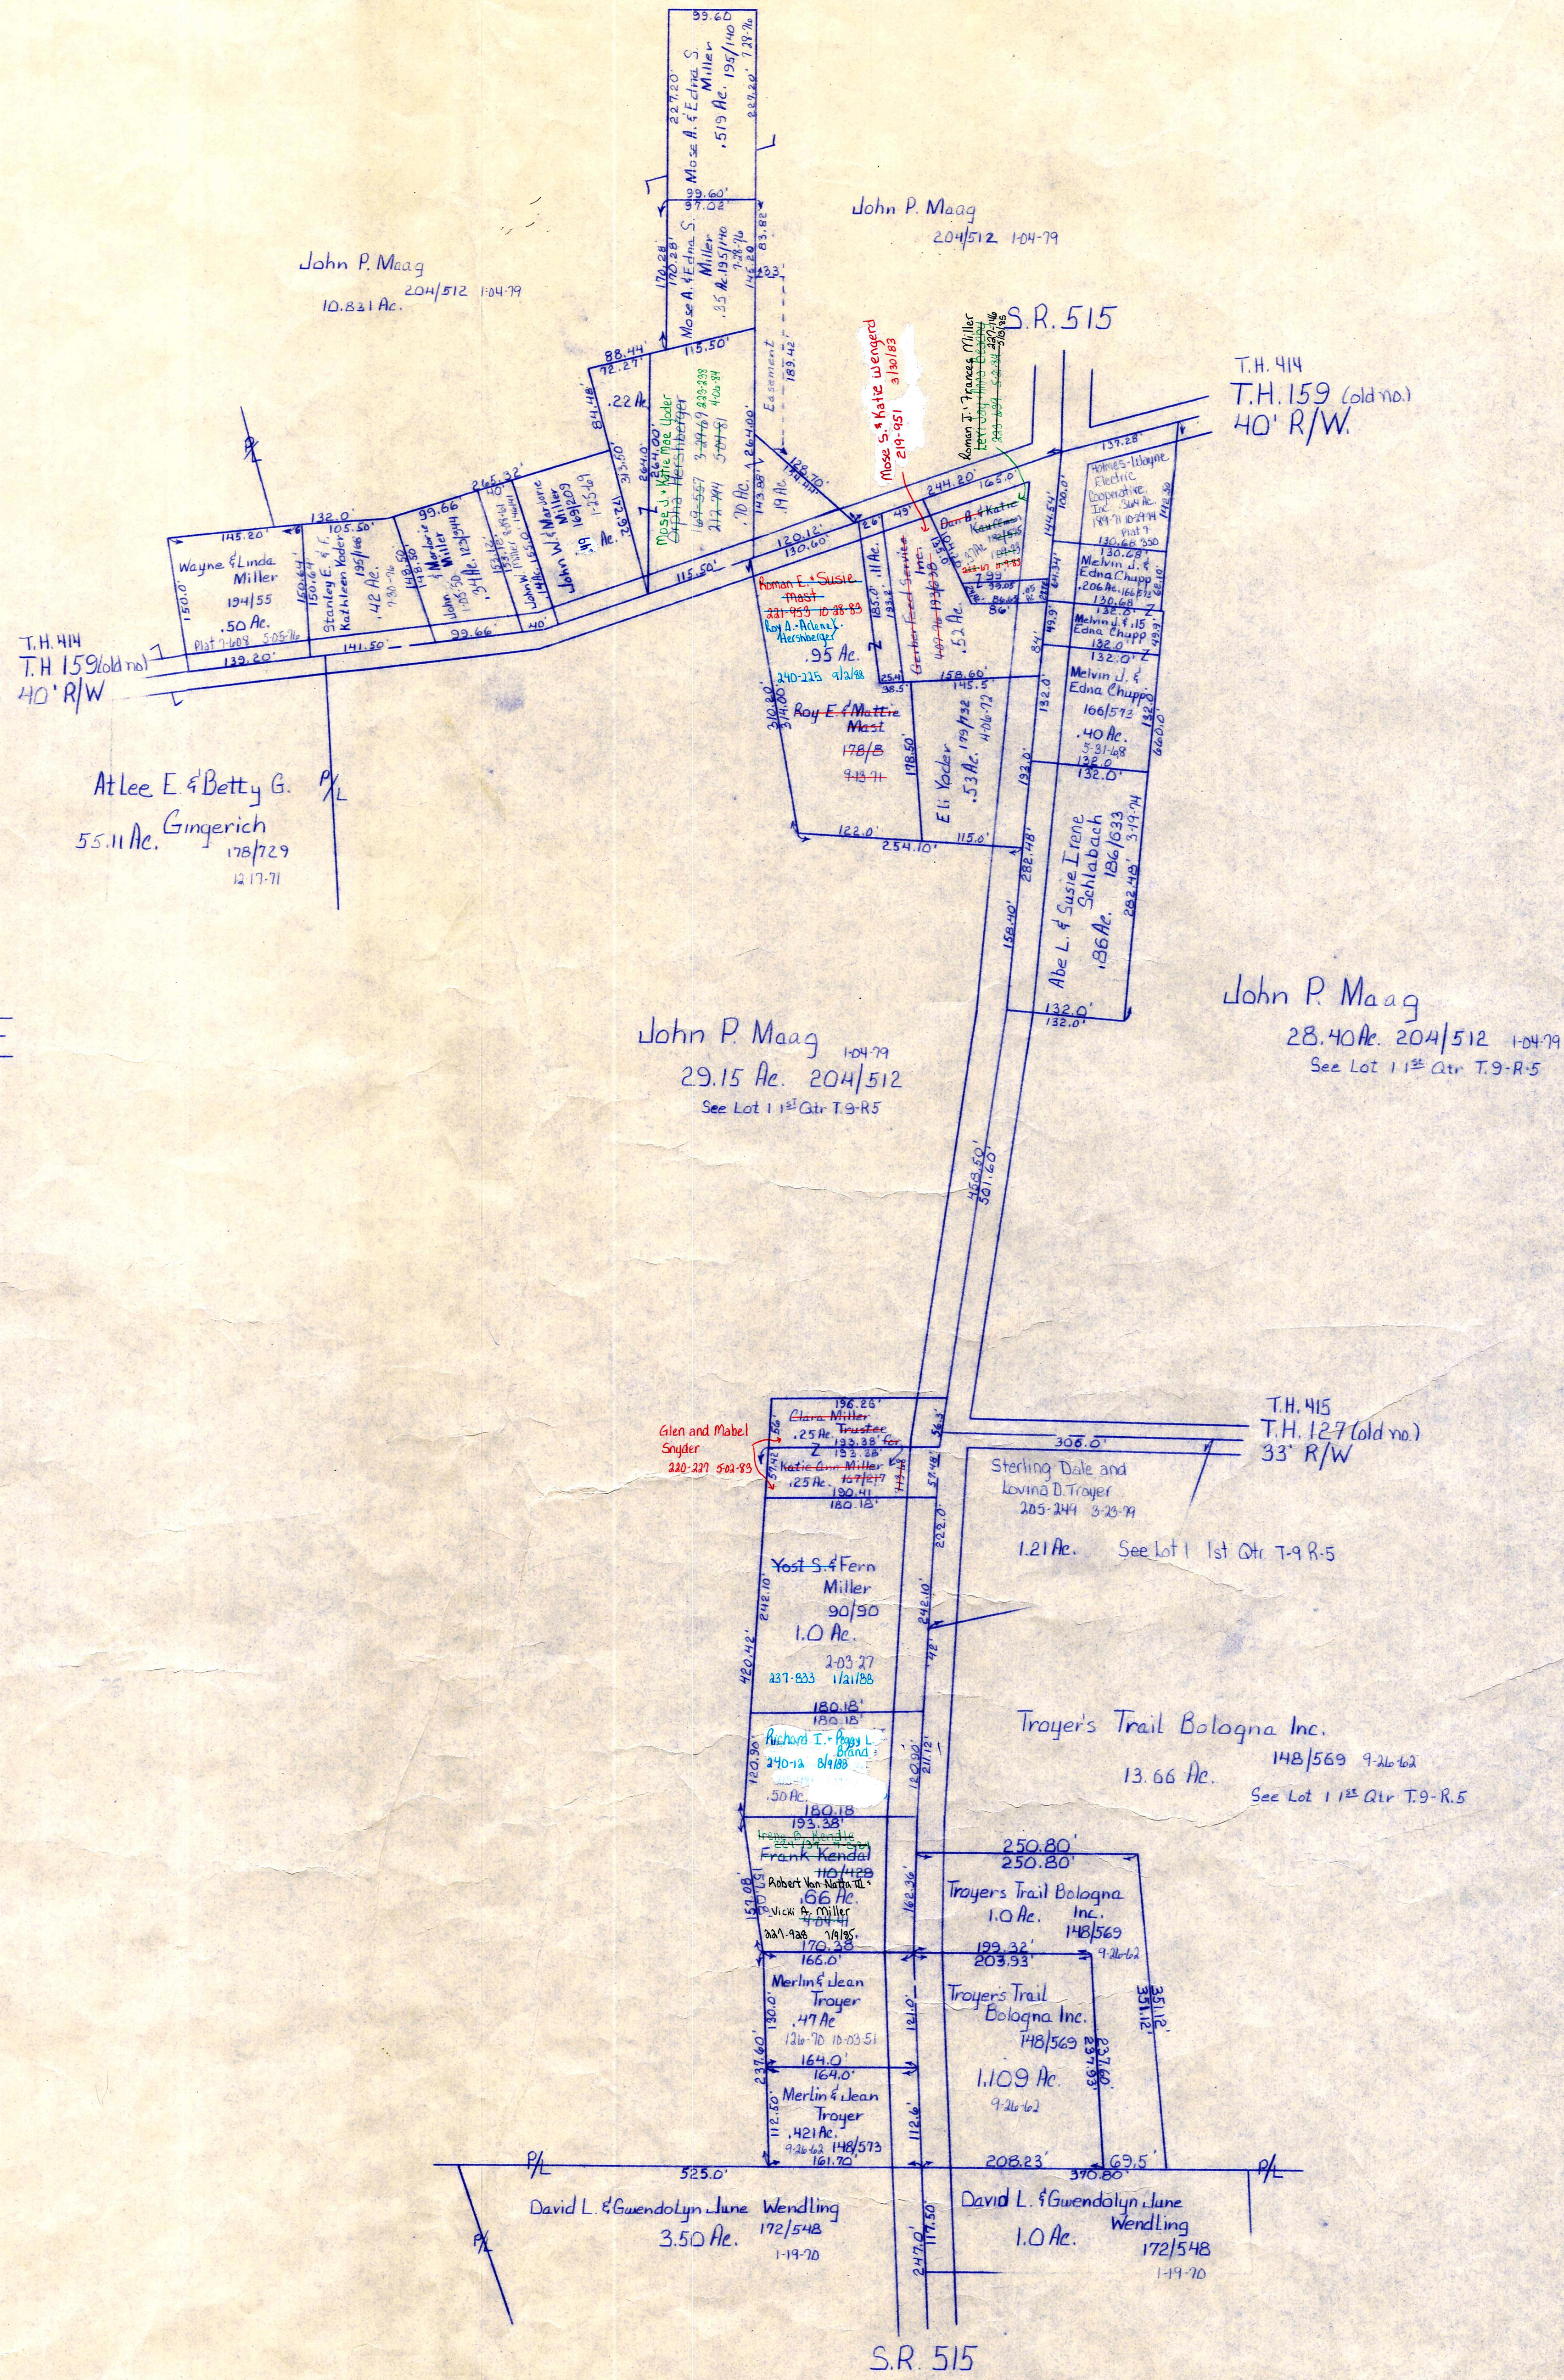

TRAIL VILLAGE

WC
17-A