


T.H. 401 (old no.)
T.H. 401
60' R/W

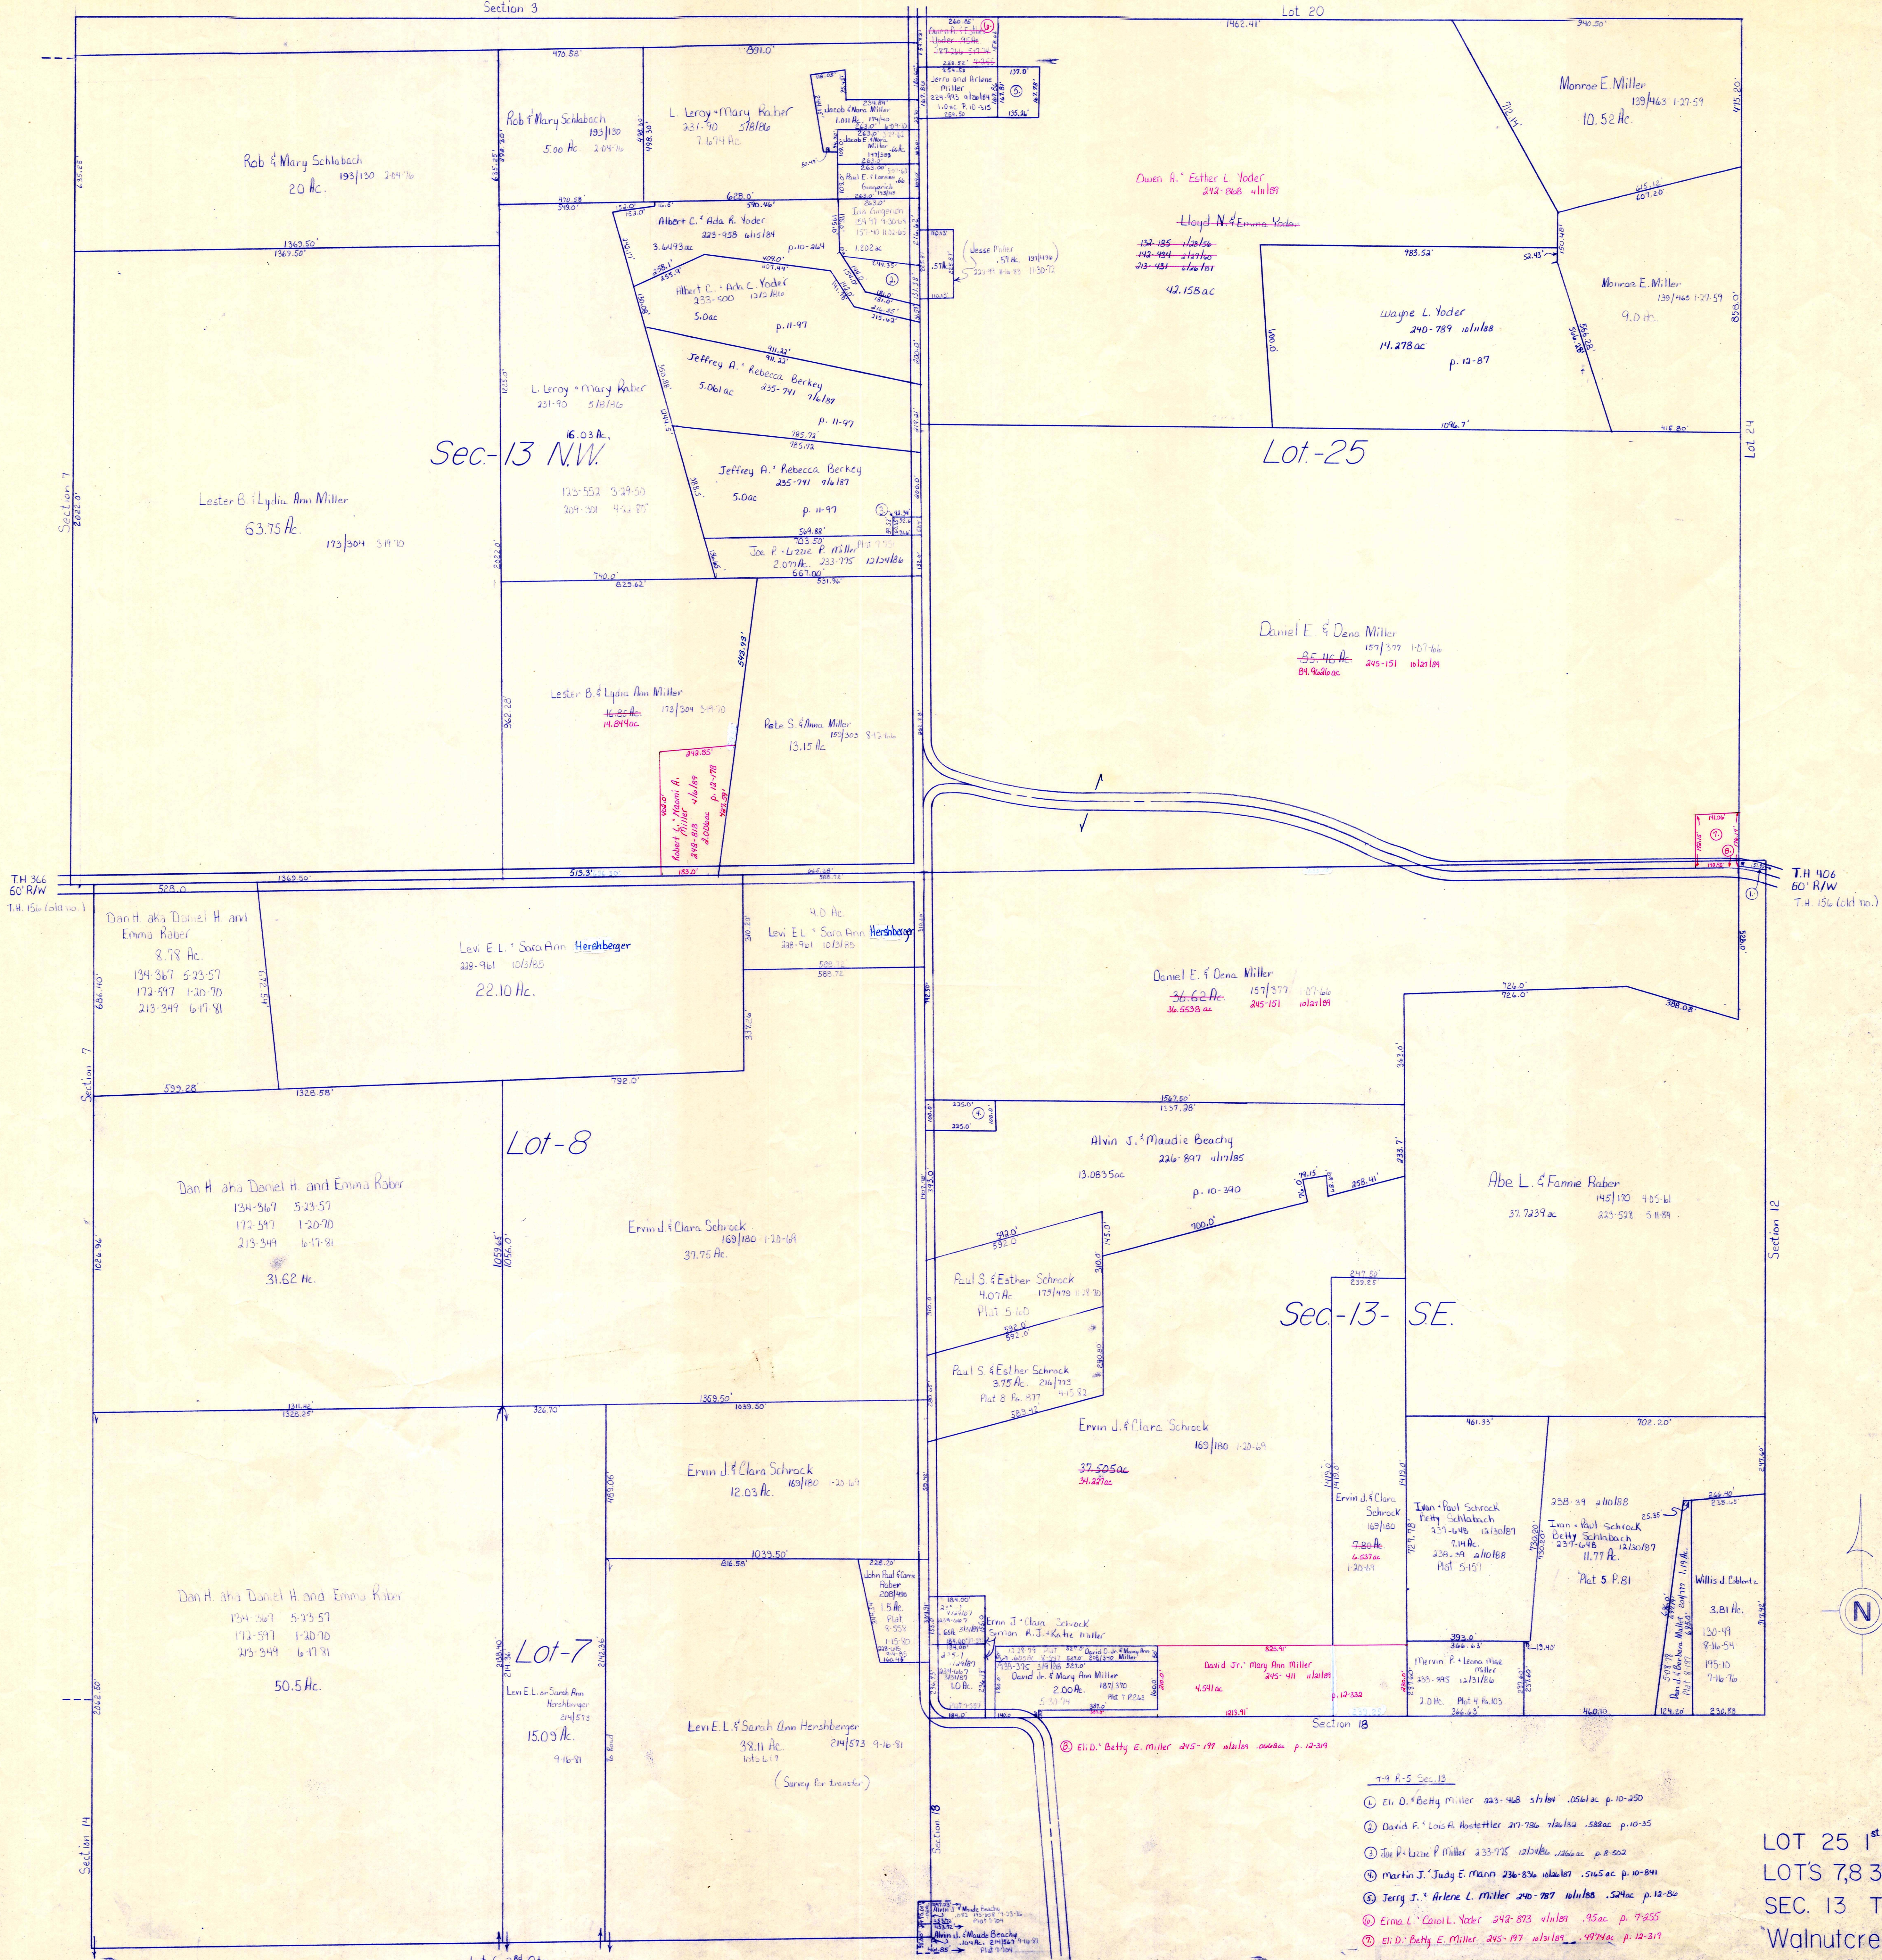

- T-9 R-5 Sec. 13
- ① El. D. & Betty Miller 223-468 sh/181 .0561ac p.10-250
 - ② David F. & Lois A. Hostettler 217-726 76/182 .588ac p.10-25
 - ③ Joe P. & Lizzie P. Miller 233-715 12/186 .250ac p.8-202
 - ④ Martin J. & Judy E. Mann 216-836 16/187 .525ac p.10-841
 - ⑤ Jerry J. & Arlene L. Miller 240-787 16/188 .524ac p.12-80
 - ⑥ Ernie L. & Carol L. Yoder 242-873 4/1181 .95ac p. 9-255
 - ⑦ El. D. & Betty E. Miller 245-197 16/189 .497ac p.12-317

LOT 25 1st Qtr.
LOTS 7, 8 3rd Qtr
SEC. 13 T-9 R-5
Walnutcreek Twp
SCALE 1" = 200'

LET IT BE KNOWN, THIS MAP HAS BEEN PREPARED AS A REFERENCE GUIDE TO PROPERTY OWNERSHIP. WE BELIEVE THIS INFORMATION TO BE CORRECT AND CURRENT. HOWEVER, IT IS NOT INTENDED FOR ANY LEGAL USE, WHETHER IT BE IN SALES, TRANSFERS, TRUSTS, LEASES OF ANY TYPE, ETC., AND DO NOT ACCEPT RESPONSIBILITY FOR ERRORS OF ANY NATURE OR OMISSIONS CONTAINED HEREIN.

WC-3,4