


T.H. 403 40' R/W  
Old T.H. 226

Section 12

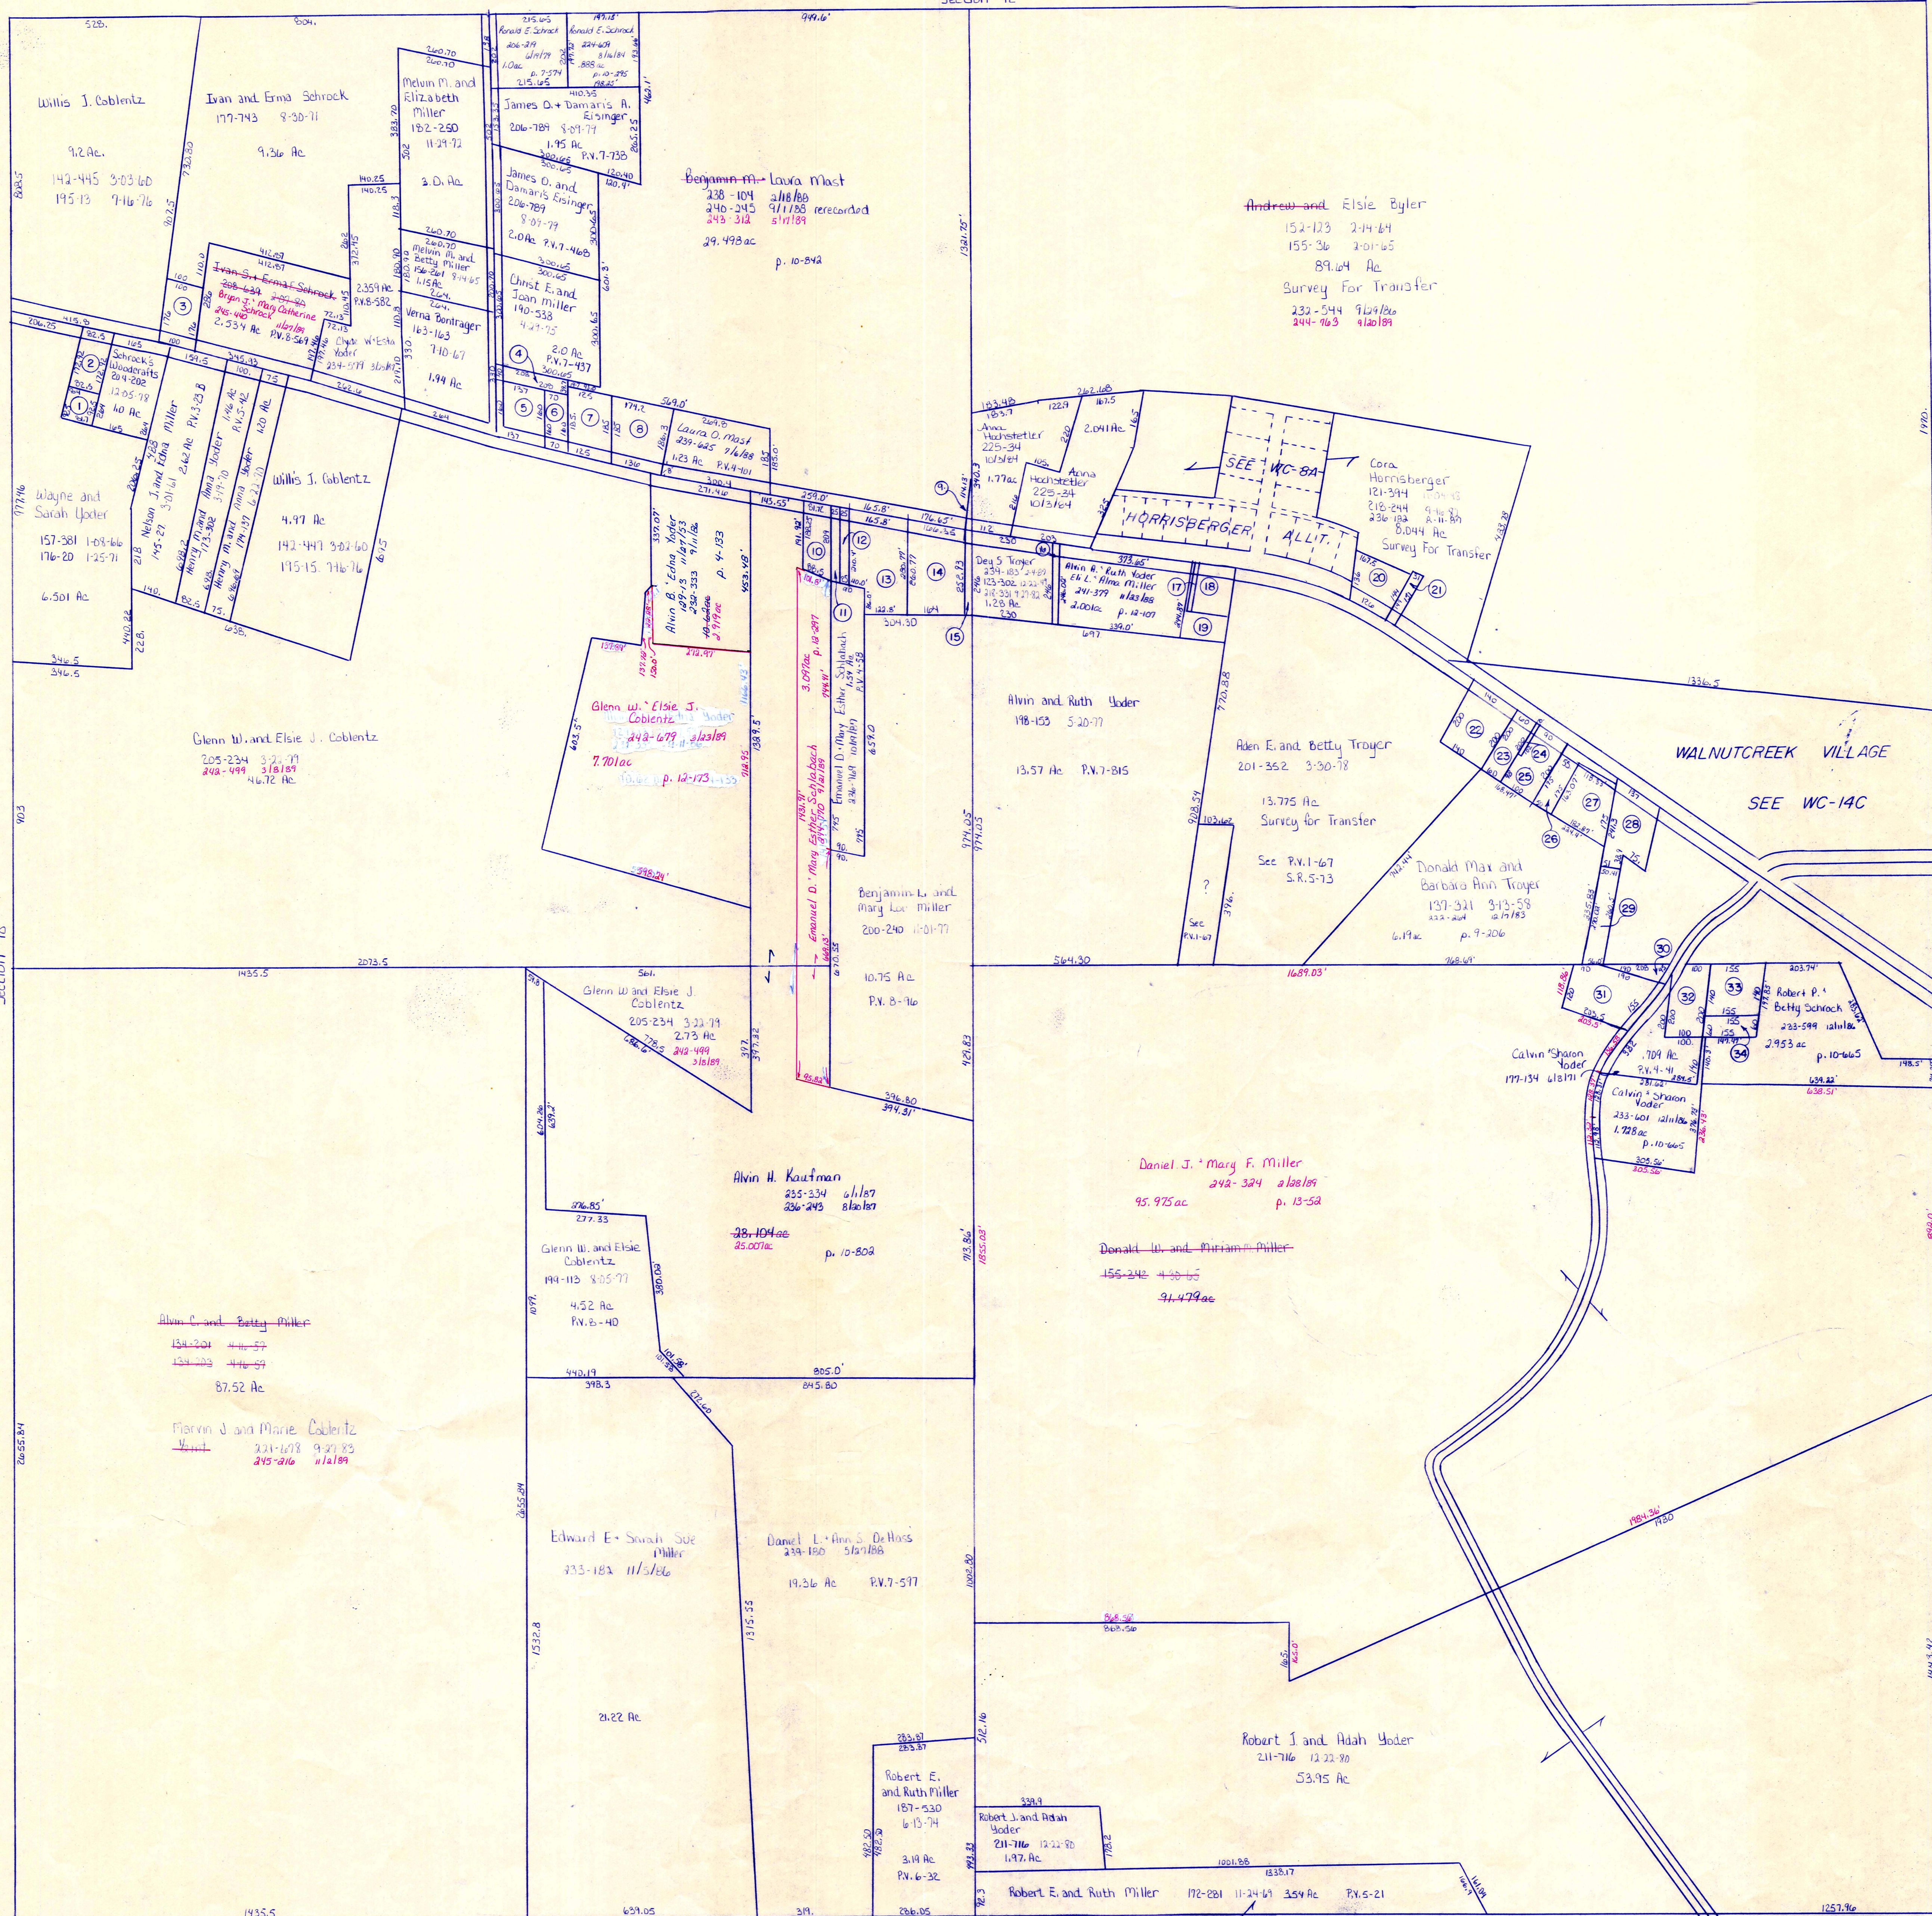

S.R. 39  
See Road  
Plans for R/W

Section 18

S.R. 515  
66' R/W

S.R. 39  
See Road  
Plans  
for R/W

Section 20

Section 22

T.H. 403 40' R/W  
Old T.H. 125

T-9, R-5, Sec. 19  
WALNUTCREEK TWP.

SCALE 1" = 200'

LET IT BE KNOWN, THIS MAP HAS BEEN PREPARED AS A REFERENCE GUIDE TO PROPERTY OWNERSHIP. WE BELIEVE THIS INFORMATION TO BE CORRECT AND CURRENT, HOWEVER, IT IS NOT INTENDED FOR ANY LEGAL USE, WHETHER IT BE IN SALES, TRANSFERS, TRADES, LEASES OF ANY TYPE, ETC., AND DO NOT ACCEPT RESPONSIBILITY FOR ERRORS OF ANY NATURE OR OMISSIONS CONTAINED HEREIN.

WC-8