
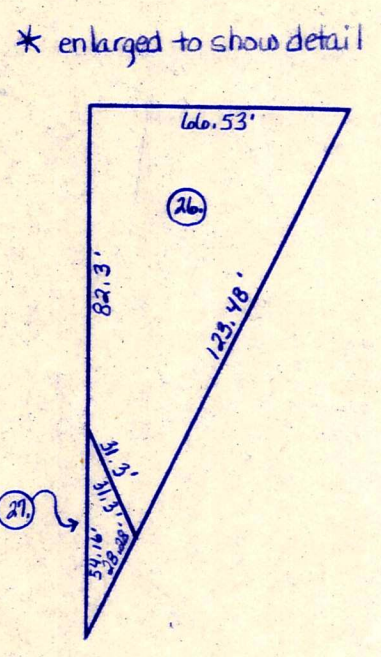


S.R. 515 60' R/W

Section 11

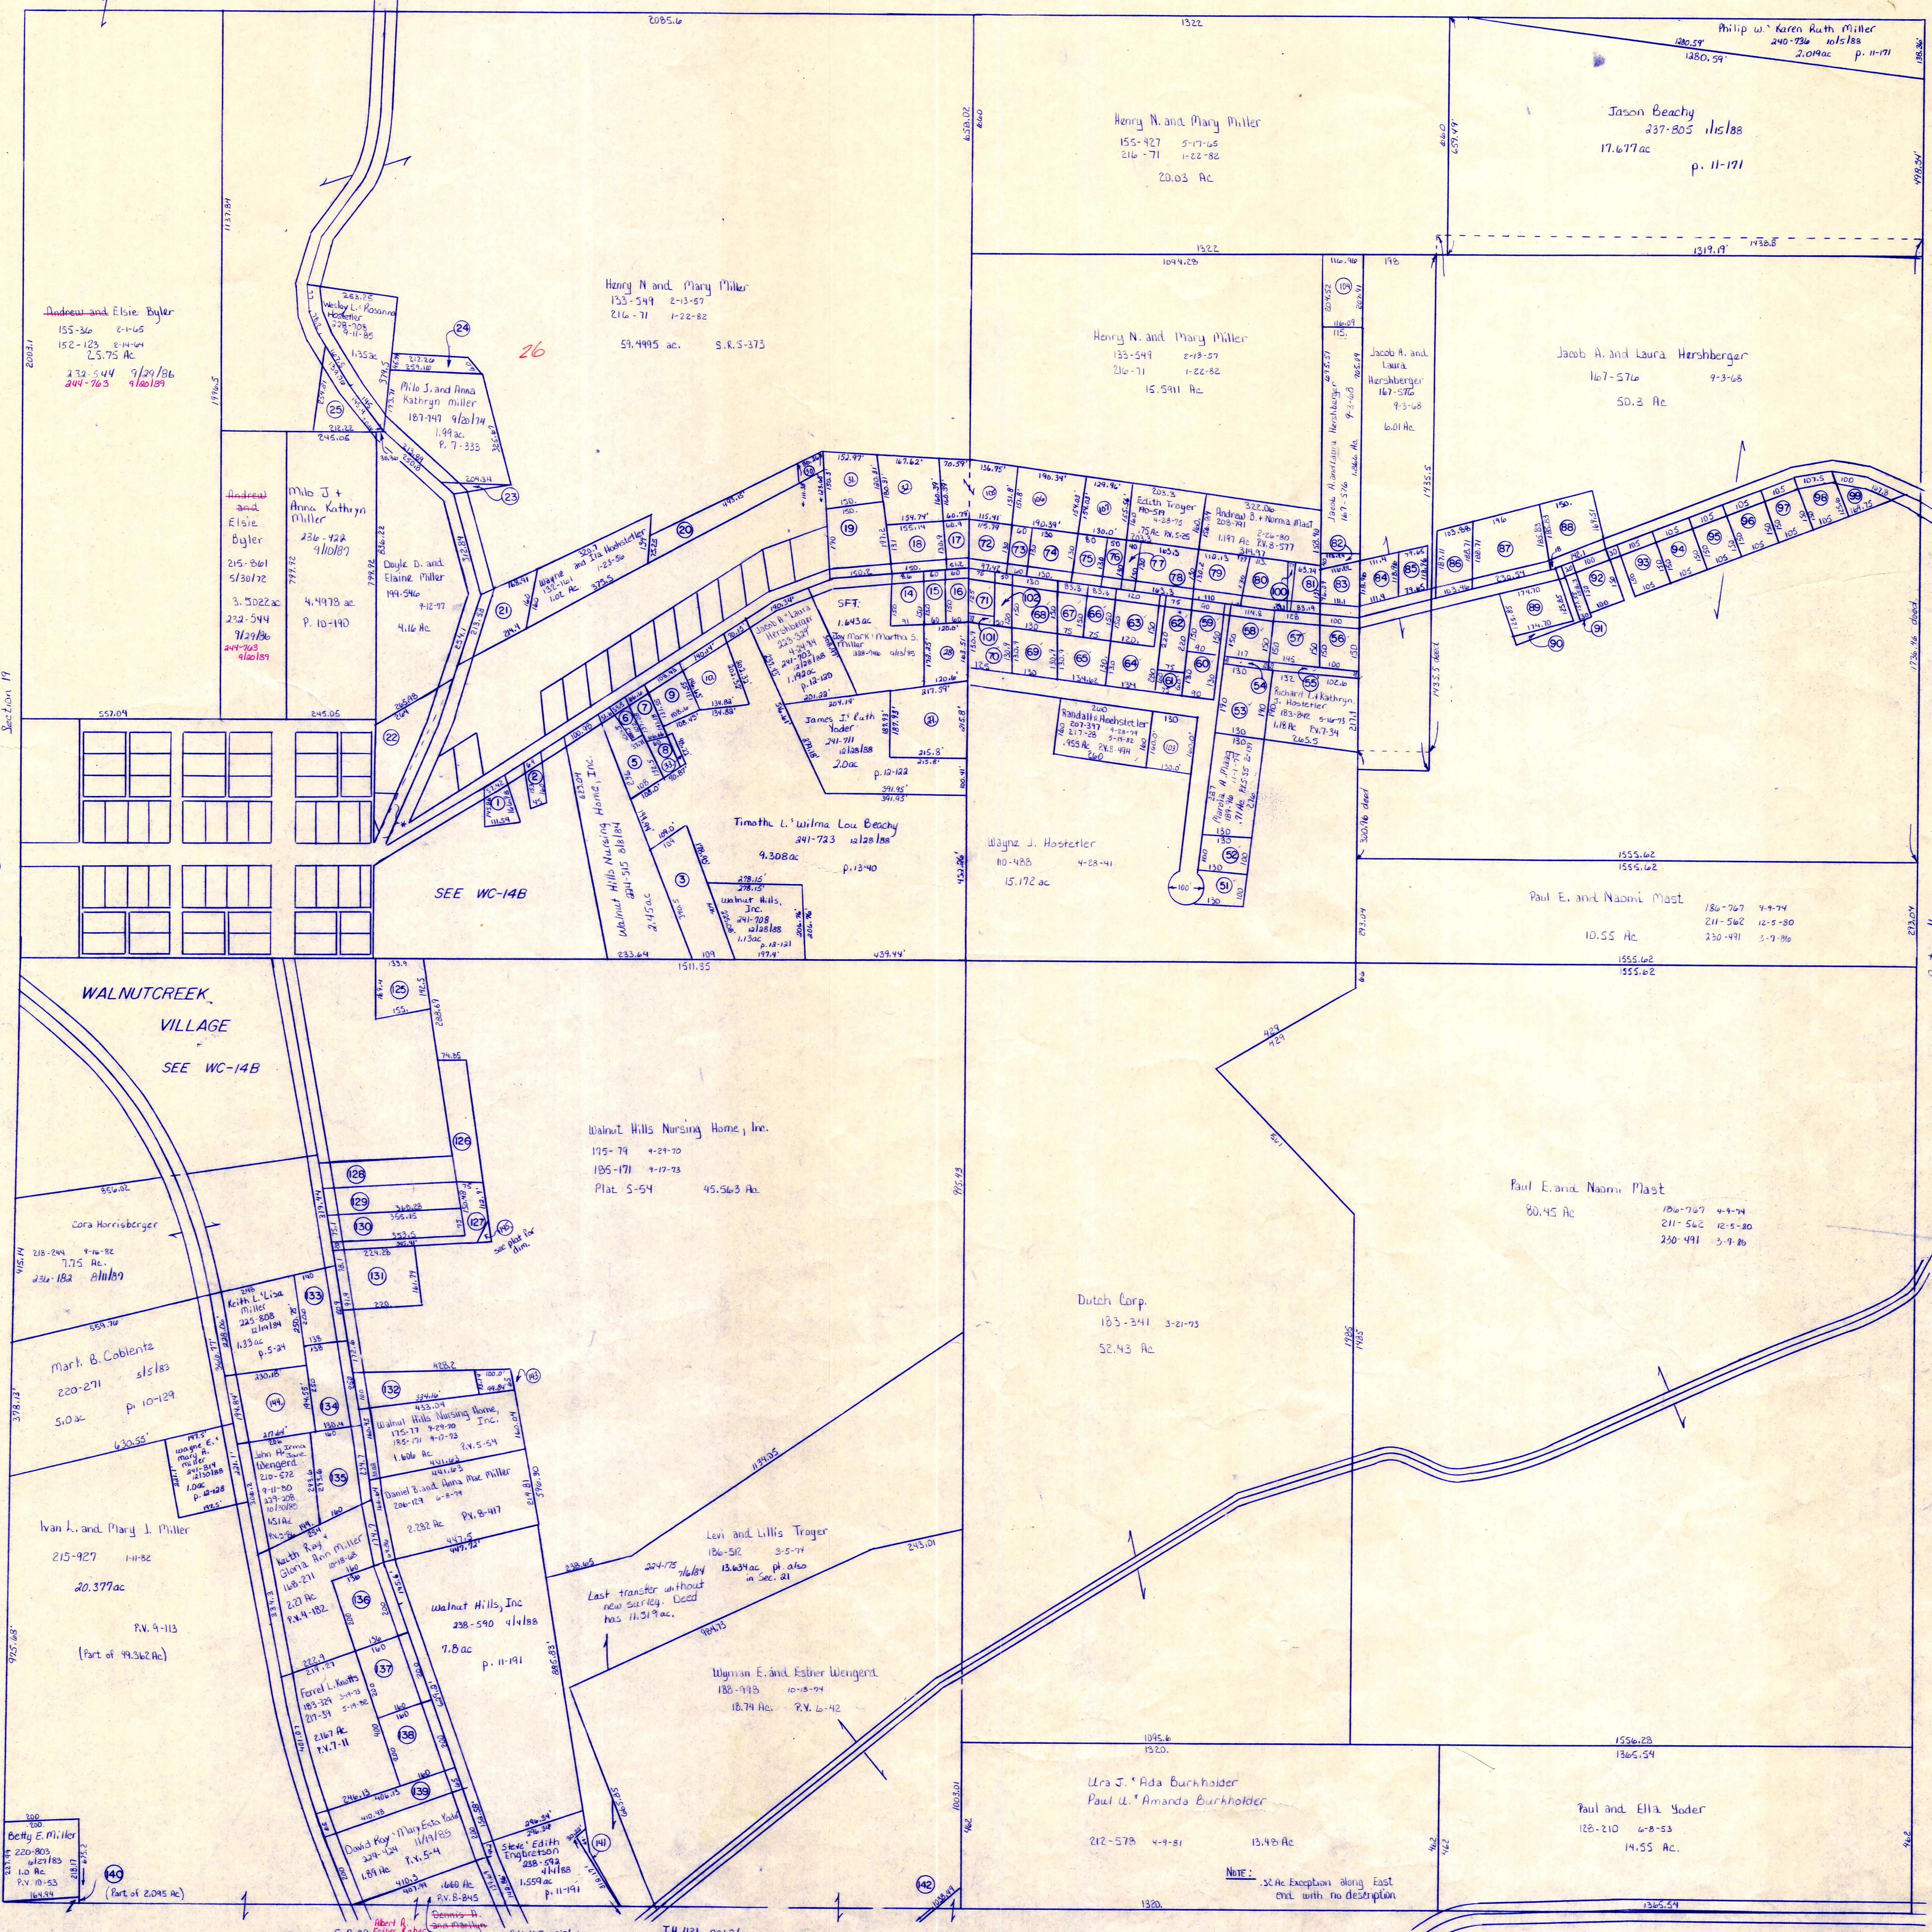

Section 11

S.R. 515 60' R/W

S.R. 39 See Road Plans for R/W

WALNUTCREE VILLAGE SEE WC-14B

Betty E. Miller
200-805
1/21/85
1.0 Ac.
P.V. 01-53
184.00

S.R. 39
See Road Plans
for R/W

C.H. 145 60' R/W
Old C.H. 144A

T.H. 421 30' R/W
Old T.H. 163

Section 21

C.H. 144 60' R/W

T-9, R-5, Sec. 20
WALNUTCREE TWP.

SCALE 1" = 200'

LET IT BE KNOWN, THIS MAP HAS BEEN PREPARED AS A REFERENCE GUIDE TO PROPERTY OWNERSHIP. WE BELIEVE THIS INFORMATION TO BE CORRECT AND CURRENT; HOWEVER, IT IS NOT INTENDED FOR ANY LEGAL USE, WHETHER IT BE IN SALES, TRANSFERS, TRADES, LEASES OF ANY TYPE, ETC., AND DO NOT ACCEPT RESPONSIBILITY FOR ERRORS OF ANY NATURE OR OMISSIONS CONTAINED HEREIN.

WC-14