

T.H. 401
D.H. 111
60' R/W


Sec. 13

S.R. 39
R/W varies
see plans

Berlin Township

C.H. 135
40' R/W


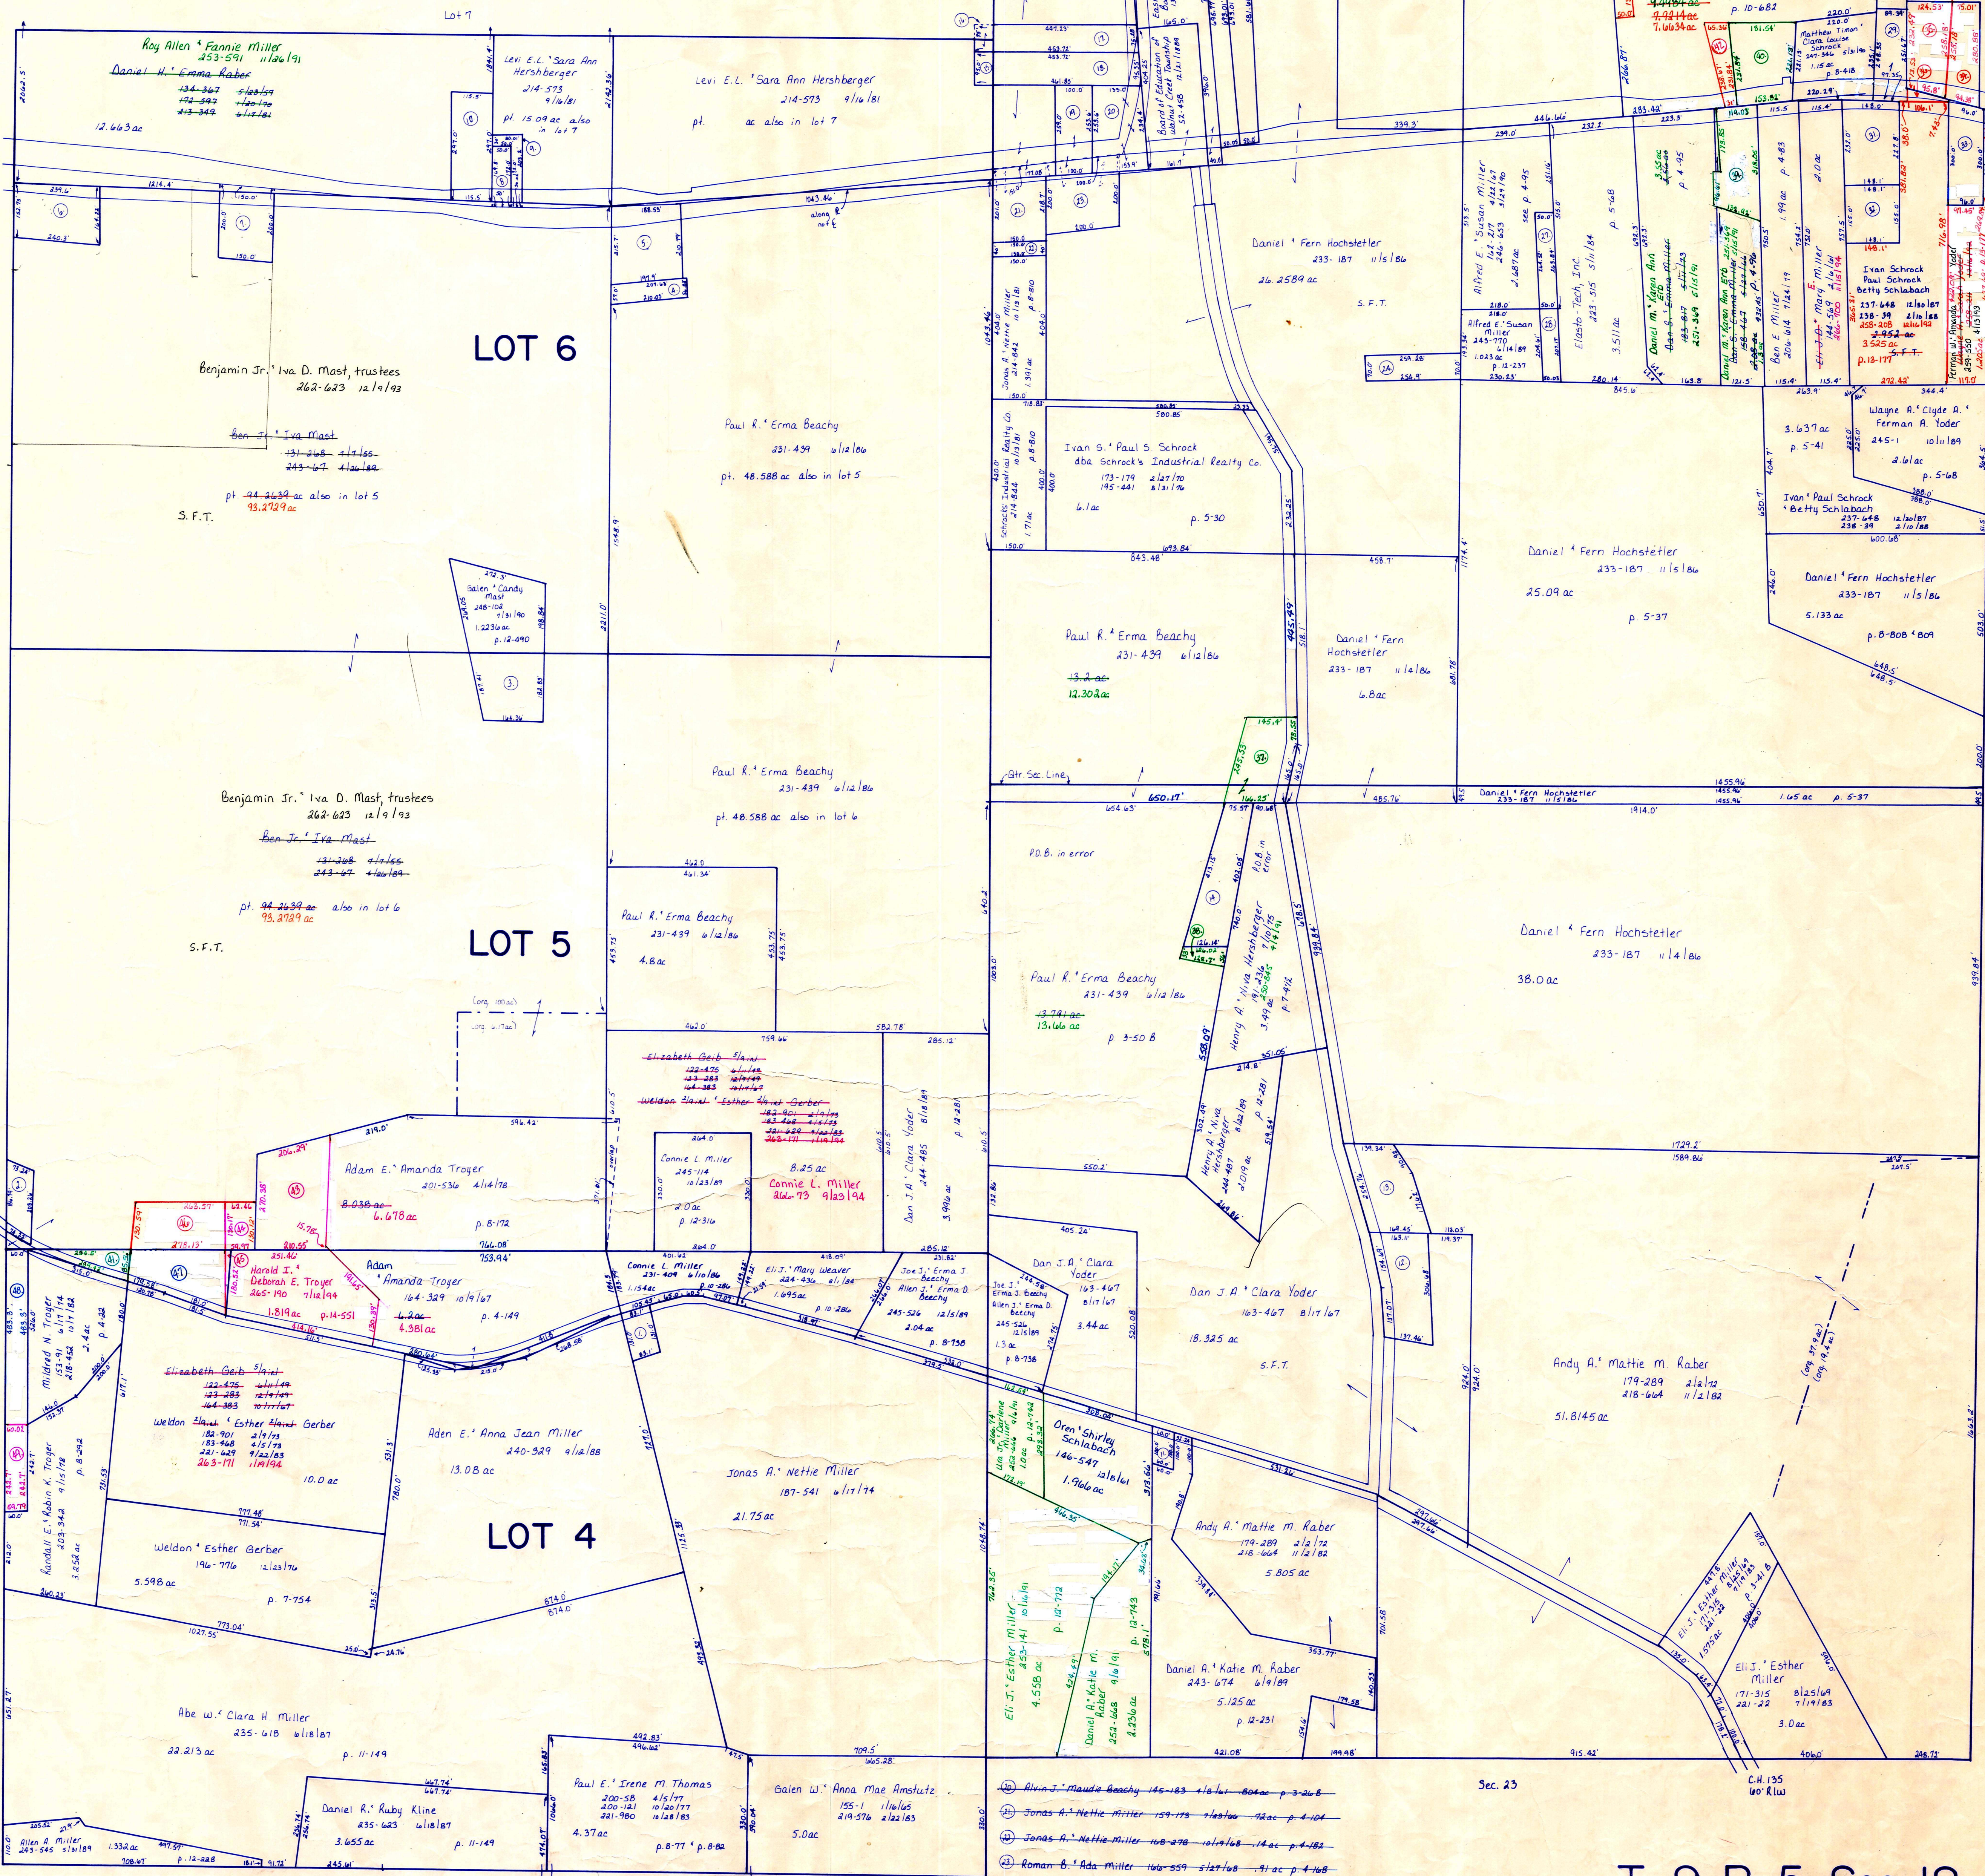

- Lot 5
T-9, R-5, Sec. 18
3rd. qtr. lots 4, 5, 6
Walnut Creek Twp.
HOLMES COUNTY, OHIO

1
N
SCALE: 1" = 200'

PRINTED
3/15/91

WC-2