


T.H. 404
Old T.H. 275
No Etlw

S.E. 179

C.H. 100
No Etlw

C.H. 100
No Etlw

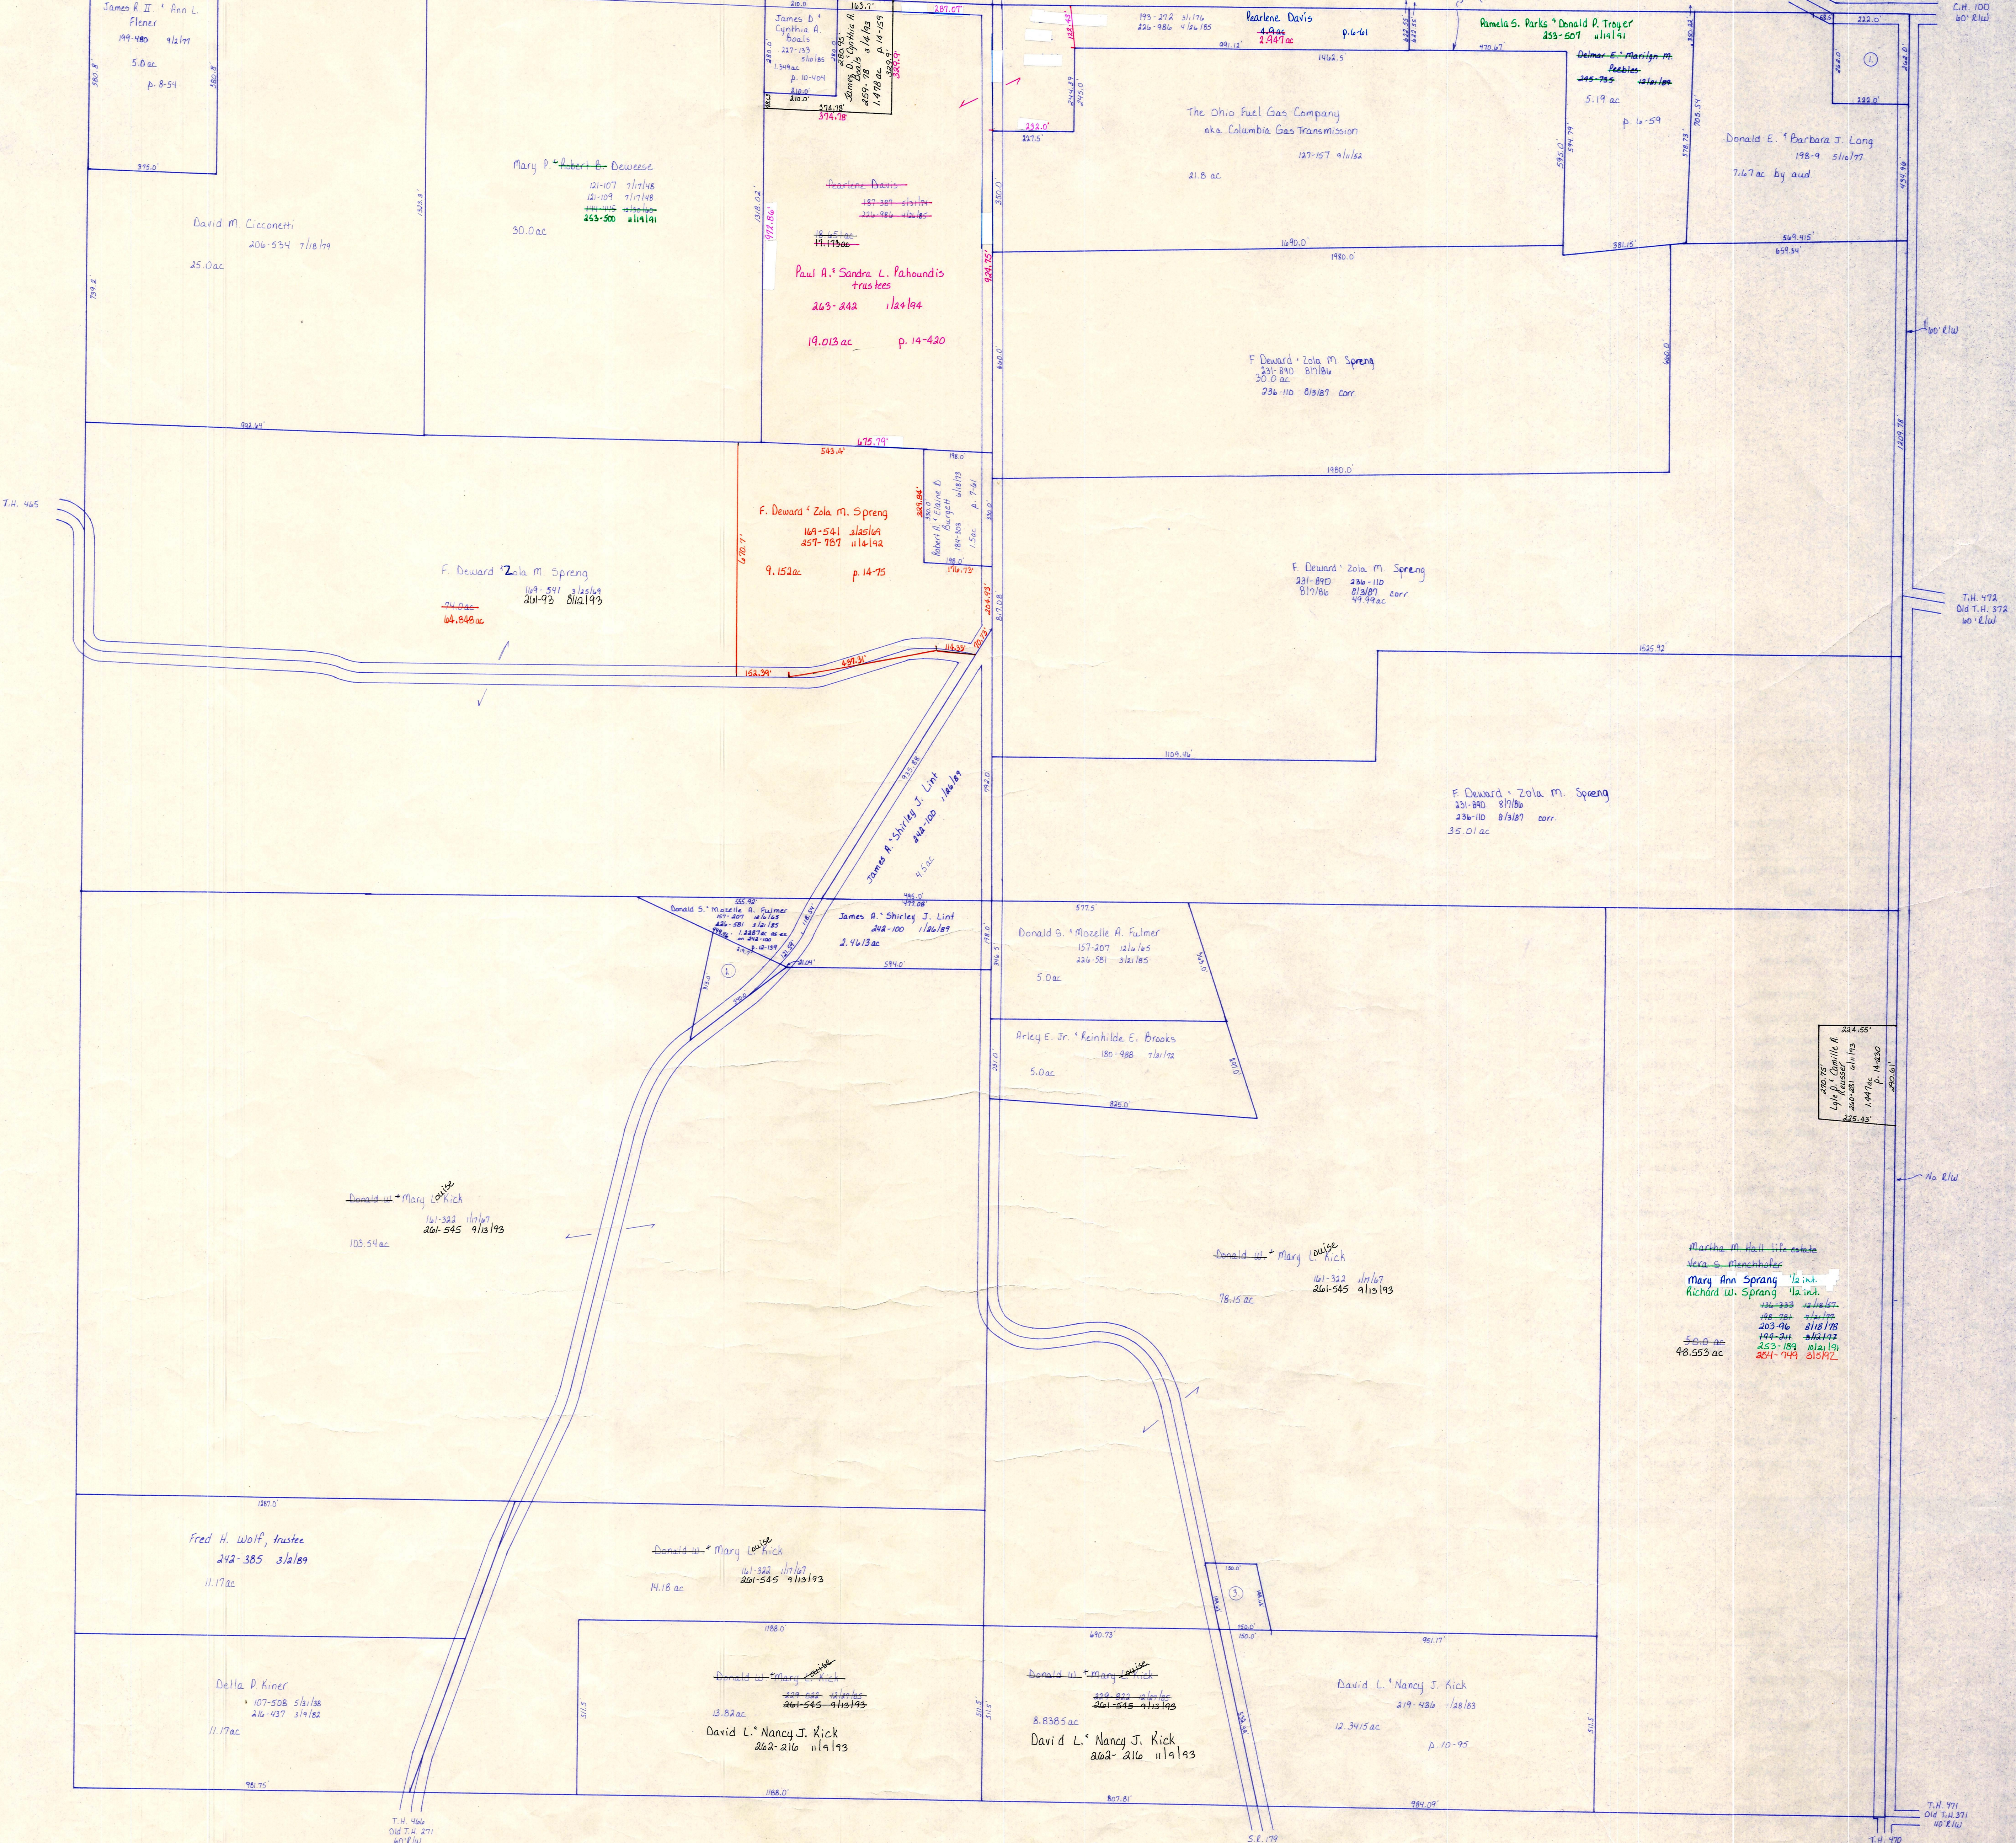

- ① Washington Mutual Insurance Association (see also 67-221-2112) 1338-avenue-18-2-p-7-55
- ② Thomas L. Susan Ben Northville 188-207-5451-77ac p. 7-56
- ③ David Lynn Kick 201-545-1119-17ac p. 8-32

For numbered parcels, see folder

T-20, R-15, Sec. 35
 WASHINGTON TWP.
 SCALE: 1" = 200'

LET IT BE KNOWN, THIS MAP HAS BEEN PREPARED AS A REFERENCE GUIDE TO PROPERTY OWNERSHIP. WE BELIEVE THIS INFORMATION TO BE CORRECT AND CURRENT, HOWEVER, IT IS NOT INTENDED FOR ANY LEGAL USE, WHETHER IT BE IN SALES, TRANSFERS, TRADES, LEASES OF ANY TYPE, ETC., AND DO NOT ACCEPT RESPONSIBILITY FOR ERRORS OF ANY NATURE OR OMISSIONS CONTAINED HEREIN.

W-24