


T.H. 455
Old T.H. 259
No E.A. to int.

Indicate for road
purpose, make them
the way for description
of a corner possibly be
square parcel.

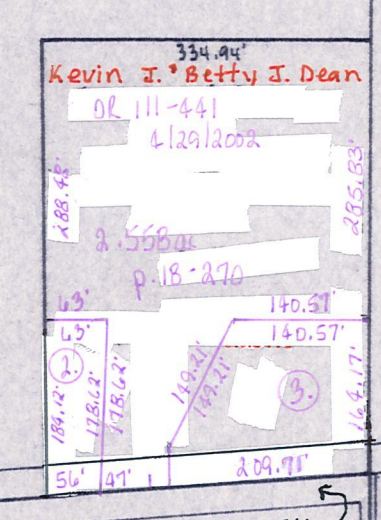

T.H. 454
Old T.H. 260
No E.A. record to int. 452

T.H. 452
Old T.H. 261
30' E.L.

T-19, R-15, Sec. 7
WASHINGTON TWP.
SCALE: 1"=200'

LET IT BE KNOWN, THIS MAP HAS BEEN PREPARED AS A REFERENCE GUIDE TO PROPERTY OWNERSHIP. WE BELIEVE THIS INFORMATION TO BE CORRECT AND CURRENT, HOWEVER, IT IS NOT INTENDED FOR ANY LEGAL USE, WHETHER IT BE IN SALES, TRANSFERS, TRADES, LEASES OF ANY TYPE, ETC., AND DO NOT ACCEPT RESPONSIBILITY FOR ERRORS OF ANY NATURE OR OMISSIONS CONTAINED HEREIN.

W-22