



THOMAS E. FERGUSON
AUDITOR OF STATE
COLUMBUS, OHIO 43216

DEPUTY AUDITORS:

JAMES A. BOLDEN
Administration

RICHARD G. NUSS
CPA
Auditing Division

RUSSELL ROUCH
Management Advising
Service

CERTIFICATION

I, Thomas Aquinas Burke, Supervisor, Land Office of the Auditor of State, duly authorized to perform the duties of the Auditor of State prescribed in Section 115.21 of the Ohio Revised Code, hereby certifies that the enclosed field notes and plats are true copies taken from records in our office. These plats and field notes are for the following townships in the United States Military District:


1. Range 4, Townships 8, 9 and 10
2. Range 5, Townships 8, 9, and 10
3. Range 6, Townships 8, 9, and 10
4. Range 7, Townships 8, 9, and 10
5. Range 8, Townships 8 and 9
6. Range 9, Townships 8 and 9

and in the Ohio River Survey

1. Range 11, Townships 14 and 15
2. Range 12, Townships 14 and 15
3. Range 13, Townships 13 and 14
4. Range 14, Townships 17 and 18
5. Range 15, Townships 19 and 20

Witness my hand and seal of the Office of the Auditor of State, at Columbus, Ohio, this Twentieth-Nine day of November in the year of Our Lord Ninteen Hundred and Eighty-Three (1983).

Thomas Aquinas Burke
Supervisor
State Land Office

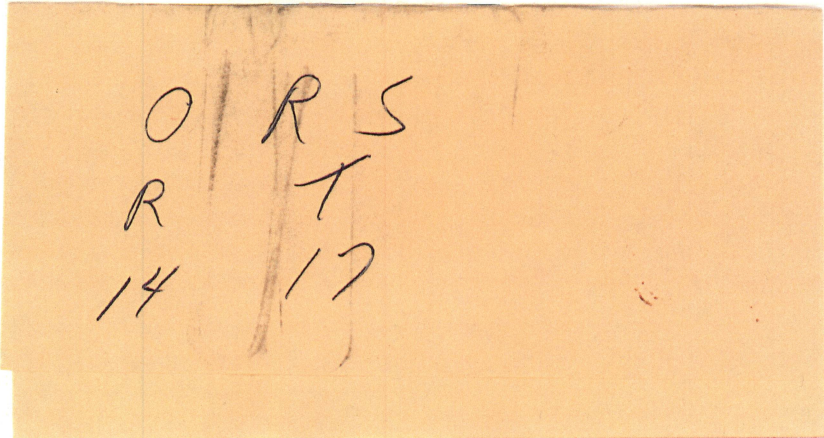

1

Township No. 17, Range No. 14.

Chs. Ms.	May 12 th , 1807.	
South	Between Secs. 1 & 2.	Variation 3° 20'.
29	Cross Drain, E, 6 links.	
17.52	Nickory, 24 ins. diam.	
40.00	Dr. Post, where a W. Oak, 24 ins. diam. bears N. 81 E. 45 links; and a Gum, 14 ins. diam. bears N. 75 W. 9 links distant.	
41.85	W. Oak, 30 ins. diam.	
45.50	B. Oak, 18 ins. diam.	
80.00	Post, where a W. Oak, 10 ins. diam. bears N. 48 E. 16 links; and a Do. 20 ins. diam. bears S. 85 W. 37 links distant. Land, ridgy, rolling, good soil, stony; Timber, W. Oak, B. Oak, Nickory, &c.; last 1/2 Timber considerably destroyed by fire; Undergrowth, Oak, &c.	
East	Random between Secs. 1 & 2.	Var. 3° 20'.
35.00	Cross Run, S, 5 links.	
40.00	Temporary Dr. Post.	
79.06	To Range Line. Fell S. of Post 73 links. Land good soil; Timber, W. Oak, B. Oak, Chestnut, some Maple, Nickory, &c.; rolling in places - stony.	
West	Correct between Secs. 1 & 2.	
	Move Dr. Post to average distance, where a Pin Oak, 14 ins. diam. bears N. 14 E. 18 links; and a R. Oak, 10 ins. diam. bears S. 14 W. 25 links distant.	
76.06	To Post.	
South	Between Secs. 2 & 3.	Var. 3° 20' May 13 th .
21.65	W. Oak, 14 ins. diam.	
39.50	Cross Indian Trace.	

9

Township No. 17, Range No. 14.

6w. 3w.		
40.00	Dr. Post, where a Gum, 6 ins. diam. bears N. 2 1/2 E. 11 links; and a Hickory, 9 ins. diam. bears S. 9 1/2 W. 34 links distant.	
41.31	Cross Run, S. E., 5 links.	
42.52	Cross Run, E., 4 links.	
59.76	B. Oak, 15 ins. diam.	
75.00	Claw	
75.20	Cross Run, E., 3 links.	
79.25	Cross Run, E., 6 links.	
80.00	Post, where a B. Oak, 14 ins. diam. bears S. 16 E. 20 links; and an Claw, 12 ins. diam. bears N. 31 W. 24 links distant. Land, thin soil, very brushy with Oak, Sassafras, &c.; Timber, W. Oak, &c.	
East	Random between Secs. 2 & 11.	Var. 3° 20'.
18.00	To edge of Swamp, on S. side; extensive on N.	
21.30	Cross Do.	
40.00	Temporary Dr. Post.	
74.56	Cross Run, S. E., 20 links.	
79.00	To N. & S. Line. Fell N. of Post 71 lbs. Land flat hilly, good soil; Timber, W. & B. Oak, Chestnut, and some Stony.	
South	Between Secs. 11 & 12.	Var. 3° 20'.
3.50	To East 40 or 50 lbs. is a Spring house, S.	
4.49	Hickory, 12 ins. diam.	
6.07	Cross Run, S. E., 20 links.	
12.60	W. Oak, 24 ins. diam.	
14.80	Cross Run, S. E., 4 links.	
35.86	W. Oak, 48 ins. diam.	
40.00	Dr. Post, where a B. Oak, 16 ins. diam. bears S. 77 W. 11 links; and a B. Walnut, 8 ins. diam. bears S. 58 E. 17 links distant.	

3

Township No. 17, Range No. 14.

Chs. Mks.	
58.80	Cross Run, E., 5 links.
80.00	Post, where a Gum, 11 ins. diam. bears S. $79\frac{1}{2}$ W. 21 links; and a W. Oak, 8 ins. diam. bears N. 82° E. 29 links distant. Land hilly, thin soil, stony, &c.; Timber, W. & B. Oak, Chestnut, Hickory, &c.
East	Random between Secs. 12 & 13. Var. $4^{\circ} 20'$.
27.30	Cross Run, N. E., 5 links.
27.50	Cross Do. S. E.
27.90	Cross Do. N. E.
40.00	Temporary Dr. Post.
54.80	Cross Run, S. E., 20 Mks.
66.30	Cross Run, S., 3 Mks.
78.58	To Range Line. Fell S. of Post 192 links. Land hilly, good soil; Timber, W. & B. Oak, Hickory, &c.; Bushy wood, Huckle, Thorn, Service, Dogwood, &c.
Measure S. on Range Line, between Secs. 12 & 7, from Sec. corner to 1412.	
Set ^{Dr.} Post S. of Ludlow's 54 Mks., where a Gum, 10 ins. diam. bears S. 78° E. 33 links; and a Hickory, 12 ins. diam. bears S. 40 W. 14 Mks. distant.	
Establish Post S. of Ludlow's 192 links, corner to Secs. 12 & 13, where a W. Oak, 14 ins. diam. bears S. $75\frac{1}{2}$ W. 41 links; and a Do. 12 ins. diam. bears N. $40\frac{1}{2}$ E. 33 Mks. distant.	
West Correct between Secs. 12 & 13.	
Move Dr. Post to average distance, where a Hickory, 18 ins. diam. bears S. 19° E. 3 Mks.; and a W. Oak, 10 ins. diam. bears N. $9\frac{1}{2}$ E. 9 Mks. distant.	
78.58	To Post.

Township No. 17, Range No. 14.

Chs. Mts.

- South Between Secs. 13 & 14. Var. 3° 20'.
- 6.34 Cross Run, E., 3 links.
- 32.48 B. Oak, 14 ins. diam.
- 40.00 Dr. Post, where a Gum, 6 ins. diam. bears S. 82° W. 23 links; and a W. Oak, 18 ins. diam. bears N. 72° E. 25 Mts. distant.
- 44.45 Cross Drain, S. E., 3 links.
- 50.64 W. Oak, 40 ins. diam.
- 80.00 Post, where a W. Oak, 28 ins. diam. bears S. 85° E. 10 links; and a Do. 36 ins. diam. bears N. 85° W. 20 Mts. distant. Land hilly, good soil; Timber, W. & B. Oak, Hickory, Alder, Dogwood, Hazel, &c.

East Random between Secs. 13 & 24. Var. 4° 20'.

- 26.00 Cross Run, S. E., 5 links.
- 40.00 Temporary Dr. Post.
- 49.40 Opposite ~~the~~ heads to the S., 25 Mts.
- 73.38 Cross Run, S. E., 3 links.
- 78.00 To Range Line. Fell S. of Post 364 Mts, where a Sugar, 12 ins. diam. bears N. 83½° E. 9 Mts; and a Do. 20 ins. diam. bears S. 55° W. 31 Mts. distant. Land hilly, Rich; Oak, Sugar, Chestnut, Cherry, Hickory, brushy wood, Dogwood, Ironwood, Hazel, Thorn, &c.

- 40.00 Set^{2d} Post on Range Line, S. of Ludlow's Dr. Post 280 links, where a W. Oak, 30 ins. diam. bears N. 77° E. 12 links; and a Dogwood, 4 ins. diam. bears N. 32½° W. 5 links distant.

West correct between Secs. 13 & 24.

Move Dr. Post to average distance, where a W. Oak, 18 ins. diam. bears N. 20° E. 4

Township No. 17, Range No. 14.

6th. Sta.

links; and a Do. 40 ins. diam. bears S. 20 W. 5 links distant.

78.00 To Post.

West Correct between Secs. 2 & 11.

Move Dr. Post to average distance, where a Hickory, 11 ins. diam. bears N. 50 1/2 E. 7 Ms.; and a W. Oak, 40 ins. diam. bears S. 80 W. 37 Ms. distant.

79.00 To Post. May 15th.

South Between Secs. 3 & 4. Var. 3° 20'.

35.70 B. Oak, 24 ins. diam. Through Barrens.

36.60 Cross Run, W., 5 links.

40.00 Dr. Post, where a Hickory, 10 ins. diam. bears S. 78 W. 34 links; and a B. Oak, bears N. 78 E. 49 links distant.

76.91 W. Oak, 24 ins. diam.

80.00 Post, where a B. Oak, 10 ins. diam. bears S. 15 E. 25 links; and a Do. 14 ins. diam. bears N. 28 W. 10 Ms. distant. Land rolling; Timber, W. & B. Oak, chiefly destroyed by fire and otherwise; Undergrowth, Oak bushes.

East Random between Secs. 3 & 10. Var. 2° 50'.

40.00 Temporary Dr. Post, in Barrens; brushy.

63.90 Cross Run, S. E., 6 links.

79.50 To N. & S. Line. Fell 20 Ms. S. of Post. Land rolling, good soil; Timber, W. & B. Oak, chiefly destroyed; Undergrowth, Oak, &c.

South Between Secs. 10 & 11. Var. 3° 20'.

19.64 Gum, 12 ins. diam.

40.00 Dr. Post, in Barrens, where a W. Oak, 20 ins.

Township No. 17, Range No. 14.

Chs. Ths.

	diam. bears N. 26 E. 146 links; and a Do. 15 ins. diam. bears N. 60 E. 115 links distant.	
76.04	W. Oak, 18 ins. diam.	
76.70	Cross Run, S. E., 5 links.	
80.00	Post, where a W. Oak, 36 ins. diam. bears S. 67 W. 32 links; and a Hickory, 12 ins. diam. bears S. 19 1/2 E. 10 links distant. Land good soil; Timber, W. Oak, B. Oak, Hickory, &c.— Some Barrens.	
East	Random between Secs. 11 & 14.	Var. 2° 55'
1.48	Cross Run, S. E., 5 links.	
7.93	Cross Run, S., 10 links.	
25.80	Cross Run, S., 3 links.	
40.00	Temporary Dr. Post.	
79.18	To N. & S. Line. Fell 53 Ms. S. of Post. Land good soil, some hilly; Timber, W. & B. Oak, Hickory, some Chestnut, &c.; Undergrowth, Oak, &c.	
West	Correct between Secs. 11 & 14. Move Dr. Post to average distance, where a Hickory, 26 ins. diam. bears N. 33 W. 2 1/2; and a Do. 9 ins. diam. bears S. 3 1/2 W. 26 links distant.	
79.18	To Post.	
South	Between Secs. 14 & 15.	Var. 3° 20'
8.26	W. Oak, 18 ins. diam.	
13.10	Cross Run, E., 4 links.	
21.25	Cross Spring Run, 20 lks. to head, S.	
40.00	Dr. Sec. Post, where a W. Oak, 16 ins. diam. bears N. 26 E. 26 links; and a Hickory, 10 ins. diam. bears N. 80 W. 47 links distant.	

7

Township No. 17, Range No. 14.

Chs. Sta.	
56.40	Hickory, 10 ins. diam.
59.00	W. Oak, 24 ins. diam.
66.70	Cross Run, S. W. 15 links.
68.50	Cross Do. S. E.
69.10	Cross Do. S. W.
71.60	Cross Do. S. E.
80.00	Post, where a W. Oak, 14 ins. diam. bears S. 19 W. 33 lbs.; and a Crabapple, 12 ins. diam. bears N. 18 E. 53 lbs. distant. Land good soil; Timber, W. Oak, B. Oak, Ironwood, Hickory, Dogwood, &c.; Undergrowth, Dogwood, Hazle, &c.
East	Randow between Secs. 14 & 23. Var. 2° 35'.
2.23	Cross Run, S. E., 15 links.
30.15	Cross Run, S. E., 6 links.
40.00	Temporary Dr. Post.
56.00	Cross Run, S. E., 4 links.
58.00	Cross Run, S., 5 links.
77.50	Cross Drain, S., 4 links.
79.78	To N. & S. Line. Fell 67 lbs. N. of Post. Land good soil; Timber, W. Oak, Cherry, Hickory, &c.; Undergrowth, Dogwood, Ironwood, &c.; Brushy woods, Hazle, Plum, Thorn, &c.
South	Between Secs. 23 & 24. Var. 3° 20'.
1.63	Cross Run, S. E., 4 links.
13.43	To Indian Boundary Line, where a W. Oak, 10 ins. diam. bears S. 5 1/2 E. 38 lbs.; and a B. Oak, 10 ins. diam. bears N. 15 1/2 W. 15 links distant, in Run Bottom. Land as last, &c.
West	Correct between Secs. 14 & 23. Move Dr. Post to average distance, where a

Township No. 17, Range No. 14.

Chs. Mts.

W. Oak, 12 ins. diam. bears S. 27 W. 19 lbs;
and a Do. 8 ins. diam. bears N. 34 E. 21
links distant.

79.78 To Post.

South Between Secs. 22423.

Var. 3° 20'.

7.08 Cross Creek, N. E., 35 links.

16.09 W. Oak, 48 ins. diam.

26.15 To Indian Boundary Line, where a Gum,
12 ins. diam. bears N. 76. 36 links; and a
W. Oak, 26 ins. diam. bears S. 79 W. 22
links distant. Land good soil; Tiaba,
W. Oak, Hickory, &c.; Hazle, Dogwood, Iron-
wood, &c. &c.

West Correct between Secs. 3410.

Move Dr. Post to average distance, where a
W. Oak, 40 ins. diam. bears S. 52 E. 48 links;
and a Do., 16 ins. diam. bears N. 49 W. 25 lbs.
distant.

79.50 To Post.

South Between Secs. 485. May 17. Var. 3° 20'.

1.60 Hickory, 10 ins. diam.

22.00 To East, 20 or 25 links, is a large W. Oak, in
which appears to be bears, and 2 swarm of
bees.

40.00 Dr. Post, where a Hickory, 20 ins. diam. bears
S. 39 E. 25 links; and a B. Oak, 3 ins. diam.
bears S. 60 W. 5 links distant, in Barrens.

74.66 Maple, 14 ins. diam.

80.00 Post, where a B. Oak, 18 ins. diam. bears N.
46 W. 17 links; and a W. Oak, 14 ins. diam. bears
S. 39 E. 34 links distant. Land rolling, good

Township No. 17, Range No. 14.

9

6ths. 1/2.

soil; W. Oak and B. Oak Timber; Mud
growth, Oak, barney.

East Random between Secs. 4 & 9. Var. 2° 50'.

16.60 Cross Run, N. E., 5 lks.

21.34 Run, N., 5 lks.

40.00 Dr. Post, temporary.

76.55 Cross Run, S., 6 links.

78.10 To N. & S. Line. Fell on Post. Land much
as last, Timber, &c.

South Between Secs. 9 & 10. Var. 3° 20'.

14.96 W. Oak, 12 ins. diam.

15.60 Cross Run, W., 4 links.

40.00 Dr. Post, where a Hickory, 14 ins. diam. bears
S. 86 W. 35 links; and a R. Oak, bears N. 82 E. 30
links distant.

42.13 Cross Run, S. E., 10 links.

49.35 Cross Drain, E.

54.30 Cross Drain, E.

66.86 W. Oak, 16 ins. diam.

70.82 Do. 20 ins. diam.

74.64 Cross Run, N. E., 6 links.

80.00 Post, in Barrens, where a Hickory, 10 ins.
diam. bears N. 48 1/2 W. 100 links distant. No.
more trees near. Most of this Barrens, brushy;
some W. and B. Oak Timber.

East Random between Secs. 10 & 15. Var. 2° 40'.

20.40 Cross Run, S., 10 links.

40.00 Temporary Dr. Post.

79.00 To N. & S. Line. Fell 16 lks. N. of Post. Land roll-
ing, good upland; Timber, W. Oak, B. Oak, Hick-
ory, &c.; Ironwood, Dogwood, Hazle, &c.

Township No. 17, Range No. 14.

Chs. Shs

West Correct between Secs. 10 & 15.

Move Dr. Post to average distance, where a
Hickory, 10 ins. diam. bears S. 54 W. 18 links;
and a Maple, 16 ins. diam. bears N. 45 E.
46 links distant.

79.00 To Post.

South Between Secs. 15 & 16.

Var. 3° 20'.

40.00 A Hickory, 9 ins. diam. is corner tree.

39 W Oak, 26 ins. diam.

41.06 W Oak, 26 ins. diam.

53.32 Cross Run, E, 6 links.

53.70 W Oak, 36 ins. diam.

62.40 Cross Creek, East, 35 links.

80.00 Post, where a W Oak, 10 ins. diam. is corner
tree. Land rolling, good soil; Timber, W. & B.
Oak, &c.

East Rindow between Secs. 15 & 22.

Var. 2° 50'.

18.76 Cross Run, N. E., 20 links

19.11 Cross Do. S. E.

20.76 Cross Do. N. E.

31.25 Cross Creek, S. E., 40 links.

33.10 Cross Do. N. E.

39.00 Cross Do. S. E.

40.00 Temporary Dr. Post.

45.00 To Creek, N. E. The creek being high and dif-
ficult to cross, survey as follows:—North 10 chains,
East to—

79.00 To N. & S. Line; S. to Corner, 10.39. Land most
part rich, brushy Bottom; Timber, Oak, Elm, &c.

West Correct between Secs. 15 & 22.

Move Dr. Post to "average distance", where a

11

Township No. 17 Range No. 14.

79.00	<p>Thorn, 9 ins. diam. bears N. 10 1/2 W. 6 links; and a S. Oak, 7 ins. diam. bears S. 65 E. 29 links distant.</p> <p>To Post.</p>
South	Between Secs. 21 & 22. Var. 3° 20'.
11.38	W. Oak, 20 ins. diam.
27.40	Cross Run, N. E., 20 links.
27.95	Cross Do. N. W.
37.50	Cross Do. N. E.
39.33	<p>Indian Boundary Line, where a Sugar, 11 ins. diam. bears S. 30 1/2 W. 15 links; and a Maple, 9 ins. diam. bears N. 55 E. — Rich land, Milly; Timber, W. & B. Oak, Nick- ory, Sugar, Walnut; Alder growth, Dogwood, Ironwood, Hazel, &c; brushy woods.</p>
West	Correct between Secs. 4 & 9.
78.10	<p>Move Dr. Post to average distance, where a Nickory, 10 ins. diam. bears N. 19 W. 4 Ms; and a B. Oak, 18 ins. diam. bears S. 17 W. 46 links distant.</p> <p>To Post.</p>
South	Between Secs. 8 & 9. 18 th May. Var. 3° 20'.
12.70	W. Oak, 40 ins. diam.
40.00	<p>Dr. Post, where a W. Oak, 26 ins. diam. bears S. 64 1/2 W. 89 links; and a Do. 24 ins. diam. bears S. 35 E. 79 links distant.</p>
49.70	W. Oak, 26 ins. diam.
52.30	Cross Run, S. E., 5 links
70.20	W. Oak, 26 ins. diam.
72.50	Cross Run, S. E., 3 links.
80.00	<p>Post, where a W. Oak, 20 ins. diam. bears North 10 links; and a B. Oak, 5 ins. diam.</p>

Township No. 17, Range No. 14.

Sta. 15

Bears S. 28 W. 57 links distant. Sand good soil; W. & B. Oak timber; Undergrowth, Oak brush, &c.

East Random between Secs. 9 & 16. Var. 2° 50'.

19.76 Cross Run, S. E., 8 links.

20.00 Cross Do. N. E.

20.30 Cross Do. S. E., 8 links.

26.70 Cross Run, S., 4 links.

40.00 Temporary Dr. Post.

79.25 To N. & E. Line. Fell S. 62 W. of Post. Sand good soil, most part brushy barrens; Oak, Grape Vines, &c.; some W. & B. Oak timber, &c.

West Correct between Secs. 9 & 16.

Move Dr. Sec. Post to average distance, where a B. Oak, 26 ins. diam. bears N. 57 W. 11 links; and a W. Oak, 24 ins. diam. bears S. 51 E. 39 links distant.

78.25 To Post.

South Between Secs. 16 & 17. Var. 3° 20'.

1.92 Gum, 12 ins. diam.

29.30 To creek Bottom.

35.35 Cross Run, E., 15 links.

36.55 Cross Bottom.

40.00 Dr. Post, where a W. Oak, 12 ins. diam. bears S. 78 E. 16 links; and a Hickory, 4 ins. diam. bears N. 84 W. 12 links distant.

52.85 Cross Run, S. E., 3 links.

56.05 W. Oak, 36 ins. diam.

65.32 R. Oak, 8 ins. diam.

67.70 To head of Spring course, N. E. 15 links.

68.20 Cross Do., N. E.

Township No. 17, Range No. 14.

Chs. Ms.	
75.64	Cross Run, N. E., 6 links.
80.00	Post, where a W. Oak, 8 ins. diam. bears S. 47 E. 11 links; and a W. Oak, 9 ins. diam. bears N. 45 1/2 W. 22 links distant. Land milly, good soil; Timber, Oak, Hickory, Ash, Dogwood, Ironwood, &c.; Grape Vines, &c.
East	Random between Secs. 16 & 21. Var. 3° 20'.
2.48	Cross Run, N. W., 10 links.
40.00	Temporary Dr. Post.
78.00	To N. & S. Line. Fell N. of Post 28 links. Land some milly, good soil; Timber, W. Oak, B. Oak, Hickory, &c.; Ironwood, Dogwood, Sassafras, Grape Vines, &c.
West	Correct between Secs. 16 & 21.
	More Dr. Post to average distance, where a W. Oak, 40 ins. diam. bears N. 54 W. 6 links; and a D. 40 ins. diam. bears S. 30 E. 62 Ms. dist.
78.00	To Post.
South	Between Secs. 20 & 21. Var. 3° 20'.
21.50	Cross Run, N. E., 20 links.
32.14	W. Oak, 16 ins. diam.
35.10	W. Oak, 36 ins. diam.
40.00	Dr. Sec. Post, where a Hickory, 14 ins. diam. bears S. 40 W. 25 links; and a W. Oak, 36 ins. diam. bears N. 20 E. 41 links distant.
53.00	Set a Post, no Boundary Line to be seen, being on a stony point. Timber destroyed by fire; where a Chestnut, 26 ins. diam. bears N. 41 E. 90 links distant. First 1/2 rich rolling land; Timber, W. Oak, and Ash, Maple, &c. — some meadow ground.

Township No. 17, Range No. 14.

	6ths. Lks.		
South	Between Secs. 5 & 6.		Var. 3° 20'.
30.00	Cross Run, W., 3 links.	May 20.	
7.8.25	B. Oak, Pin Oak, 8 lbs.	Chain is 75 lbs. short.	
40.00	Dr. Post, where a W. Oak, 8 ins. diam. bears N. 54½ W. 18 links; and a B. Oak, 20 ins. diam. bears N. 51 E. 9 links distant.		
10.1.29	B. Oak, 18 ins. diam.		
12.9. "	Cross Run, W., 4 links.		
80.00	Post, where a Hickory, 11 ins. diam. bears N. 41 W. 12 links; and a B. Oak, 16 ins. diam. bears S. 70 E. 19 links distant. Land, 1 st part most hilly barrens, brushy; 2 ^d , good soil, rolling; Timber, W. & B. Oak, &c.		
South	Between Secs. 7 & 8.		Var. 3° 20'.
" 3.3	Gum, 12 ins. diam.		
1.8.00	Cross Run, N. E., 4 links.		
40.00	Dr. Post, where a W. Oak, 28 ins. diam. bears N. 30 E. 31 links; and a Do. 28 ins. diam. bears S. 43 W. 48 links distant.		
4.6.15	Chestnut, 12 ins. diam.		
12.7.32	Do. 24 ins. diam.		
13.6.25	Cross Spring Drain, E., 3 links.		
15.8.42	B. Oak, 24 ins. diam.		
80.00	Post, in edge of barrens, where a B. Oak, 18 ins. diam. bears N. 96. 81 lbs.; and a Do. 20 ins. diam. bears N. 42 W. 46 lbs. distant. Land good soil; W. & B. Oak timber, rolling; Brushy with Grape Vines, Oak, &c.		
East	Random between Secs. 8 & 17.		Var. 9° 50'.
7.4.40	Cross Run, S., 5 links.		
40.00	Unspray Dr. Post.		
8.8.30	Cross Run, S., 5 links.		

Township No. 17 Range No. 14.

6 hrs. 30	
79.58	To N. & S. Line. Fell N. of Post 55 links. Land Brushy; Timber, W. & B. Oak, &c.; Undergrowth, Oak, Grape Vines, &c.; rolling.
West	Correct between Secs. 8 & 17. Move Dr. Post to average distance, where an Elm, 9 ins. diam. bears South 18 links; and a Hickory, 10 ins. diam. bears N. 43 & 13 links distant.
78.58	To Post.
South	Between Secs. 17 & 18. Var. 3° 20'.
5.6.30	W. Oak, 30 ins. diam.
7.5. "	Cross Drain, E., 2 links.
7.7.30	Cross Run, E., 4 links.
40.00	Dr. Post, where a B. Oak, 16 ins. diam. bears N. 55 W. 36 links; and a Chestnut, 7 ins. diam. bears S. 40 E. 36 links distant, by edge of a brushy ridge.
80.00	Post in brushy ridge, where a B. Oak, 7 ins. diam. bears S. 76 E. 48 links; and a Do. 6 ins. diam. bears S. 43 W. 19 links distant.— Land good soil, ridgy and exceedingly brushy with Oak, Grape Vines, Hickory, &c.; 1 st 1/2 some W. & B. Oak timber, &c.
East	Raidora between Secs. 17 & 20. Var. 2° 30'.
2.0.30	Cross Drain, N. E., 2 links.
40.00	Temporary Dr. Post, in barren, brushy ridge.
11.7.15	Cross Drain, N., 2 links. Cross Do. Do. Do.
79.19	To N. & S. Line. Fell N. of Post 20 links. Land good soil, most part brushy ridges.

Township No. 17, Range No. 14.

Chs. Lks.

West Correct between Secs. 17 & 20.

Move Dr. Post to average distance, where a W.
Oak, 18 ins. diam. bears N. 36.59 links; and
a Do. 24 ins. diam. bears N. 576.72 the dist.

79.19 To Post.

South Between Secs. 19 & 20.

Var. 3° 15'

4.9.32 W. Oak, 28 ins. diam.

7.0.00 Through the brushy ridge to timber land.

110.00 Dr. Post, where a B. Oak, 15 ins. diam. bears
S. 326.2 links; and a Do. 26 ins. diam. bears
N. 58 W. 16 links distant. This $\frac{1}{2}$ exceeding

brushy, White Oak and Grape Vines.

8.8.00

cross Run N. E. 4 lks.

11.7.00 B. Oak, 24 ins. diam.

12.2.18 Cross Drain, N. E., 6 links.

12.9.18
64.18

To Indian Boundary Line, where a Hickory,
12 ins. diam. bears N. 36.49 lks.; and a Gum,
11 ins. diam. bears S. 35 $\frac{1}{2}$ W. 55 links distant.
Land thin soil; Timber, W. & B. Oak, Hicko-
ry, &c.; Sassafras, Dogwood, &c.

West To Range Line between Secs. 18 & 19. Var. 3° 20'

40.00 Dr. Post, in brushy barren ridge; no timber
for bearings; on side of stony ridge.

10.8.35 B. Oak, 15 ins. diam. Through the barrens.

11.3.47 W. Oak, 12 ins. diam.

12.3.44 B. Oak, 30 ins. diam.

13.4.12
66.62

To Range Line. Fell S. of Post 10.8 links, where
a Gum, 11 ins. diam. bears N. 50 E. 27 links;
and a B. Oak, 11 ins. diam. bears S. 67 W. 31
links distant. Thin soil; Timber, W. Oak,
B. Oak, &c.; Stony, &c., and brushy barrens.

Township No. 17, Range No. 14.

West - Between Secs. 7 & 18. Var. 2°50'

3-1-24 W. Oak, 12 ins. diam.
5-2-30 Cross Run, N. W., 3 links
7-0-00 Cross Dr. S. W., 4 links.
4-0-00 Dr. Post, where a Hickory, 11 ins. diam. bears S. 69 W. 5 links; and a Dog⁹ 5 ins. diam. bears N. 82 E. 28 links distant.

11-4-42 R. Oak, 16 ins. diam.
13-2-31 To Range Line. Fell S. of Post 51 links, where a W. Oak, 26 ins. diam. bears N. 81 E. 48 links; and an Ash, 10 ins. diam. bears S. 78 W. 36 links distant. Land thinish soil; Timber, W. Oak, R. Oak, Hickory, &c.; 1st part brushy, &c.
65-85

East - Rindow between Secs. 5 & 8. Var. 2°45'

1-2-04 Cross Drain, N., 4 links.
1-9-00 Cross Drain, N. W., 4 links.
4-8-25 Cross Run, 3 Ms., N. W.
4-0-00 Temporary Dr. Post.
11-0-25 Cross Run, N., 5 links.
8-0-32 To N. & S. Line. Fell S. of Post 72 links. Land good soil; Timber, W. & R. Oak, Hickory, some Chestnut, &c.; Brushy woods, Oak, Sassafras, Grape Vines, &c.

West - Correct between Secs. 5 & 8.
Move Dr. Post to average distance, where a W. Oak, 10 ins. diam. bears S. 40 E. 17 links; and a R. Oak, 16 ins. diam. bears S. 45 W. 27 links distant.

8-0-32 To Post,

West - To Range Line, between Secs. 6 & 7. Var. 2°50'
" 7-14 S. Oak, 18 ins. diam.

Township No. 17, Range No. 14.

665. 401.

4.5.12 W. Oak, 30 ins. diam.

2.27 Cross Run, N., 7 links.

40.00 In. Post, where a B. Oak, 24 ins. diam. bears N. 12 E. 11 links; and a W. Oak, 14 ins. diam. bears S. 15 E. 36 links distant.

12.5.01 Chestnut, 15 ins. diam.

13.2.10
65.64 To Range Line. Fell S. of Post 168 links, where a W. Oak, 36 ins. diam. bears N. 73 E. 10 links; and a B. Oak, 36 ins. diam. bears S. 13 W. 21 links distant. Land rolling; Timber, W. & B. Oak, Hickory, Dogwood, &c.; Undergrowth, Sassafras, Hazle, Hickory, Grape Vines, &c.

Surveyed by

Joseph H. Lawwill,

Deputy Surveyor