



THOMAS E. FERGUSON
AUDITOR OF STATE
COLUMBUS, OHIO 43216

DEPUTY AUDITORS:

JAMES A. BOLDEN
Administration

RICHARD G. NUSS
CPA
Auditing Division

RUSSELL ROUCH
Management Advising
Service

CERTIFICATION

I, Thomas Aquinas Burke, Supervisor, Land Office of the Auditor of State, duly authorized to perform the duties of the Auditor of State prescribed in Section 115.21 of the Ohio Revised Code, hereby certifies that the enclosed field notes and plats are true copies taken from records in our office. These plats and field notes are for the following townships in the United States Military District:


1. Range 4, Townships 8, 9 and 10
2. Range 5, Townships 8, 9, and 10
3. Range 6, Townships 8, 9, and 10
4. Range 7, Townships 8, 9, and 10
5. Range 8, Townships 8 and 9
6. Range 9, Townships 8 and 9

and in the Ohio River Survey

1. Range 11, Townships 14 and 15
2. Range 12, Townships 14 and 15
3. Range 13, Townships 13 and 14
4. Range 14, Townships 17 and 18
5. Range 15, Townships 19 and 20

Witness my hand and seal of the Office of the Auditor of State, at Columbus, Ohio, this Twentieth-Nine day of November in the year of Our Lord Nineteen Hundred and Eighty-Three (1983).

Thomas Aquinas Burke
Supervisor
State Land Office

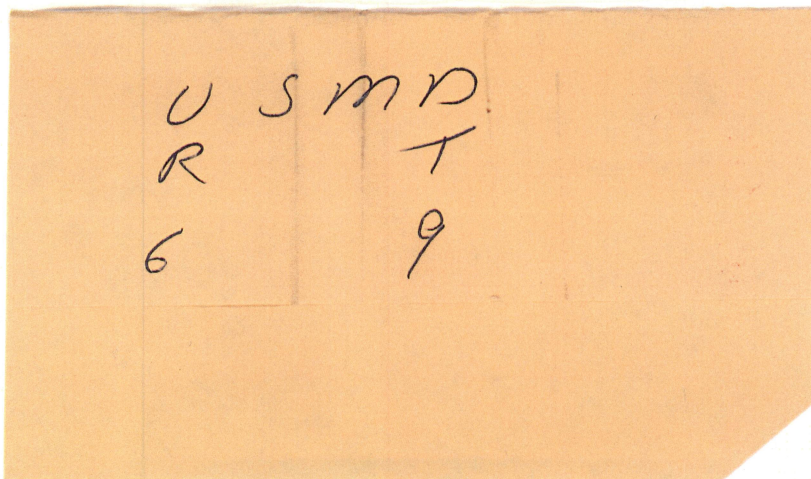

Township 9, Range 6, U.S. Military District, O. 373

CHE LKS

Wednesday, September 7, 1803.

North, on center line through the center of Township 9, on random line - On First Mile.

1.90 A brook 3 links wide - Course N. E.

15.35 A brook 3 links wide - Course N. W.

19.00 A brook 4 links wide - Course West.

43.40 A brook 4 links wide - Course West.

59.50 A brook 5 links wide - Course West.

78.90 A brook 6 links wide - Course West.

80.00 Set Temporary post.

This mile, hilly land - middling soil - Timber, Oak, Hickory, Beech, Maple & Open woods - Last part of the mile, hills more steep and woods more brushy.

North, random, on Second mile.

80.00 Set Temporary post.

This mile, near the top of a dividing ridge - Timber, Oak, much large Chestnut - some Hickory and Maple - Soil middling - Woods open and handsome.

North, random, on Third mile.

47.50 A swampy drain - Course S 60 W.

80.00 Set Temporary post.

This mile, near a dividing ridge. Pretty level land. Timber, Oak and Chestnut - Hickory and Dogwood undergrowth. Soil middling - Woods open.

North, random, on Fourth mile.

80.00 Set Temporary post.

This mile, level land - Open handsome woods, well timbered with Oak, Chestnut and some Hickory, Maple and Walnut. Soil good for grass or grain.

North, random, on Fifth mile.

40.00 A brook 5 links wide - Course N. E.

ch^o 1st

43.50 A brook 3 links wide - course East.

75.20 A drain - course N. E.

77.90 Intersected the North Boundary of this Township 4 chains East of old Section Corner [of Quarter Townships 1 and 2]. Set post at old section corner, from which a B. Oak 24 ins. diam., bears N 79 W. 22 lks distant, and a W. Oak 15 ins. diam., bears N 74 E. 27 lks distant.

25 In running this random line, I ran on a variation of N 0° 50' W, which was parallel with the East Boundary of Township 8; but I intersected too far from the post to blaze on the true line South, by the random line.

This mile, wet land - Timber, Oak, Hickory, Maple and Chestnut. Woods open - level, and soil good for grain or grass.

West, on North Boundary of half Section 6.

15.75 A drain - course N. W.

21.50 A drain - course N. E.

24.00 A brook 4 links wide - course N. E.

40.00 Set Temporary post.

This half mile, low ridges - Timber, W. Oak, Hickory, Maple & Dogwood undergrowth. Soil good for small grain. Fine Chestnut Timber?

South on true line from the old Section corner [of Quarter Townships 1 and 2], on East Boundary of half Section 6.

5.82 A W. Oak 26 ins. diam.

29.55 A Gum 12 ins. diam.

32.40 A drain - course N. E.

35.20 A brook 4 links wide - course East.

50.92 A W. Oak 15 ins. diam.

63.00 A drain - course N. E.

67.35 A W. Oak 14 ins. diam.

chs. 261

77.90 The length of the fifth mile in running North.
To the 4 mile post set on random line, west of
this point - Set post corner of half Sections 6 and
15 - T. 9, R. 6, U. S. Mil.

This mile, level land - Good soil - Lumber, Oak
Hickory, Maple and some Chestnut - Dogwood under-
growth -

This post stands 322 chs. West of temporary
post.

South, on East Boundary of half Section 15.

3.68 A W. Oak 18 ins. diam.

31.86 A B. Oak 18 ins. diam.

41.60 A Chestnut 30 ins. diam.

70.74 A B. Oak 24 ins. diam.

71.50 A drain - Course West.

80.00 To a point West of Third mile post - Set post corner
of half Sections 15 and 26.

This mile, near a dividing ridge - Level land. Lumber,
Oak, Chestnut, some Hickory and Maple. Much Dogwood
undergrowth.

South, on East Boundary of half Section 26.

16.63 A B. Oak 30 ins. diam.

34.00 A swampy drain - Course West.

71.56 A W. Oak 24 ins. diam.

80.00 To a point West of Two mile post - Set post corner
of half Sections 26 and 35.

This mile near a dividing ridge - Lumber, Oak,
Hickory, Much Chestnut, some Gum and Maple - Dog-
wood undergrowth - Soil pretty good - Some Spice bush.

South, on East Boundary of half Sections 35.

23.50 A Chestnut 30 ins. diam.

31.94 A Poplar 40 ins. diam.

51.72 A W. Oak 14 ins. diam.

Ch. 1st

75.39 A W. Oak 18 ins. diam.

80.00 To a point West of First Mile post set on Rainbow line.
Set post corner of half Sections 35 and 46 -

This mile on dividing ridge - Lumber, W. Oak, B. Oak, Chestnut &c. Soil stony in last part of the mile - thin soil generally - Dogwood, undergrowth.

South, on East Boundary of half Sections 46.

1.10 A brook 6 links wide course S. W.

8.50 A W. Oak 30 ins. diam.

20.60 A brook 3 links wide - course E. W.

28.40 A Beech 12 ins. diam.

36.65 A brook 4 links wide - course West.

61.30 A brook 4 links wide - course West.

67.50 A brook 8 links wide - course N. W.

83.90 A brook 3 links wide - course N. E.

85.00 To South Boundary - Here I found there was an out [a distance of five chains] missed in the first mile in running North, which makes all the half mile lines run from this line West, erroneous. [The notes of these lines are consequently not recorded, being struck out by the Surveyor - They are corrected afterward].

This mile, ridge land - Soil middling - Lumber, Oak, Beech, &c. Maple, Ironwood and Dogwood.

Quit for the day. September 7. 1803.

Thursday, September 8th, 1803.

West, on South Boundary of half Section 46.

1.00 A drain - course N. E.

40.00 Set post corner of Sections 23 and 24, from which a Hickory 14 ins. diam. bears N 14 E, 13 links distant, and a Dogwood 10 ins. diam. bears S 64 E N. 28 links distant.

This half mile, ridge land - Lumber, Oak, Chestnut, Hickory, and some maple - Dogwood, undergrowth.

North, between Sections 23 and 24.

Ch^d Sta

- 13.42 A Beech 18 ins. diam.
 14.50 A drain - Course West.
 16.00 A drain - Course S. W.
 31.65 A Chestnut 40 ins. diam.
 60.30 A brook 12 links wide - Course West.
 68.00 A W. Oak 30 ins. diam.
 80.00 Set post corner of Sections 17, 18, 23, 24, from which a
 W. Oak 24 ins. diam. bears N 4 $\frac{1}{2}$ E. 33 links distant, and a
 W. Oak 34 ins. diam. bears S 16 W. 39 links distant.

This mile, ridge land - Lumber, Oak, Beech, Maple,
 and Chestnut - Undergrowths, Ironwood and Dogwoods.
 Middling soil.

Moved the post corner of half Sections 35 and 46. 5
 Chains South, for the one that was missed; from which
 a Sugar 16 ins. diam. bears N 84 W. 26 links distant, and
 a Maple 12 ins. diam. bears S 24 $\frac{1}{2}$ W. 32 links distant.

Thence ran

West, between half Sections 35 and 46.

- 9.00 A brook 6 links wide - Course S. W.
 10.20 A brook 4 links wide - Course South.
 40.35 Intersected the north and south line at post.

This half mile, south side hill, generally - Thin
 soil - Lumber, Oak, Beech, Maple, some Chestnut and
 Gum - Dogwood and Beech undergrowths - Soil stony.

East, Alared the line 0°

North, between Sections 17 and 18.

- 9.55 A brook 4 links wide - Course S. W.
 20.50 A W. Oak 30 ins. diam.
 39.60 A W. Oak 20 ins. diam.
 45.26 A Hickory 12 ins. diam.
 62.00 A brook 4 links wide - Course West.
 80.00 Set post corner of Sections 13, 14, 17, 18, from which
 an Elm 12 ins. diam. bears S 57 E. 22 links distant, and

chs. Sta.

a Chestnut 24 ins. diamt, bears S 80 W, 22 links distant.

This mile, high ridges - Very stony - Timber, Oak, Chestnut, Beech, Maple; some Gum and Poplar. Soil poor?

Moved the corner of Half Sections 26 and 35, 5 chains South, from which a Hickory 20 ins. diamt, bears N 14 W, 16 links distant, and a Maple 36 ins. diamt, bears S 24 W, 52 links distant. Thence ran

West, between Half Sections 26 and 35.

40.06 Intersected the North and South line 18 links North of post.

This half mile, on top of high Chestnut and Oak timbered ridge - Some Hickory, Maple and Gum - Dogwood and some Maple undergrowth. Soil pretty good in general - Some stone on the last 10 chains.

North, between Sections 13 and 14.

11.82 A Hickory 12 ins. diamt.

39.55 A B. Oak 20 ins. diamt.

45.00 A drain - Course N. W.

46.79 A W. Oak 30 ins. diamt.

51.80 A brook 4 links wide - Course N. E.

64.55 A Maple 12 ins. diamt.

66.40 A brook 6 links wide - Course West.

80.00 Set post corner of Sections 7, 8, 13, 14, from which a Sassafras 7 ins. diamt, bears N 59 E, 7 links distant, and a Maple 24 ins. diamt, bears S 67 W, 55 links distant.

This mile, pretty level land. Good soil. Timber, Oak, Hickory, Chestnut, Maple, some Ash. Undergrowth Dogwood and Ironwood. Fine farming land.

Moved the post corner of Half Sections 15 and 26 5 chains South, from which a W. Oak 12 ins. diamt. bears N 31½ W, 7 links distant, and a B. Oak 24 ins. diamt bears S 22 E, 9 links distant. Thence ran

West, between half Sections 15 and 26.

Ch. 26

39.75 Intersected North and South line 5 links North of post.

This half mile, on ridges of level land - Good soil. Timber, W. Oak, B. Oak, Chestnut and Hickory - Dogwood and Ironwood undergrowth. Some Maple and Ash timber.

North, between Sections 7 and 8.

8.50 A brook 8 links wide - Course West.

20.24 A Hickory 12 ins. diam.

31.00 A drain - Course S. W.

64.30 A brook 8 links wide - Course West.

72.64 A Hickory, 14 ins. diam.

79.50 A drain - Course West.

80.00 Set post corner of Sections 3, 4, 7, 8, from which a Beech 10 ins. diam., bears N 33 E, 16 links distant, and a Beech 10 ins. diam., bears S 61 W, 8 links distant.

This mile, low ridges + Pretty good soil. Timber, Oak, Beech, Maple, with some Chestnut and Hickory. Undergrowth, Dogwood and Ironwood.

Moved the corner of half Sections 6 and 15. 5 chains South, from which a Maple 20 ins. diam., bears N 87 W, 26 links distant, and a Hickory 12 ins. diam., bears S 58 E, 20 links distant. Thence ran

West, between half Sections 6 and 15.

39.76 Intersected the North and South line 12 links North of post.

This half mile, level land - Good soil. Timber, Oak, Hickory, Beech, Maple, Gum, Dogwood and some Chestnut. Some Sugar and Spice undergrowth.

East, cleared the line between half Sections 6 and 15, and marked per plan.

North, between Sections 3 and 4.

41.00 A Chestnut 24 ins. diam.

Ch. Lks.

67.50 A Gum 12 ins. diam.

75.00 A drain - Course N. E.

78.00 A brook 6 links wide - course East.

83.00 Intersected the North Boundary of this Township, 20 links East of Temporary post.

This mile level land - Good soil - Timber, Oak, Chesnut, Hickory Beech and Maple - Dogwood undergrowth.

Set post corner of Sections 3 and 4, from which a Hickory 16 ins. diam., bears S 3 W, 21 links distant, and a W. Oak 12 ins. diam., bears N 65 W, 6 links distant.

Marked per plan.

Friday, September 9, 1803.

West, on South Boundary of Section 24.

30.50 A brook 6 links wide - Course S. W.

37.30 A drain - Course South.

40.00 Set post corner of half Sections 47 and 48, from which a Maple 12 ins. diam., bears N 81 E, 29 links distant, and a W. Oak 30 ins. diam., bears N 24 W, 37 lks. distant.

49.00 A drain - Course S. W.

80.00 Set post corner of Sections 24 and 25, from which a Gum 12 ins. diam., bears N 18 E, 15 links distant, and a Maple 16 ins. diam., bears S 75 E, 26 links distant.

This mile, hilly land - Generally thin, stony soil - Timber, Oak, Hickory, Beech, Chesnut and Maple - Dogwood and Ironwood undergrowth.

North, between Sections 24 and 25.

13.75 A drain - Course S. W.

38.04 A W. Oak 24 ins. diam.

47.38 A W. Oak 24 ins. diam.

72.50 A brook 12 links wide - Course N 60 W.

80.00 Set post corner of Sections 16, 17, 24, 25, from which a W. Oak 14 ins. diam., bears S 52 W, 7 links distant, and a Maple 16 ins. diam., bears N 4 E, 24 links distant.

This mile, over one high ridge - Course S. W. Thin

ch. 1st

stony soil - timber, Oak, Sycamore, Hickory and Maple - Dogwood and Ironwood undergrowth.

West, between Sections 17 and 24.

7.50 A brook 6 links wide - Course South - High rocks.

22.00 A drain - Course South.

33.50 A brook 4 links wide - Course South.

69.06 A brook 3 links wide - Course South.

80.00 Intersected the North and South line 28 links South of post.

Timber, Oak, Hickory, Beech and Maple - Soil thin and stony - The runs and drains very rocky.

East, Blazed the line between Sections 17 and 24, and set post corner of half Sections 33, 34, 47, 48, at average measure, from which a W. Oak 20 ins. diam., bears S 85 E, 16 links distant, and a W. Oak 24 ins. diam., bears S 50 W, 33 links distant.

North, between Sections 16 and 17.

7.70 A W. Oak 15 ins. diam.

26.36 A W. Oak 18 ins. diam.

32.00 To bottom.

36.10 A brook 10 links wide - Course West.

38.00 Across bottom.

53.70 A Maple 18 ins. diam.

58.50 A brook 6 links wide - Course S. W.

67.10 An Elm 12 ins. diam.

80.00 Set post corner of Sections 14, 15, 16, 17, from which a W. Oak 36 ins. diam., bears S 71 W, 56 links distant, and a W. Oak 40 ins. diam., bears S 65 E, 43 links distant.

This mile, ridge land - Middling soil. Timber, Oak, Hickory, Beech, Maple, and some Elm and Sugar. Dogwood and Ironwood undergrowth. Some Spice bush on hill sides - Woods open and country handsome.

Chs. Lks.

- West, between Sections 15 and 16.
- 17.25 A drain - Course South.
- 18.15 A W. Oak 30 ins. diam.
- 22.20 A drain - Course S. W.
- 35.00 A brook 6 links wide - Course South.
- 40.00 Set post corner of half Sections 29, 30, 31, 32, from which a W. Oak 16 ins. diam., bears N 42 W, 32 links distant, and a Hickory 14 ins. diam., bears S 24 W, 12 links distant.
- 46.20 Intersected the West Boundary of this Range, and set post corner of Sections 15 and 16, from which a W. Oak 20 ins. diam., bears N 40 E, 10 links distant, & a W. Oak 14 ins. diam., bears S 6 W, 36 links distant.

This distance, ridge land. Middling soil - Timber, Oak, Beech, Ash and Hickory.

Quit for the day, Sept. 9, 1803 - Smith took sick.

Sunday, September 10, 1803.

- West, between Sections 16 and 25.
- 6.00 A drain - Course South.
- 12.50 Bottom land.
- 20.00 A brook 15 links wide - Course West.
- 26.00 Leave the brook - Course S. W.
- 37.50 A branch 8 links wide - Course South - Comes from N. E.
- 38.00 Bend of main brook - Course S. W.
- 40.00 Set post corner of half Sections 31, 32, 49, 50, from which a Hickory 12 ins. diam., bears N 3 W, 11 links distant, and an Elm 20 ins. diam., bears S 3 E, 41 lks. distant.
- 47.70 Intersected West Boundary of this Range, and set post corner of Sections 16 and 25, from which a B. Ash 12 ins. diam., bears S 72 E, 6 links distant, and a B. Ash 12 ins. diam., bears S 49 W, 20 links distant.

This distance, generally run bottom. Good meadow ground - Timber, B. Ash, Hickory and Sugar.

West, on South Boundary of Section 25.

Ch. Sta.

- 7.30 A brook 4 links wide - Course S. W.
 9.00 A drain - Course South.
 31.70 A drain - Course South.
 38.50 A brook 12 links wide - Course N. W.
 40.00 A run - Course N. W. Set post corner of half Sections 49 and 50, from which a Maple 10 ins. diam., bears N 44 W, 18 links distant, and an Elm 18 ins. diam., bears East, 22 lks. distant - This is an old sight tree.
 49.45 Intersected the West Boundary at old Town Corner. It also intersects at corner of Townships 8 and 9, Range 7. Set post, from which a Hickory 20 ins. diam., bears N. S. 79 W, 11 links distant, [so in the original], and a Hickory 12 ins. diam., bears S 66 E, 18 links distant. Marked per plan.

This distance, hilly land. Thin, stony soil - About 4 chains Bottom land on run - Timber, Oak, Hickory and Maple.

- North, on West Boundary of Section 25, (being also the East Boundary of Section 21 of Township 9, Range 7).
 4.00 To bottom.
 8.25 A brook 16 links wide - Course West.
 11.00 Across Bottom.
 25.30 A drain 3 links wide - Course S. W.
 62.50 A drain - Course West.
 64.00 A Spring - Course S. W.
 74.00 To Bottom.
 75.20 A brook 15 links wide - Course West.
 80.00 Set post corner of Sections 16 and 25, (being also the corner of Sections 20 and 21, T. 9, R. 7). Marked per plan.

This mile, hilly land. Middling soil - Timber, Oak, Hickory, Beech and Maple &c. Some large rocks on hill sides.

North, on West Boundary of Section 16.

Ch. 1st

- 5.00 Across Bottom.
- 80.00 Set post corner of Sections 15 and 16 (being also the corner of Sections 11 and 20, Town 9, Range 7.)
This mile, on a ridge - Pretty good soil - Timber, W. Oak, Chestnut, Hickory, Beech and Maple - Dogwood, Ironwood and Spice, undergrowth. Some stone on sides of ridge.

North, on West Boundary of Section 15.

- 41.31 Old Section corner [of Quarter Townships] - Set a new post, and marked it per plan, from which a W. Oak 20 ins. diam., bears N 37° E, 42 links distant, and a B. Oak 20 ins. diam., bears S 37° W, 55 links distant.
- 65.50 A brook 4 links wide - Course East.
- 80.00 Set Temporary post, until I intersect from the East.
This mile, gentle ascents and descents - Soil good. Timber, Oak, Hickory, some Maple and Chestnut - Undergrowth, Dogwood, Sassafras and Spice - Good farming country

West, between Sections 14 and 17.

- 11.80 A drain - Course South - Deep gully.
- 47.50 A drain - Course South.
- 69.00 A brook 3 links wide - Course S. W.
- 80.30 Intersected the North and South line 40 links South of post.
This mile, ridge land. Middling soil - Timber, Oak, Hickory, Chestnut, Maple, Beech - Dogwood and some Spice, undergrowth.

East, connected, between Sections 14 and 17.

Blazed the line, and set post corner of half Sections 33, 34, 27, 28, at average measure, from which a Hickory 14 ins. diam., bears S 82° E, 5½ links distant, and a Hickory 14 ins. diam., bears S 41° W, 33 links distant.

Chs. Sta.

North, between Sections 14 and 15.

2.90 A W. Oak 20 ins. diam.

41.40 A Maple 30 ins. diam.

56.20 A W. Oak 28 ins. diam.

61.00 A brook 8 links wide - Course West

66.00 A brook 4 links wide - Course S.W.

80.00 Set post corner of Sections 6, 7, 14, 15, from which, a W. Oak 16 ins. diam., bears N 12 W, 22 links distant, and a W. Oak 15 ins. diam., bears S 1 E, 23 links distant.

This mile, ridge land - Good soil - Timber, Oak, Hickory, Maple, Gum, some Chestnut - Dogwood undergrowth, with some Sassafras.

West, between Sections 7 and 14.

7.20 A brook 6 links wide - Course N. E.

10.70 A drain - Course S. E.

65.00 A drain - Course S. W.

69.00 A brook 4 links wide - Course S. W.

80.60 Intersected at post.

This mile, ridge land - Poor stony soil. Timber, Oak, Hickory, some Chestnut - Dogwood and Ironwood undergrowth.

East, corrected, between Sections 7 and 14.

Reared the line, and set post corner of half Sections 13, 14, 27, 28, at average measure, from which a Hickory 12 ins. diam., bears S 40 W, 17 links distant, and a Sugar 9 ins. diam., bears S 43 E, 6 links distant.

West, between Sections 6 and 15.

10.00 A drain - Course S. W.

24.60 A Gum 12 ins. diam.

28.00 A brook 8 links wide - Course N. W.

40.00 Set post corner of half Sections 11, 12, 29, 30, from which a W. Oak 20 ins. diam., bears N 21 W, 29 links distant, and a W. Oak 24 ins. diam., bears S 9 W, 13 links distant.

Ch. 1st

distant.

44.92 Intersected West Boundary of this Range 10 links South of Temporary post.

This half mile, ridge land. Good soil - Timber, Oak and Hickory.

Set post corner of Sections 6 and 15, from which a Maple 12 ins. diam^t, bears S 35 E, 13 links distant, and a Maple 11 ins. diam^t, bears N 88 W, 40 links distant.

Quit for the day, September 9, 1803.

Sunday, September 10, 1803.

North, between Sections 6 and 7.

- 5.45 A drain - Course S. W.
 7.10 A drain - Course S. W.
 32.40 A drain - Course West.
 35.25 A drain - Course West.
 36.45 A W. Oak 16 ins. diam^t.
 52.25 A brook 10 links wide - Course West.
 61.69 A W. Oak 18 ins. diam^t.
 78.00 A brook 3 links wide - Course West.
 80.00 Set post corner of Sections 4, 5, 6, 7, from which a W. Oak 30 ins. diam^t, bears N 64 E, 11 links distant, and a Maple 18 ins. diam^t, bears West, 17 links distant.
 This mile, ridge land - middling soil - Timber, Oak, Maple and Hickory - Dogwood, undergrowth.

West, between Sections 4 and 7.

- 24.00 A run 3 links wide - Course S. W.
 42.50 A brook 6 links wide - Course South.
 60.25 A brook 3 links wide - Course S. W.
 80.00 Intersected the North and South line 10 links South of post.
 This mile, low ridges - middling soil - Timber, Oak, Hickory, Maple - Dogwood and Ironwood undergrowth. Some spice in places.

ch. 1st

East, corrected, between Sections 4 and 7.

Blazed the line, and set post corner of half Sections 7, 8, 13, 14, at average measure, from which a Sugar 12 ins. diam., bears S 43 W, 39 links distant, and a W. Oak 20 ins. diam., bears S 79 E, 36 links distant.

West, between Sections 5 and 6.

3.50 A brook 3 links wide - Course South.

7.20 A W. Oak 30 ins. diam.

27.74 A W. Oak 24 ins. diam.

35.75 A brook 4 links wide - Course South.

40.00 Set post corner of half Sections 9, 10, 11, 12, from which a W. Oak 30 ins. diam., bears N 37 E, 17 links distant, and a Hickory 12 ins. diam., bears S 26 W, 32 links distant.

44.85 Intersected West Boundary of this Range, and set post corner of Sections 5 and 6, from which a W. Oak 30 ins. diam., bears S 74 E, 5 links distant, and a W. Oak 26 ins. diam., bears N 7 E, 50 links distant.

This half mile, low ridges. Timber, W. Oak, with some Beech, Sugar, Maple & Dogwood and Ironwood undergrowth.

North, between Sections 4 and 5.

17.50 A drain course S. W.

26.41 A Maple 14 ins. diam.

37.00 A drain - Course S. W.

43.80 A Hickory 12 ins. diam.

73.50 A Hickory 26 ins. diam.

85.10 Intersected the North Boundary of this Township, and set post corner of Sections 4 and 5, from which, a W. Oak 36 ins. diam., bears S 54 W, 23 links distant, and a W. Oak 20 ins. diam., bears S 13 E, 23 links distant.

This mile, low ridges. Middling soil. Timber, Oak and Hickory - Dogwood and Sassafras, undergrowth.

West, on the North Boundary of Section 4.

Ch¹ Lk¹

79.70 To post corner of Sections 4 and 5.

This mile, pretty level land. Middling soil. Timber, Oak and Hickory, with Elm and some Maple - Dogwood undergrowth.

East, Blazed the line, and set post corner of half Sections 7 and 8 at average measure, from which a Poplar, 30 ins. diam^t, bears S 49 E, 13 links distant, and a B. Oak 20 ins. diam^t, bears S 48 W, 46 links distant.

West, on North Boundary of Section 5.

5.00 A drain - Course N. W.

33.50 A brook 6 links wide - Course N. W.

38.25 A Spring run - Course N. W.

40.00 Set post corner of half Sections 9 and 10, from which an Elm 12 ins. diam^t, bears S 28 W, 16 links distant, and a Beech 18 ins. diam^t, bears S 39 E, 39 links distant.

43.50 To the N. W. corner of Township 9 Range 6 - Set post from which a Poplar 24 ins. diam^t, bears S 68 E, 7 links distant, and a B. Oak 34 ins. diam^t, bears N 24 E, 7 links distant.

This half mile, ridge land - Pretty good soil - Timber Oak, Beech, and Maple, Elm and Hickory - Dogwood undergrowth.

North, on West Boundary of Section 6.

1.65 Old Blue mile-post.

10.50 A brook 3 links wide - Course N. E.

36.00 A brook 6 links wide - Course West.

38.00 A brook 15 links wide - Course S. W.

45.30 A brook 10 links wide - Course West.

80.10 To post corner of Sections 5 and 6.

This mile, hilly - Steep gullies - Middling soil - Timber, Oak, Hickory, Maple, Dogwood &c. Last part of the mile more level and better land.

North, on West Boundary of Section 5.

chs. Lks

1. 57 Old Four-Mile post.
 82. 00 To N. E. corner of Township 9, Range 4.
 85. 57 To the North West corner of Township 9 Range 6.

This mile, low open ridges - good soil. Timber, W. Oak, B. Oak, Hickory, Beech, some Sugar and Maple - Large Sassafras, with Dogwood and some Spice undergrowth.

Surveyed in the year of our Lord, 1803, by
 Ebenezer Buckingham,
 Deputy Surveyor.
