


N. W. part of Lot 4. in T 9, of R 5, section 3.

7

No
7

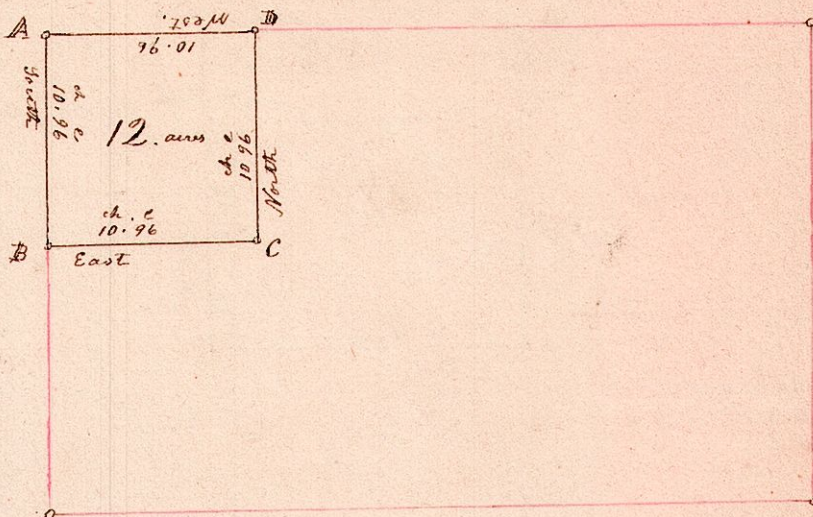

Scale 10 chains to the inch.

Sections	Beating	Trees	Diagonals	Perimeters	Area	Links
A	Sugar	8	S 47 E		9	
B	Hickory Ironwood	9 10	S 24 W N 12 W		24 26	
C	W. oak Elm	25 7	N 72 E N 38 W		19 10	
D	Elm W. oak	6 16	S 89 E S 25 W		13 19	

Surveyed the above February 14th AD 1832.
 Being the most north West part of Lot number 4, in T 9, of R 5,
 Section 3, which was sold to Andrew Wertz on the 11th day of
 December AD 1826, at the Auditors sale in the County of Holmes
 Ohio, for the taxes &c. due thereon, for the year AD 1825.
 of which the above is a correct plat of the same,

Samuel Robinson Co Surveyor