


Lot 4. in T. 9. of R. 9. Section 1.

No of
surveys

13

Scale 10 chains to the inch

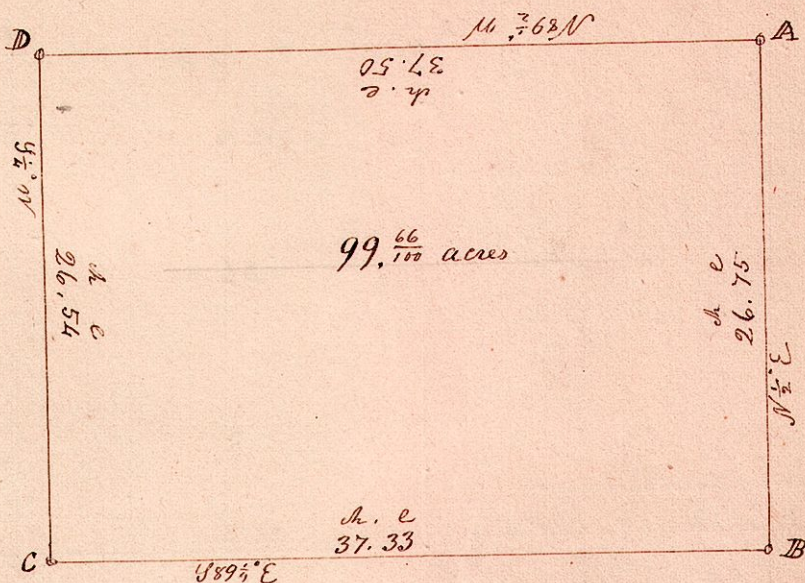

Station	Boundary	Traces	Diam.	Course	Dist	Remarks
A	Sugar	12	3 75	N	18	
	Beech	17	N 14	N	26	
B	W. oak	12	3 15	N	38	
	Do	18	N 49	E	47	
C	Hickory	9	N 75	E	3	
	W. oak	24	N 26	N	21	
D	o. oak	20	3 52	N	69	

Surveyed the above January 3^d AD 1839
 Being Lot number 4. in T. 9. of R. 9. Section 1,
 which was sold to Adam Croco on the 26th day of December AD 1836.
 at the Auditors sale in the County of Holmes Ohio, for the taxes &c
 due thereon for the years AD 1835 & 1836. and assigned to Abraham
 Oberholtzer June 30th 1838, of which the above is a correct plat and
 notes of the same,
 Samuel Robinson, Co Surveyor