

N.W. Q^r of Sec 20 T17 Range 14




Remarks

The Original corner at A could not be found by the bearing
 A to B East 9.67 Chus
 A to D S 45° E 11.25 Chus
 D to C S 77° 45' E 10 Chus
 C to B N 45° W 13.50

The above was surveyed for Randolph Wells, out of N.W. corner of the above named Section
 Surveyed March 1848. J. Silcott Co S

S.E. Q^r of Sec 3 T17 Range 14

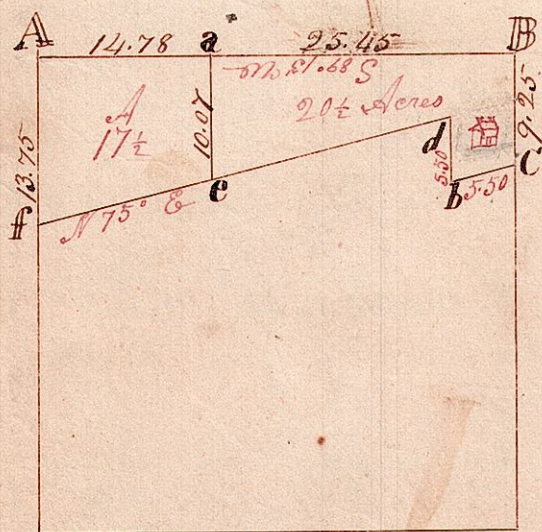

A B Oak 60 N 41 E 25 links
 " Apple 30 N 61 W 78 "
 B. W. Elm 18 S 40° W 33 links
 " Gum 6 N 2 1/2 E 11 Original
 a Stone the corner
 Stone were planted at all the remaining corners. Corners

Surveyed April 1848 for William Poulson off the North side of the above described Section
 J. Silcott Co S