


Township 9 Range 9 Lots 41 & 42

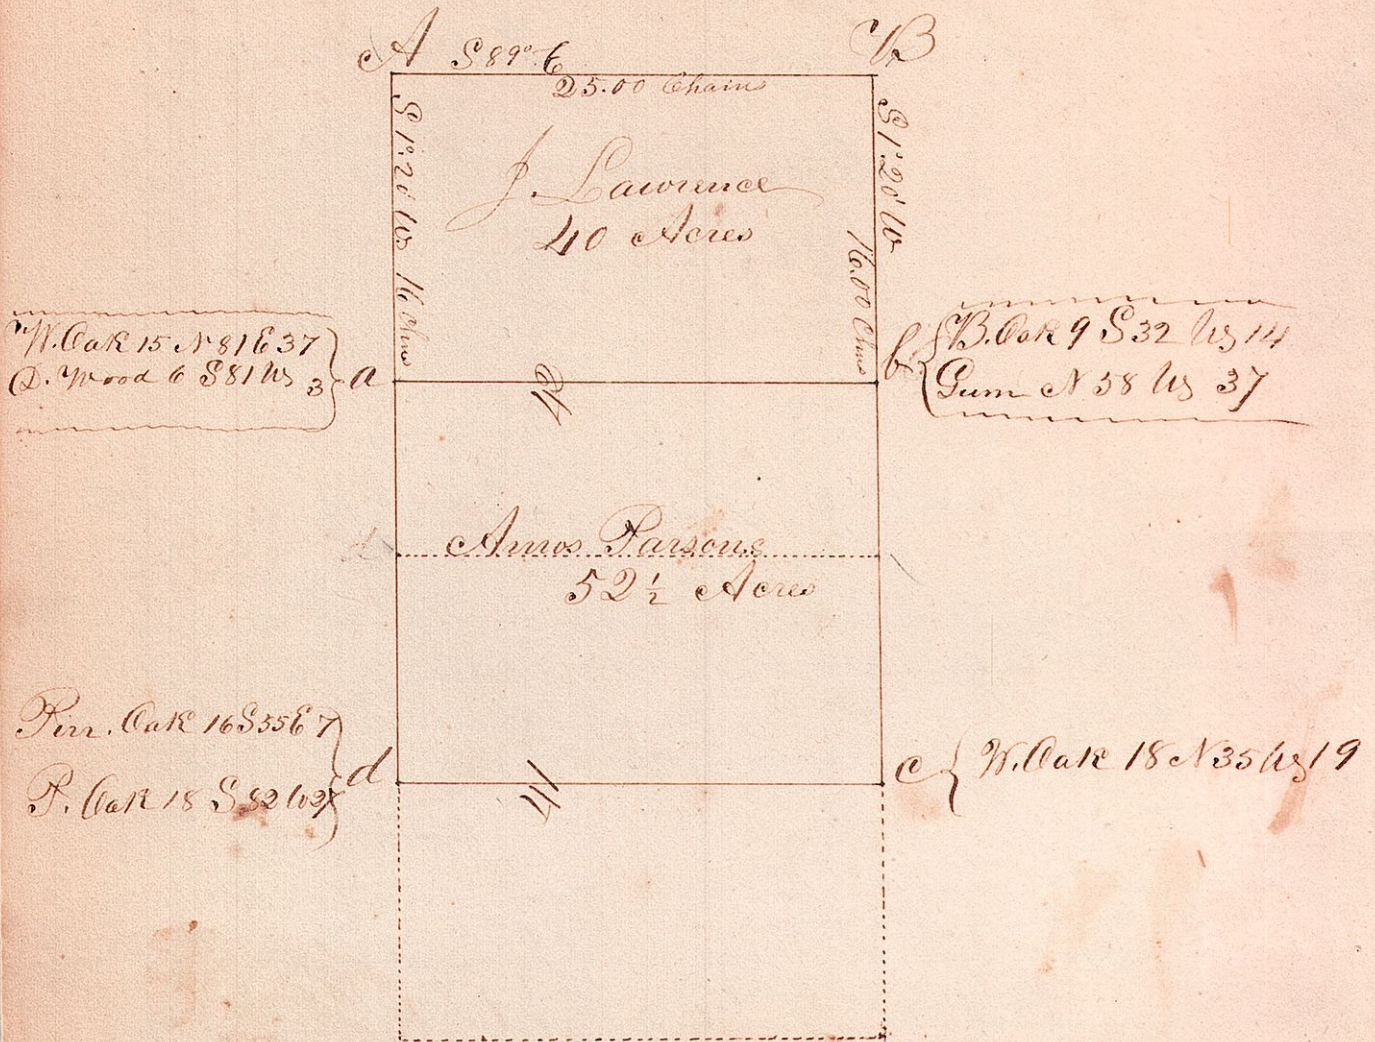

The above tracts were sold off of Lots
 N^o 41 & 42 in the following manner viz. J.
 Lawrence 40 Acres off of the North side of Lot
 N^o 42 & Amos Parsons 52 1/2 Acres. to commence
 at the S. W corner of the above 40 Acre lot thence
 South with the west line of Lot 42 & 41 Distance
 21 Chains, thence S 89° E to the East line of Lot
 N^o 41 T 9 R 9

Remarks

The bearings at A are decayed stumps standing
 at B bearings not found
 The above Lots were Surveyed for Isaac Parsons
 June 1848

I. Silcott (C. S.)