


Township 9 Range 9 Sec 18 (Knox)

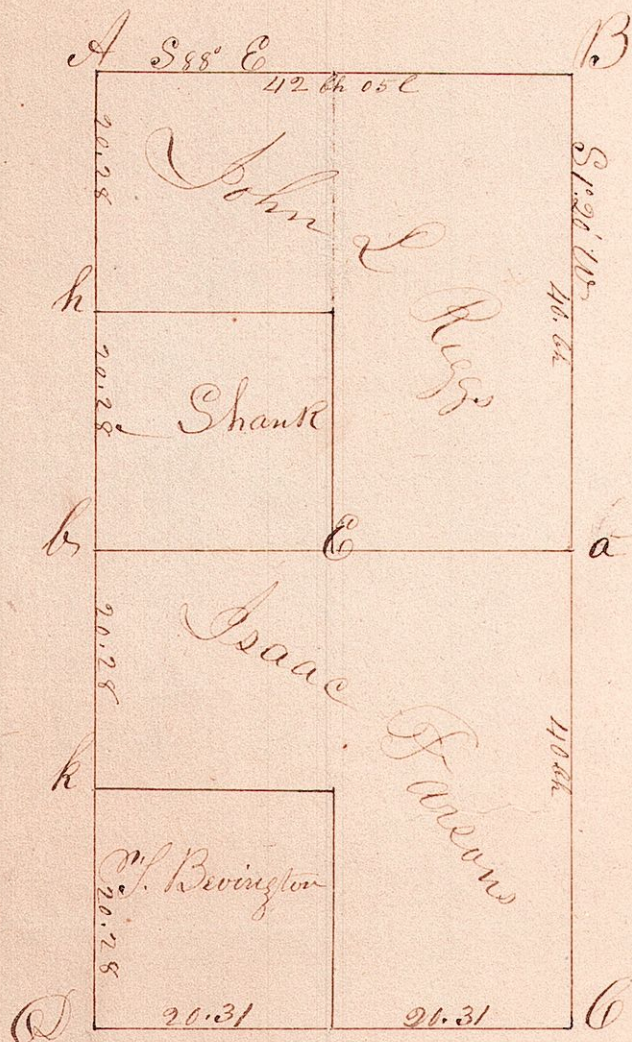

Field Notes or Witness Trees of the above

B. Original not found, none taken. no timber near
 a, Pin Oak 15 N 26 W 36, S Pin Oak 14 S 11 W 11

C. Original not found. No timber near stone planted
 E. R. Oak 13 S 86 E 53

h. W. Oak 18 N 17 W 36, S W. Oak 16 S 12 E 60

k. W. Oak 23 S 2 E 51, S W. Oak 23 S 58 E 22

Remarks

Sections 17, 18, 23, & 24 were surveyed all at one
 survey, some of the corners are recorded with one
 section only, in order to find all the corners an
 examination of all will have to be made —

May 1848

J. Silcott (C.S.)