


Township 8 Range 7 Section 8

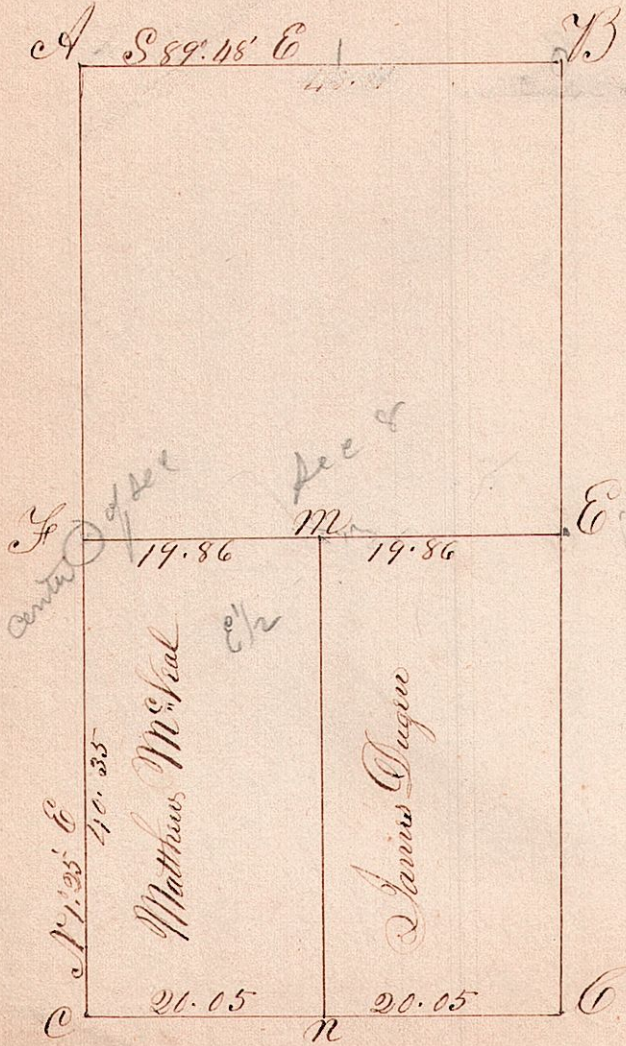

19.86
41.22
49.16

Field Notes of the above half section
 A. The original witness standing good
 M. B. Oak 20 N 40° W 7.5 Buck 6 N 63 E 26
 C. Original good
 n. B. Oak 12 S 48° W 51 links
 C. Hickory 16 N 66 E 14 S B. Oak 6 N 80 E 20
 M. B. Walnut 12 East 19 S Hickory 5 S 55 W 8

Remarks
 The above is the East-half of section 8
 Surveyed Dec 1848
 Original corners all good except the S.E. corner
 one stump standing

J. Silcott (Co Sur)