Township 15, Range 12. Section 25 (S. Creek)

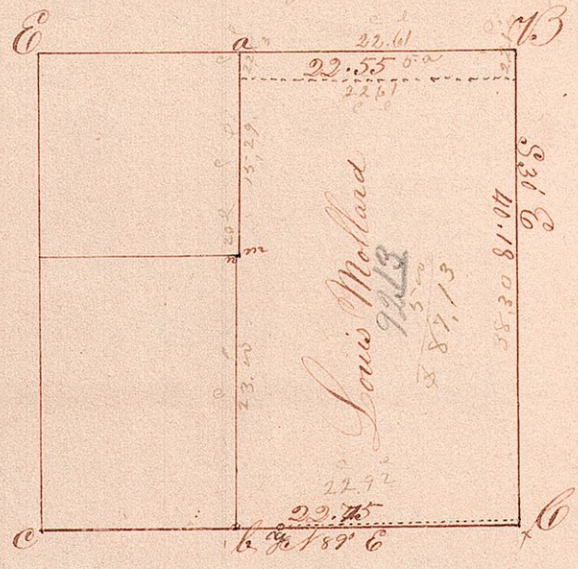

Bearing Trees

C. Chestnut 9 S 76 W 81 & W. Oak 17 N 71½ W 81
C. Maple 12 S 17 W 19 & W. Oak 21 S 68 W 74

Remarks

The above was surveyed for L. Mollard out of the S. E corner of the above described section. Commencing at the S. E corner. Thence N 30 W 40.18 Chains to the N. E corner of L. L. Thence S 87° W 22.55 Chains Thence S 30° E 17.00 Chains - Thence west 20 Links - Thence S 13° E 23.18 chains - Thence ~~S 89° W~~ N 89° E 22.75 Chains, Thence N 88.16 E 20.00 Chains to the place of beginning. The last mentioned ~~corner~~ line is an agreed line between Louis Mollard & John Culbertson which is represented by the dotted line in the above map. L. line commences at a corner 20 Links North of the corner section corner at C. thence S 88.16 W to the N. W corner of John Culbertson land 21 Chains The Original Bearing Trees as could not be found, I established the corner by running from the S. W corner of the section to the South qr corner, and continued the same course to the range line - at the point C.

Surveyed June 1849

Jackson Silcott (S. H. C.)