


## Township 9 Range 9 Lot No 38

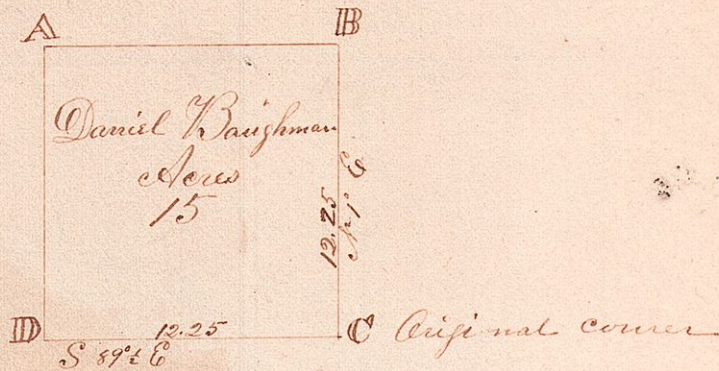

A. N. 3. Cont 5. N 20 W 11.8 7.3. Cont 4. N 82 1/2 W 3  
 B. N. 11. Cont 14. N 67 1/2 W 32 S W. Cont 7 S 4 W 27  
 C. Chest 4 N 72 W 51.8 Original N. Cont good  
 D. N. Cont 6 N 12 E 25 S N. Cont 7 S 77 E 18

The above was surveyed for Daniel Baughman out of the S. E corner of Lot No 38 R 9 T 9 in a square.

I did not survey the whole lot. I placed the corners by the lines. commenced at the S. E corner —

Surveyed June 24<sup>th</sup> 1879 J. Sileott (C<sup>o</sup> Surveyor)