


Lot No 11 Twp 9 Range 5 - 3rd Div (Military)

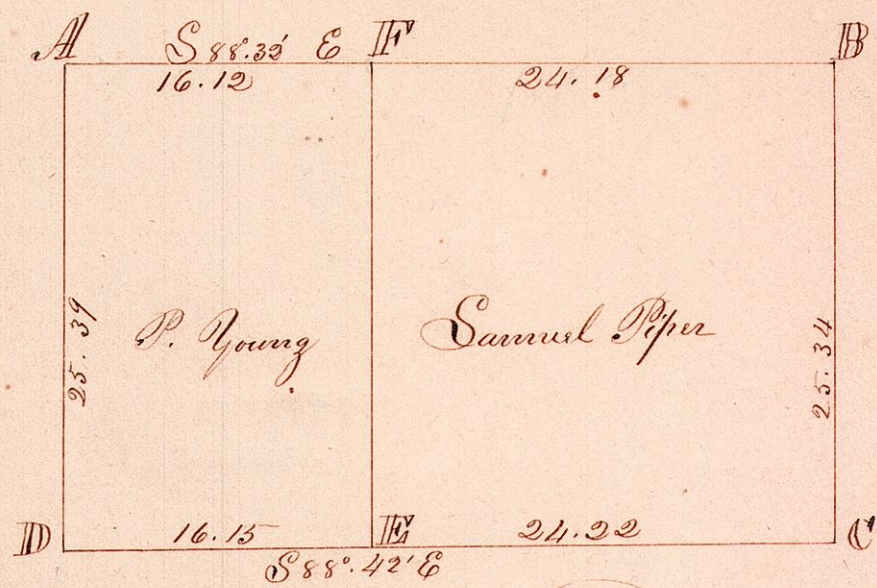

Bearing Trees

Sta	Timber	Count	Bearing	Distance in links
A	Hickory	20	S 78° 40' W	50 links
	Hickory	7	N 37° E	70 "
F	W. Oak	24	S 28° E	28 "
D	Gum	14	S 88 3/4 E	81 " Original decayed
E	W. Ash	10	S 87 1/2 W	27 links
	Sassafras	7	N 77 E	55 "
C	Gum	22	N 12 W	42 " Original decayed
B	W. Oak	4	S 45 W	10
	do	20	N 65 W	16

Surveyed the above for S. Piper & Philo Young
March 10th 1851

Jackson Silcott (by S & Co)