


N. E. Dr. Section 14 Twp 19 Range 15

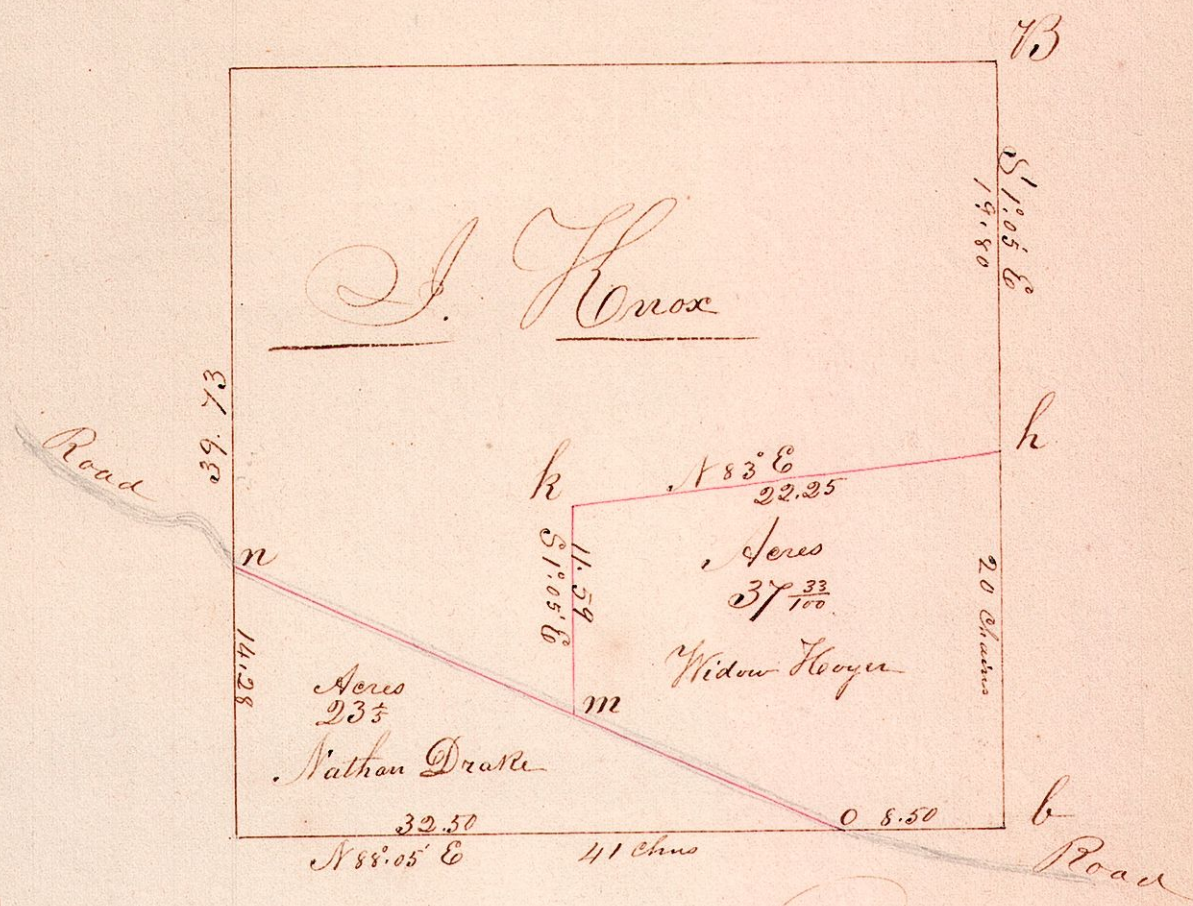

Bearing Trees.

St	Timber	20	Course	Distance in links
B	Chestnut	12	N 87° E	91 links } Original cut down
h	B. Walnut	12	S 46° W	63 "
b	Chestnut	18	N 89 1/2° W	384 "
	B. Oak	10	N 88 1/2° E	511 "
				} Original not found, the corner was made by running the section line and 4th line, to meet it
o	Maple	20	S 77° E	8 "
m	Poplar	17	N 23° W	20 "
n	Chestnut	8	N 64° W	32 "
	Hickory	3	S 74 1/2° E	2 1/2 "
k	Apple	12	N 32° E	31 "

Surveyed the above Dr. for John Knox and Nathan Drake

Oct. 23rd 1851

J. Silcott (C. S. H. S.)