


87

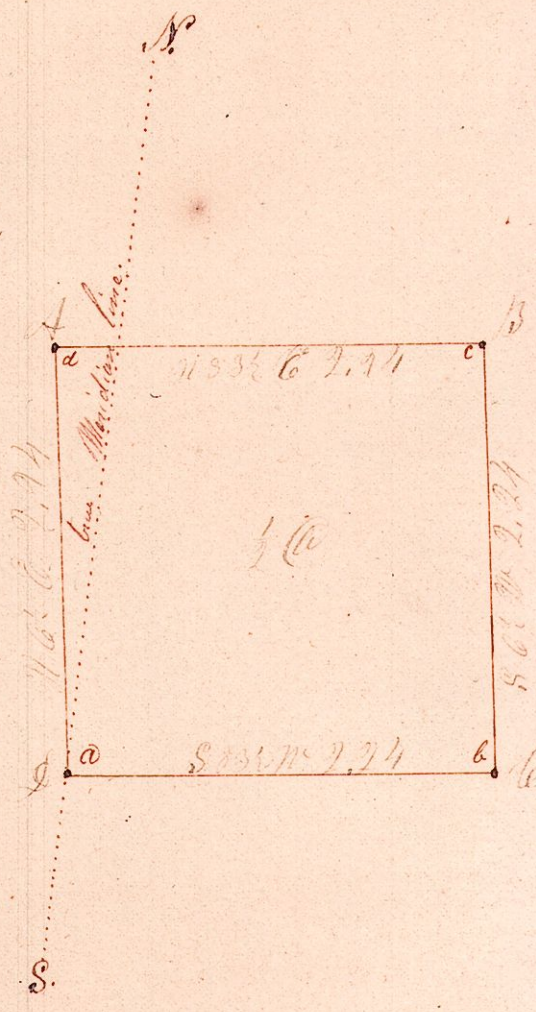

The above was surveyed Nov. 21st 1834
 being one half acre out of Section twelve
 Township nine Range seven
 T. C. Co. & Co.