


Section 11 T. 7. N. Range 14  
South West Quarter

573  
583  
593

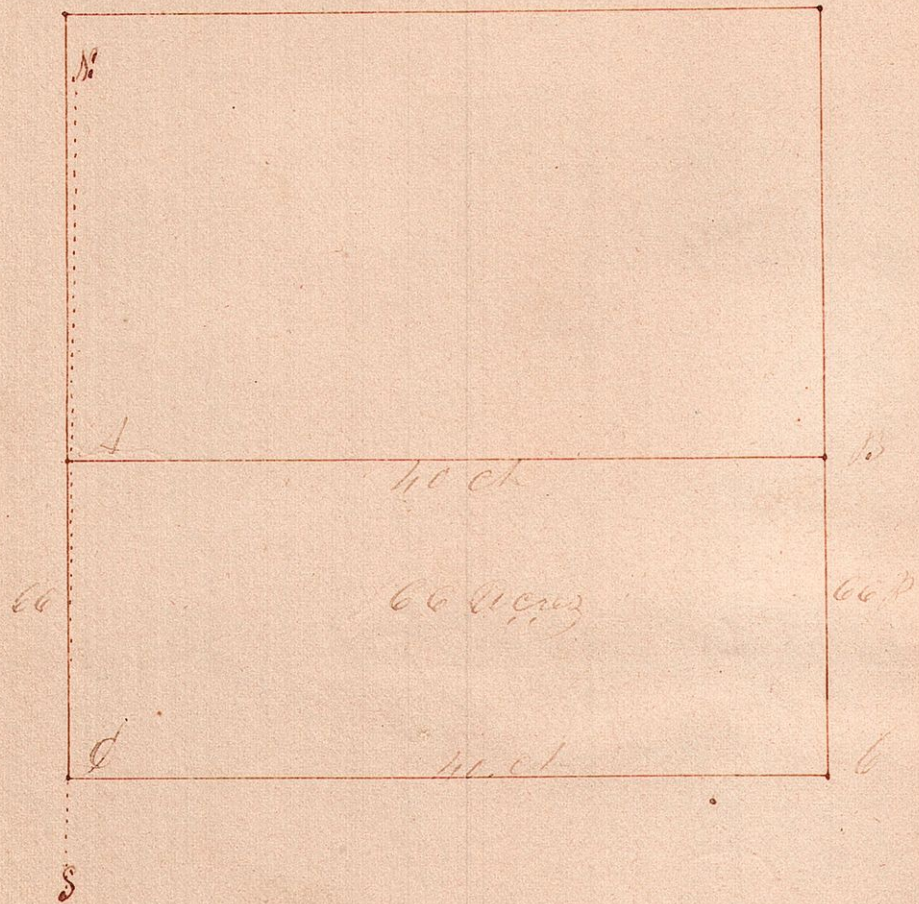

The above was surveyed for John  
Chamber & Daniel M. in the year  
1864

