


Loty No.s 7, 11, 12 Range 6, Twp 9, 1st qt. Tp. (Berlin)

At A B C D E F G H I planted
 Stones & A stumps standing
 Original good & stumps
 standing

No. 23

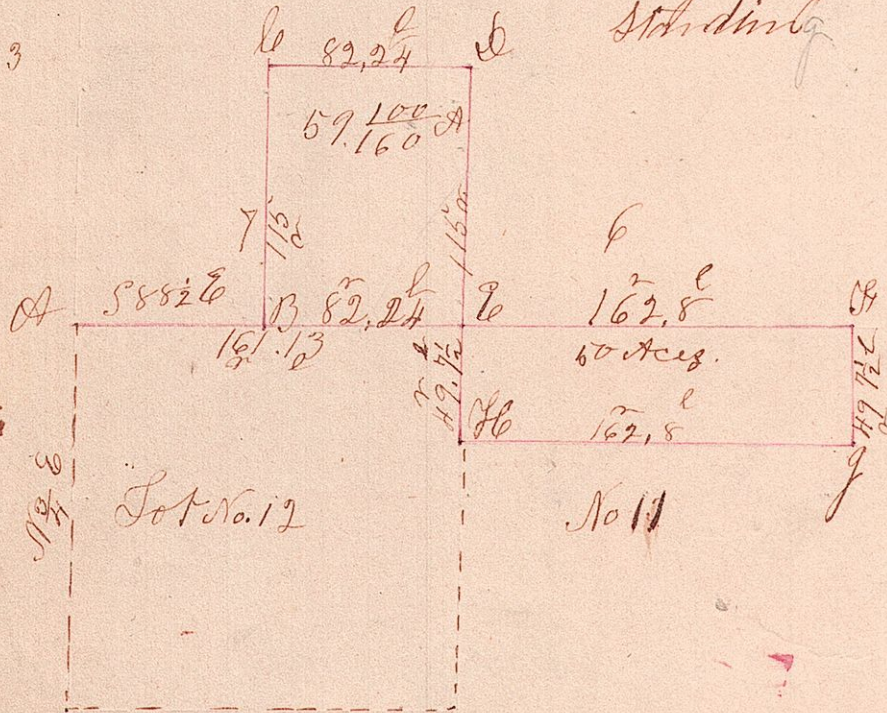

I hereby certify the above to be a correct plot
 of the survey of the southe east part of lot No.
 7, and the north part of lots No. 11, & 12, of of the
 above named Twp. & Range, Surveyed for Samuel
 Bird Abner Maxwell Levi Johnson & Curtus downy
 Chain carriers. Pary Leidy Levi Grant & Jacob Snider,
 Joseph Edgar County
 Surveyor for Holmes co. Va.
 Surveyed Mar. 5th 1861,