


South East Cr. of Sect 7, T¹/₄ 14, Range 12

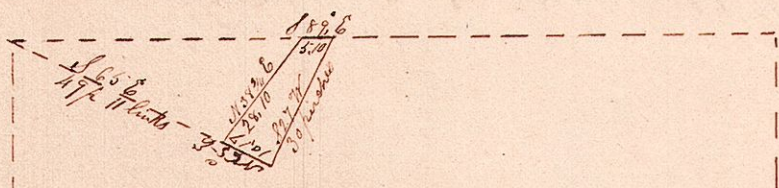

The above is a correct plat & notes
of a part of the above named
Sqr Sect. being a lot sold to
Sgt. Easton by Francis B. Little
containing 140 acres of land,
Surveyed June the 25. 1863
J. L. Richeson
County Surveyor