


Section 29 Sp. 14 Range 13.
North East quarter.

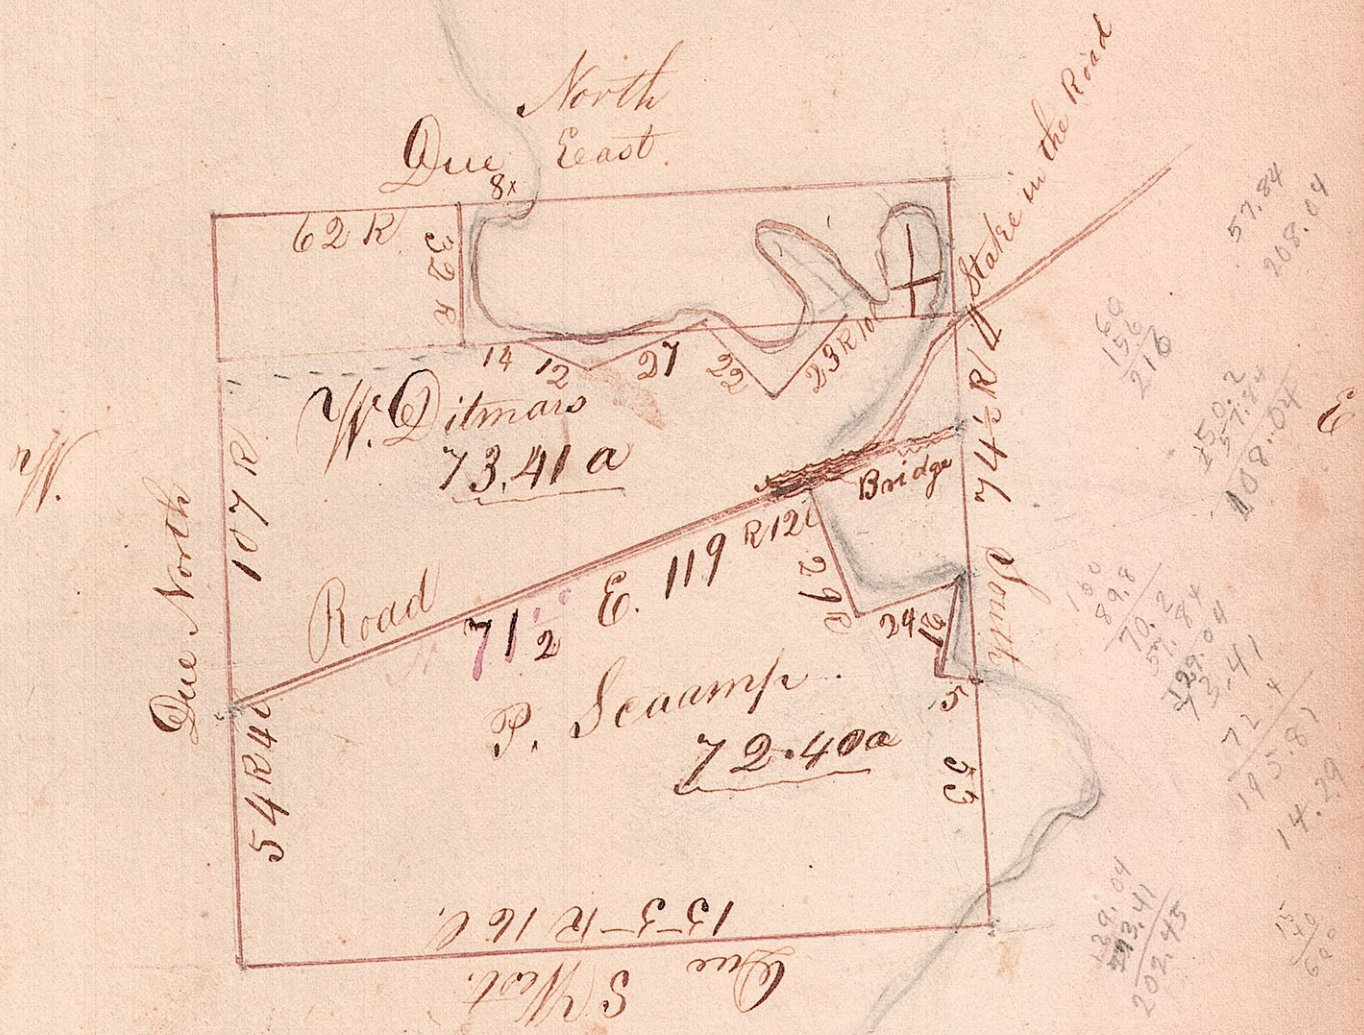

I hereby certify that the above is a correct
 Plat of a Survey made for William Ditmars
 & Peter Schaamp on the 6 & 7 days of May
 1870
 Joshua Sproule Co. S.