North West Quarter Sec 29 Township 19 Range 15

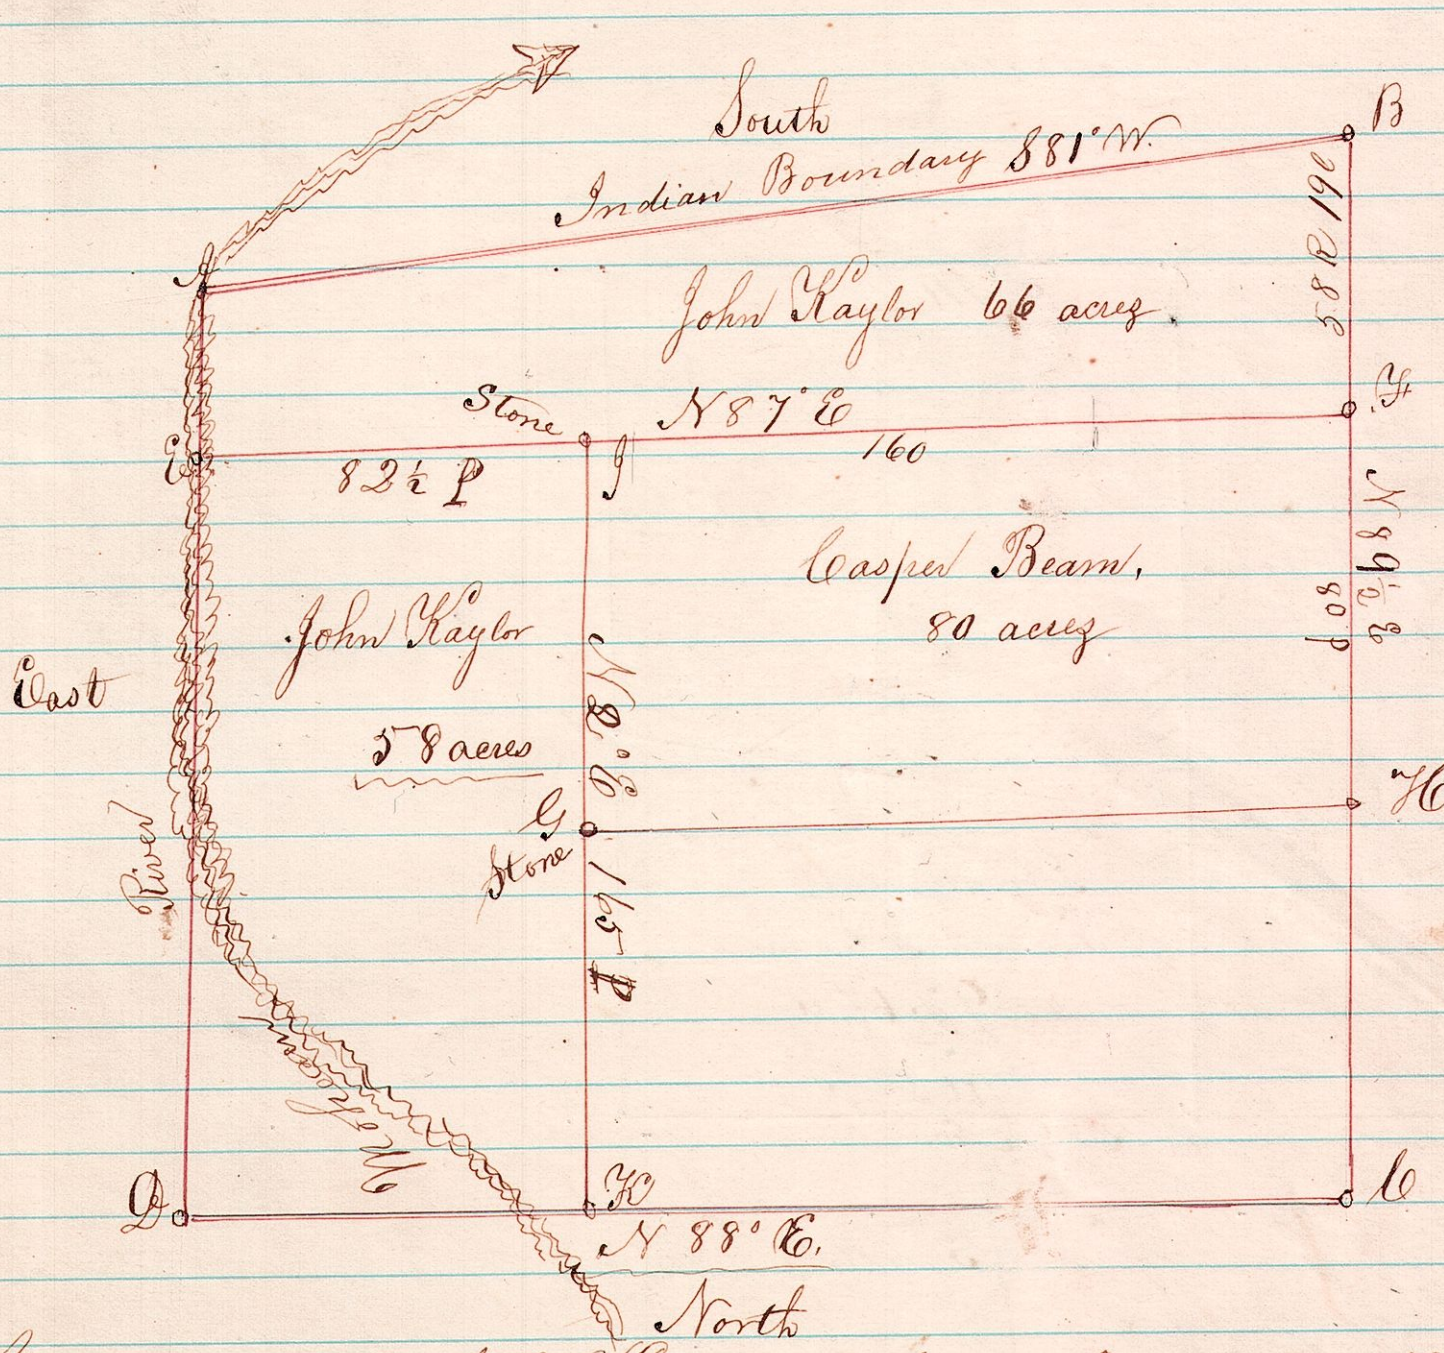

A Survey made for John Kaylor and Casper Beam to establish a divisional line which runs from Caspers Beams South West corner of said Beams lot N87° E to a Stone. 160 perches, this Survey made on the 2nd day Febriary 1871

Joshua Spongle C. Survey

Stations	Bearing & Kind	Diameter	Course & Dist. Bear	Distance
A	White oak	18 in	S 15° W	35
	W. oak	24	S 85° E	100
G	Chestnut	8	N 24° W	18
	Hickory	9	S 29° E	34
I	No timber		Stone corner	
K	Hickory	12	S 85 W	8
	A Pin oak	6	N 85 E	10