


North East qr. Sec. 4 Township 9 Range 4

9

North

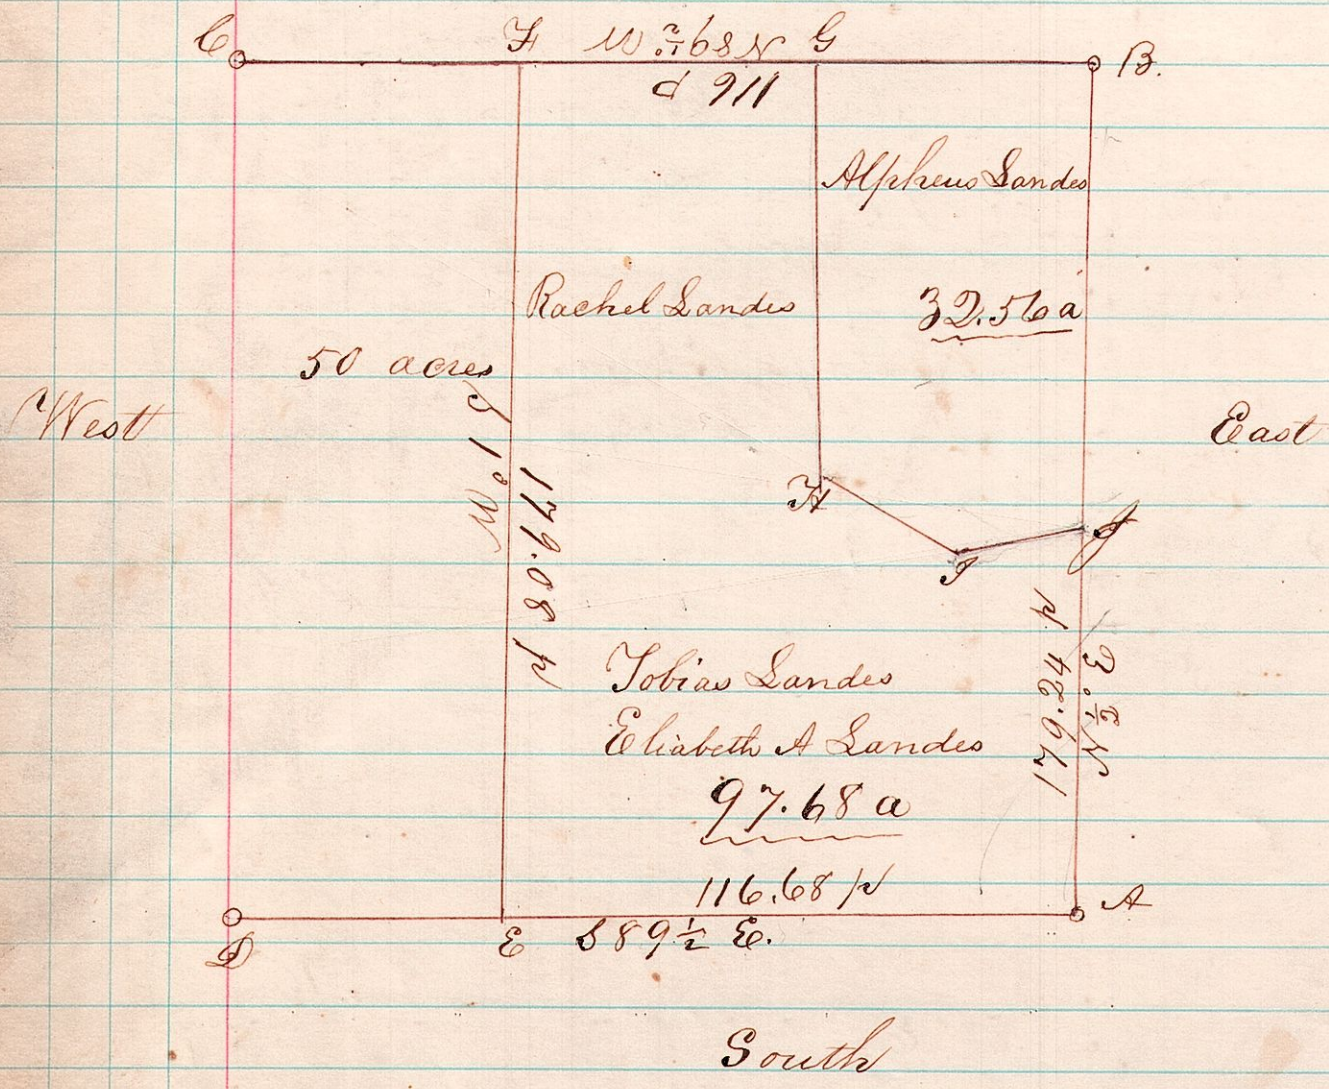

Corner	Bearing tree	Courses	Sinks	Remarks
A	Stone	" "	Corner	"
B	Stone	" "	corner	" No. original Trees standing
F	White oak	corner	"	"
E	White oak	corner	"	"
G	Stone	no trees	corner	No trees to mark
H	Stone	Beech 10 in N 41 W	18	"
I	"	Do. 8 in S 2 E	7	"
J	Stake	corner	"	no trees to mark
I	Stone	corner	"	"

A Survey made for Joseph Sandes on the 22<sup>d</sup> day of February 1871 reference being had to the above plat for courses distances and the several amounts and field notes This 24<sup>th</sup> day of Feb 1871  
 Joshua Sponough 3<sup>d</sup> Co. Sur.