R T S
13 14
14 13 28

Range 14 (13) Township 13 (14) Section 28

35

A Survey made for Martin Miller, and John Poulson on the 12th day of March 1873. To establish the division line between the North East quarter of sec 28 and the north west quarter. Commencing at the South East corner of said quarter Thence N 89½° W and found said bearing to be correct coming close to the South West corner of said section

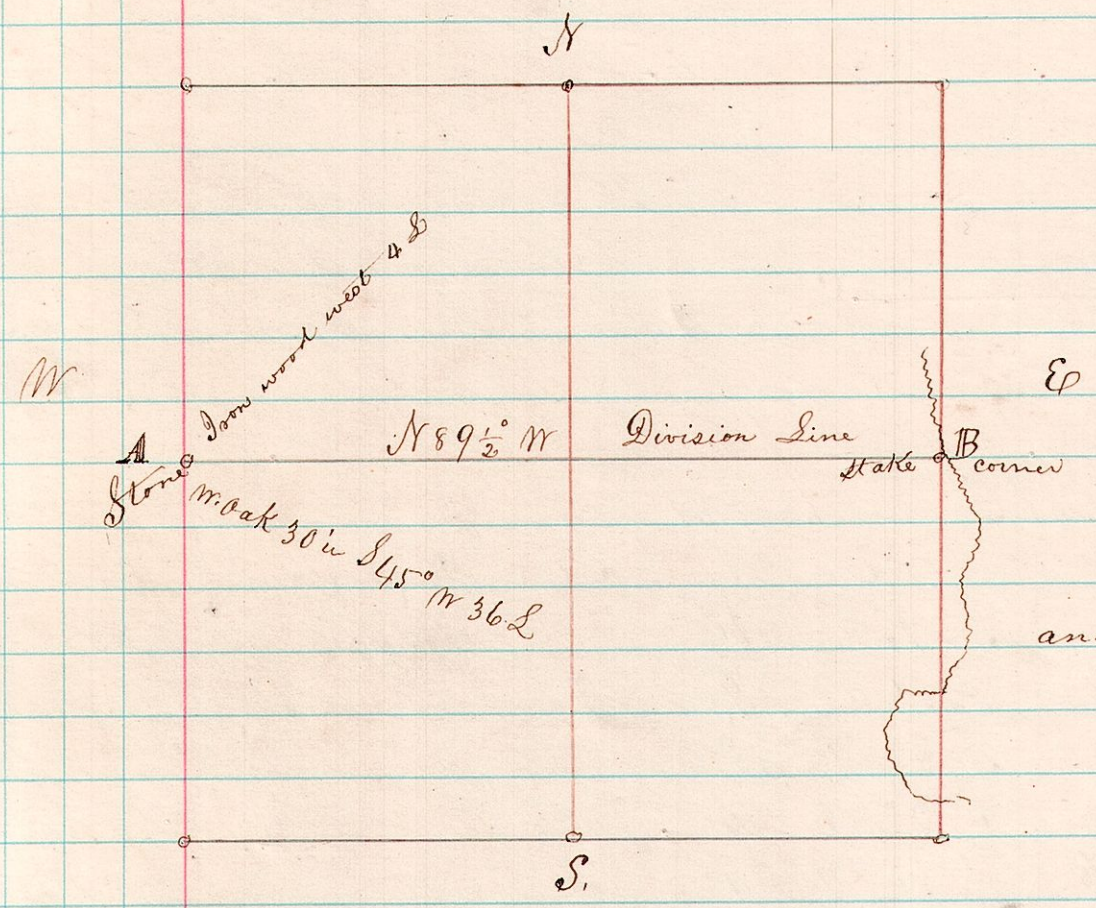

I hereby certified that the above discription and plat to be corrat Dec 16th 1873

Joshua Sponogle county Surveyor

7 8 21

A Survey made for S. Tidball on the 20th day of October 1873, Commencing at the South East corner of the noth West quarter of said Section 21, thence N 2° E 41 perches to a Stake, thence N 2° E 74 perches 10 links to a Stake, thence S 44° W 28 perches to a Stake, thence S 22½° W 7 perches & 8 links to a Stake thence S 14° E 12 perches 17 links to the town Lot to a Stake thence S 87° E 14 perches 11 links to a Stake east of Town lots and alley, thence S 2° W 34 per and 3 links to a Stake, thence S 87° E 5 perches & 9 links to the place of beginning containing 4 44/100 acres

36

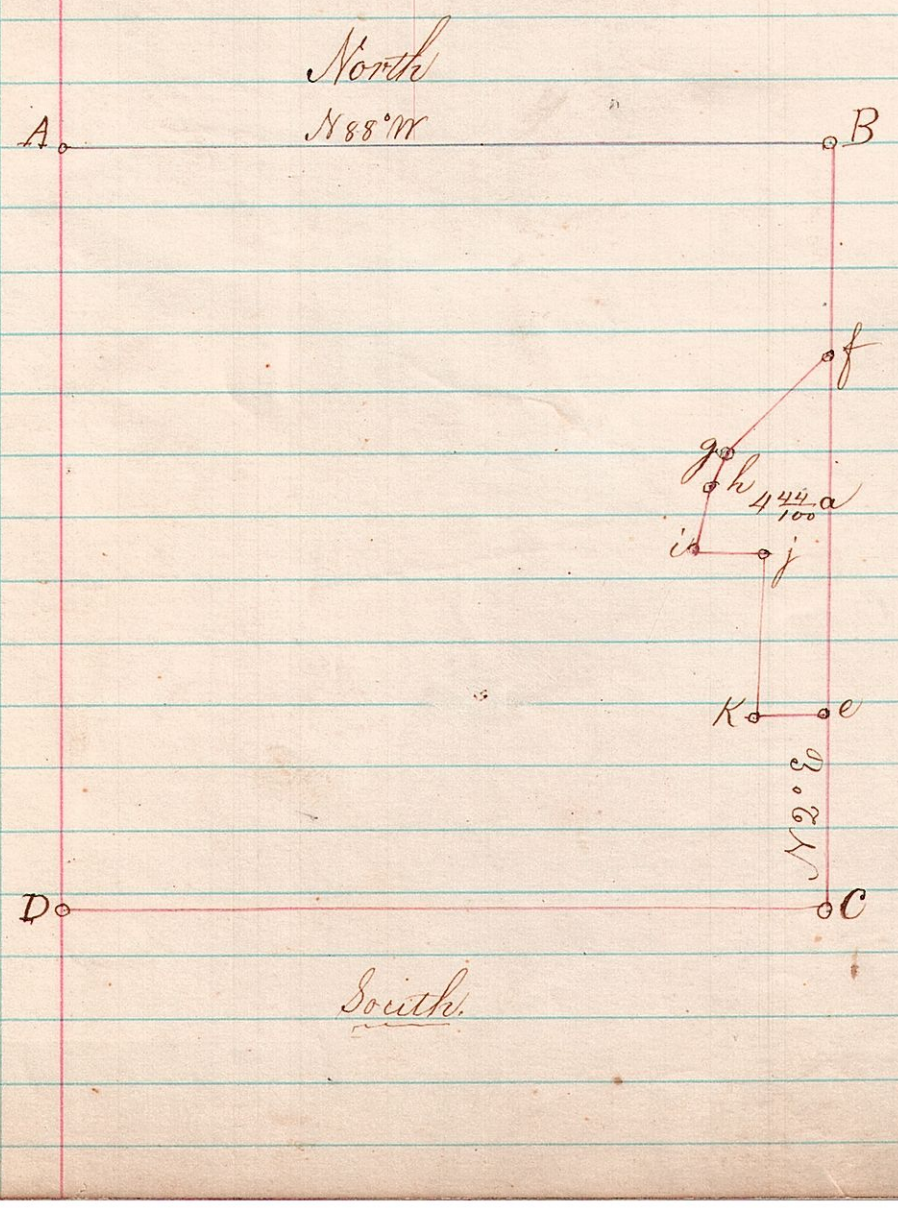

Scale of 20 per to the inch

20 20

It is hereby certified that the Plat and discription is correct January 30th 1874

Joshua Sponogle, county Sur.