


R T S Lot
89 " 7

Township 9 Range 9, Fourth quarter Sp Military ³⁷

A Survey made for Anson Mayers April 1873 Lot number 7
Sp 9 Range 9 fourth quarter Sp Military

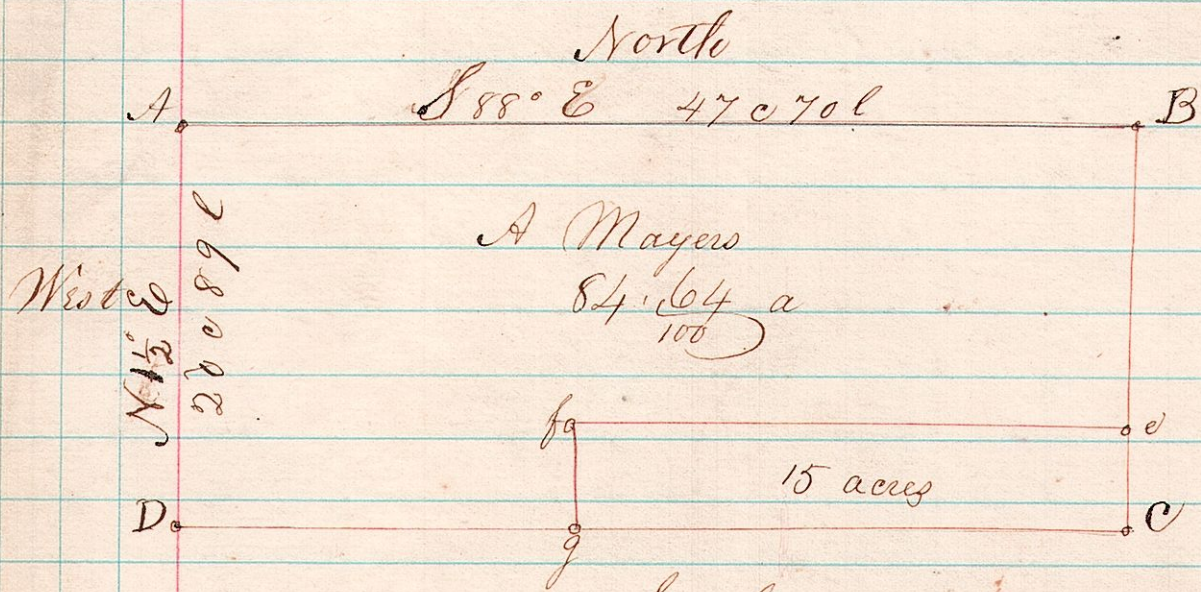

It is hereby certified that
said plat is correct Sept 1873
Joshua Spionogle, C. Sur

	Bearing	Diameter	Courses	distance	
	Trees	inches	From cor	In links	
A corner	White oak	48	N 12° E	20 l	SE cor, Maple 10 in N 27° E 12 l
do	do	10	S 29 1/2° W	51 l	" do 5 in S 17 1/2° E 34 l
D corner	W. O.	30	N 69° W	29 l	
	Chestnut	15	S 68° W	18 l	
B corner	W. O.	14	N 32 1/2° E	44 l	
"	Chest "	16	N 65° W	24 l	

R T Sec 8
89 " 24

A Survey made for Vanavery and others on 4th day of June
1872 Commencing at N. E. corner of Lot number 24 of Township 9
Range 8, thence S 2 1/2° E 100 perches 12 links to a Stone corner, thence
N 89° W 163 perches 13 links to a Stone corner, thence N 2 1/2° W 101 per
15 links to a Stake, thence S 89° East 163 per 6 links to a Stake to the
place of beginning containing 103 1/10 acres.

