N074

13 14 36 The following proceedings & Survey was made for Gamble & Graham, being part of Section 36, T. 14, R 13. under the following notice, attached hereto.

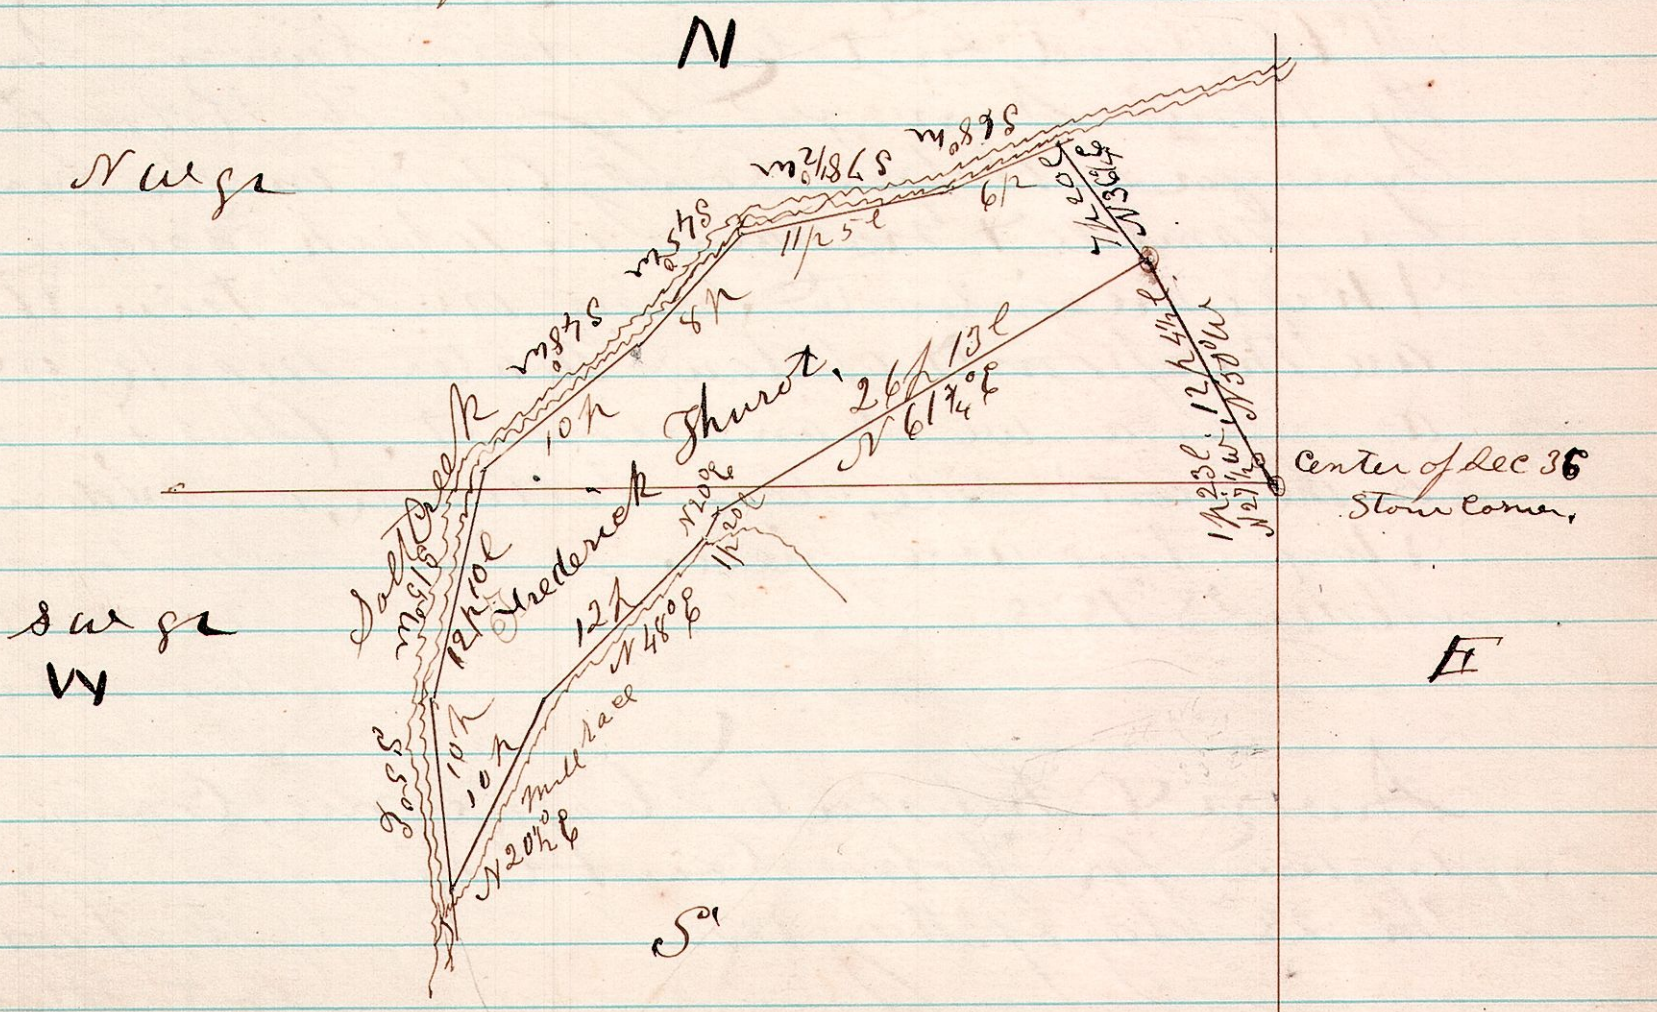

I Certify the above to be a correct plat of survey made this date for Gamble & Graham, The lines on north & west were established on testimony as to where low water mark on Dalt creek was in August 1869.
May 28th 1875.

H. H. Robinson
County Surveyor

Copy

To Frederick Thurot & Wife.
You are hereby notified, that a Survey will be made of the north west quarter of Section 36 in Township 14 of Range 13, in which you are interested will take place on the 28th day of May 1875 Commencing near the Red Mill in said Section and Continuing until all the Corners and lines of your Lot of Land is fully Established by Survey and proof upon will be taken on said day if necessary by H. 
Prairie Township May 6th 1875.

Geo W Gamble
R K Graham

G. W. Gamble makes oath that he served Copy of the above on Frederick Thurot May 8th 1875.

H. H. Robinson
Deputy Surveyor

Testimony on next Page