


No 112


59 ^{lot} 15 A Survey made for Jacob Yoder, being the west part of lot 15, 3^d gr. Tⁿ 9, R 5, (Military)

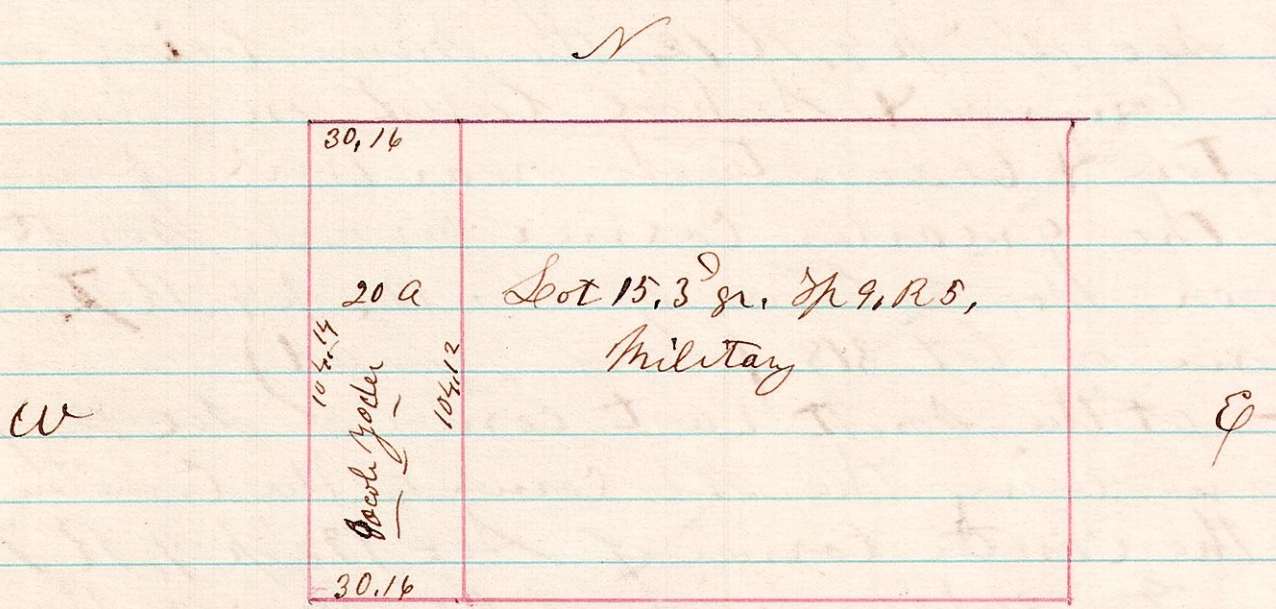

October 18th 1875. H. H. Robinson
Co Surveyor

No 113


59 ^{lot} 31 A Survey made for Jacob Yoder, being the SW pt. of lot 31, 3^d gr. Tⁿ 9, R 5, Military.

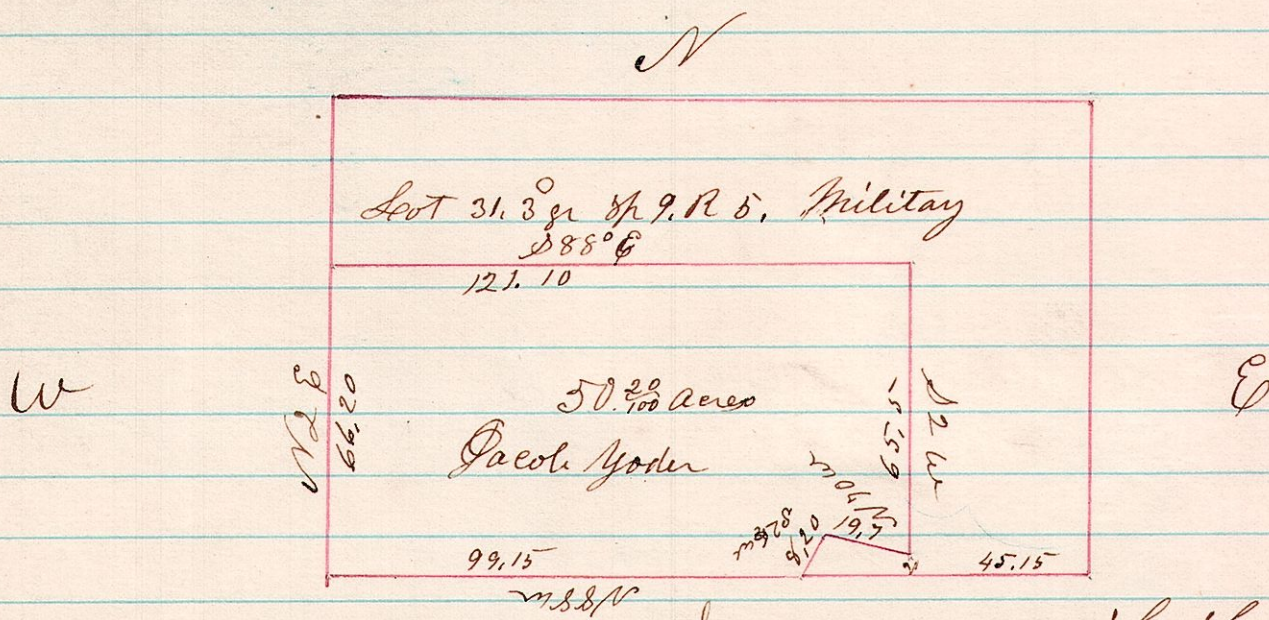

October 18th 1875. H. H. Robinson
Co Surveyor

No 114

59 ^{lot} 31 A Survey made for Eli Troyer, being pt. of w. pt. of lot 31, 3^d gr. Tⁿ 9, R 5, (Military)

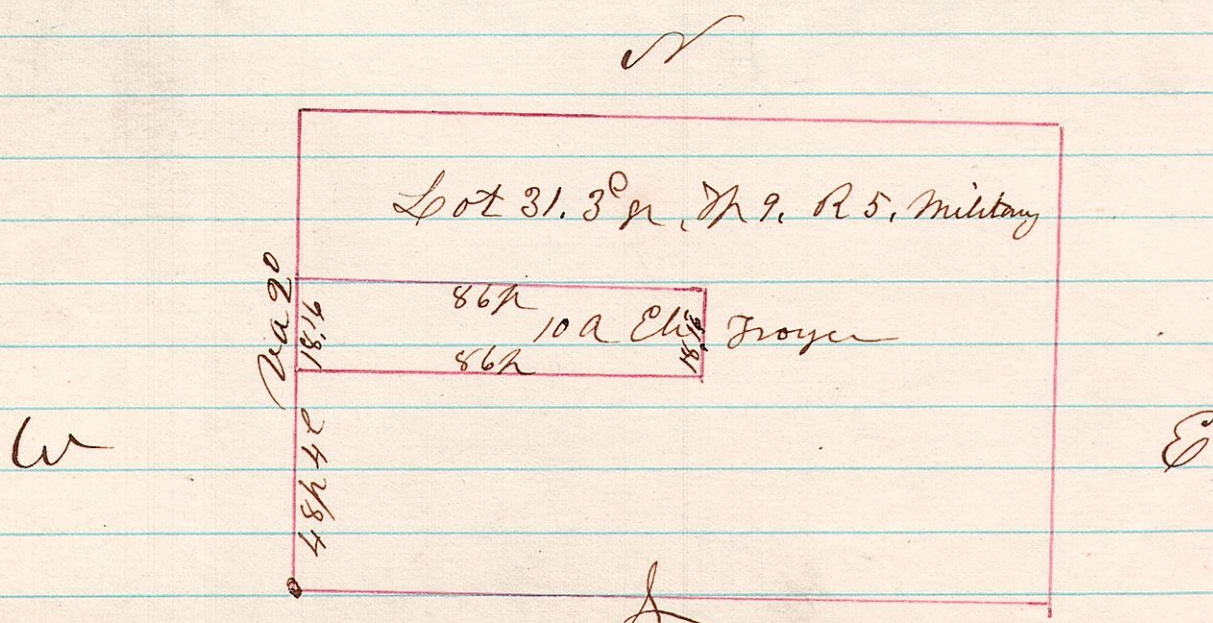

October 18th 1875. H. H. Robinson
Co Surveyor