No 121

R 8 D
7 8 1
7 9 21

A Survey made for Joseph Sowash, being parts of the N W qr sec 1. Tp 8. R 7. & S E pt & S W qr sec 21 Sp 9. R 7 & S W pt S E qr sec 21 Sp 9 R 7.

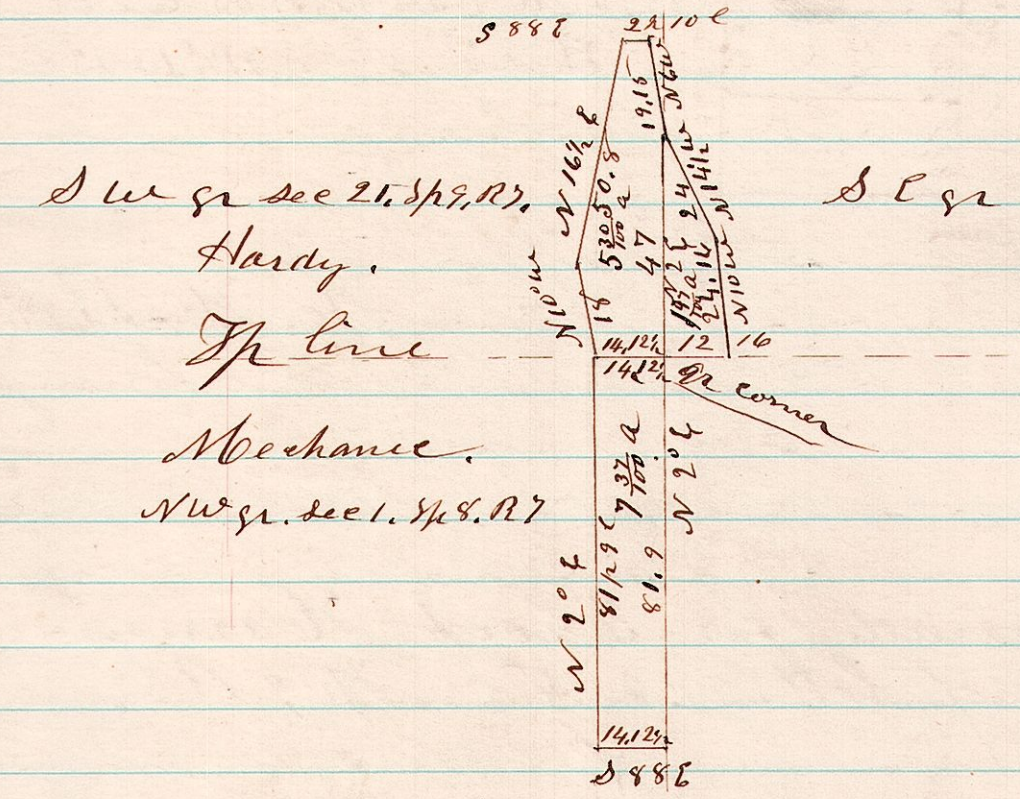


December 3. 1875

H. H. Robinson
Co Surveyor