


R 7

69^{lot} 23


A Survey made for Noah D Miller being the East part of lot No 23 4th gr Tp 9 R 6. C. W. R. S

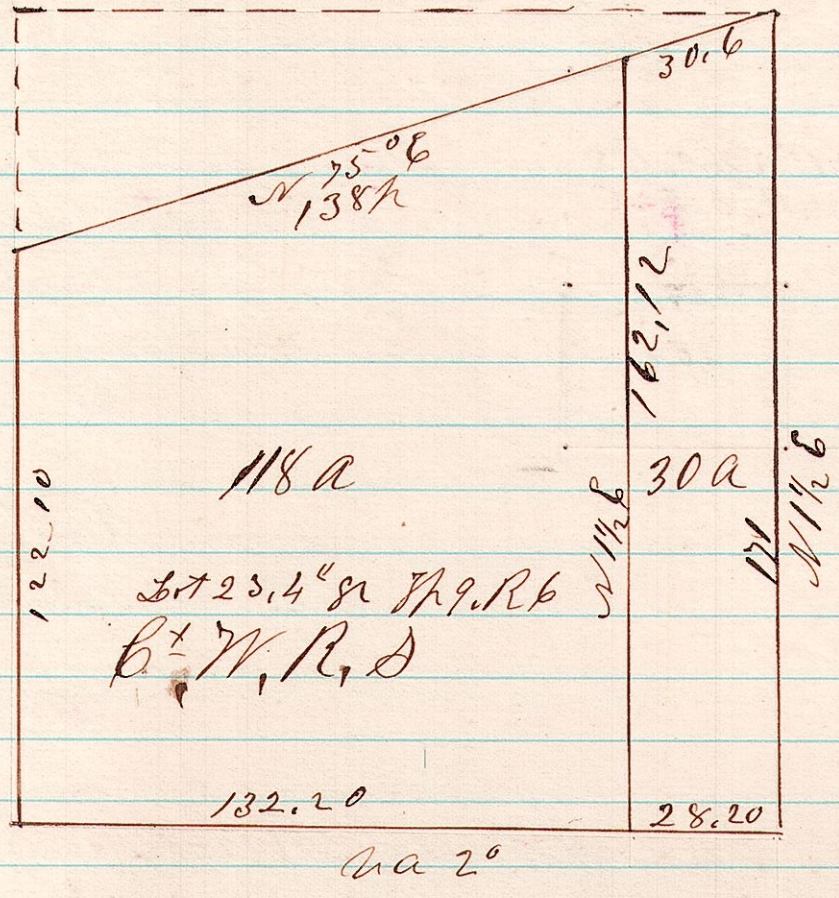

March 4th 1876

H. H. Robinson
Co Surveyor

7815 A Survey made for Roswell Chapman being part of the west part of the north east quarter of Sec 15. Tp 8. of Range 7.

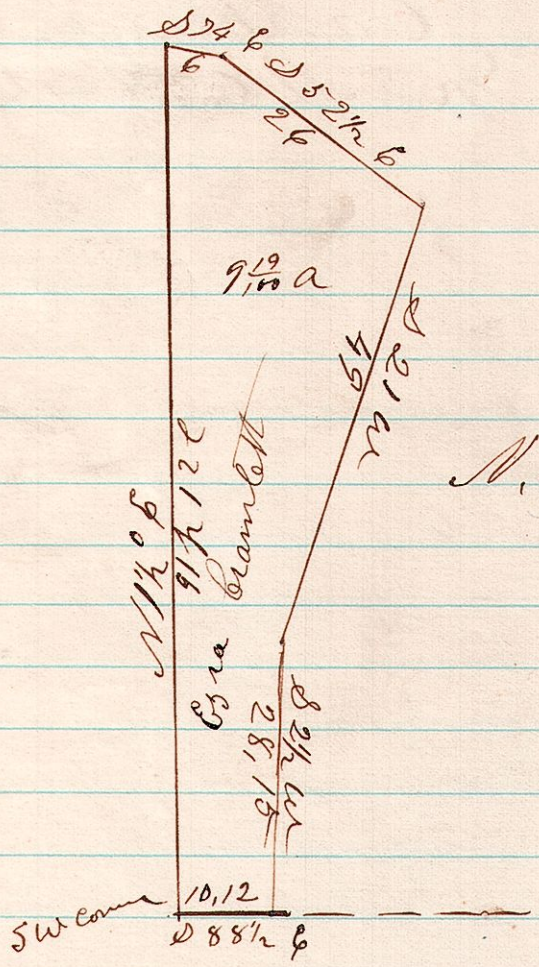

March 6th 1876

H. H. Robinson
Co Surveyor